
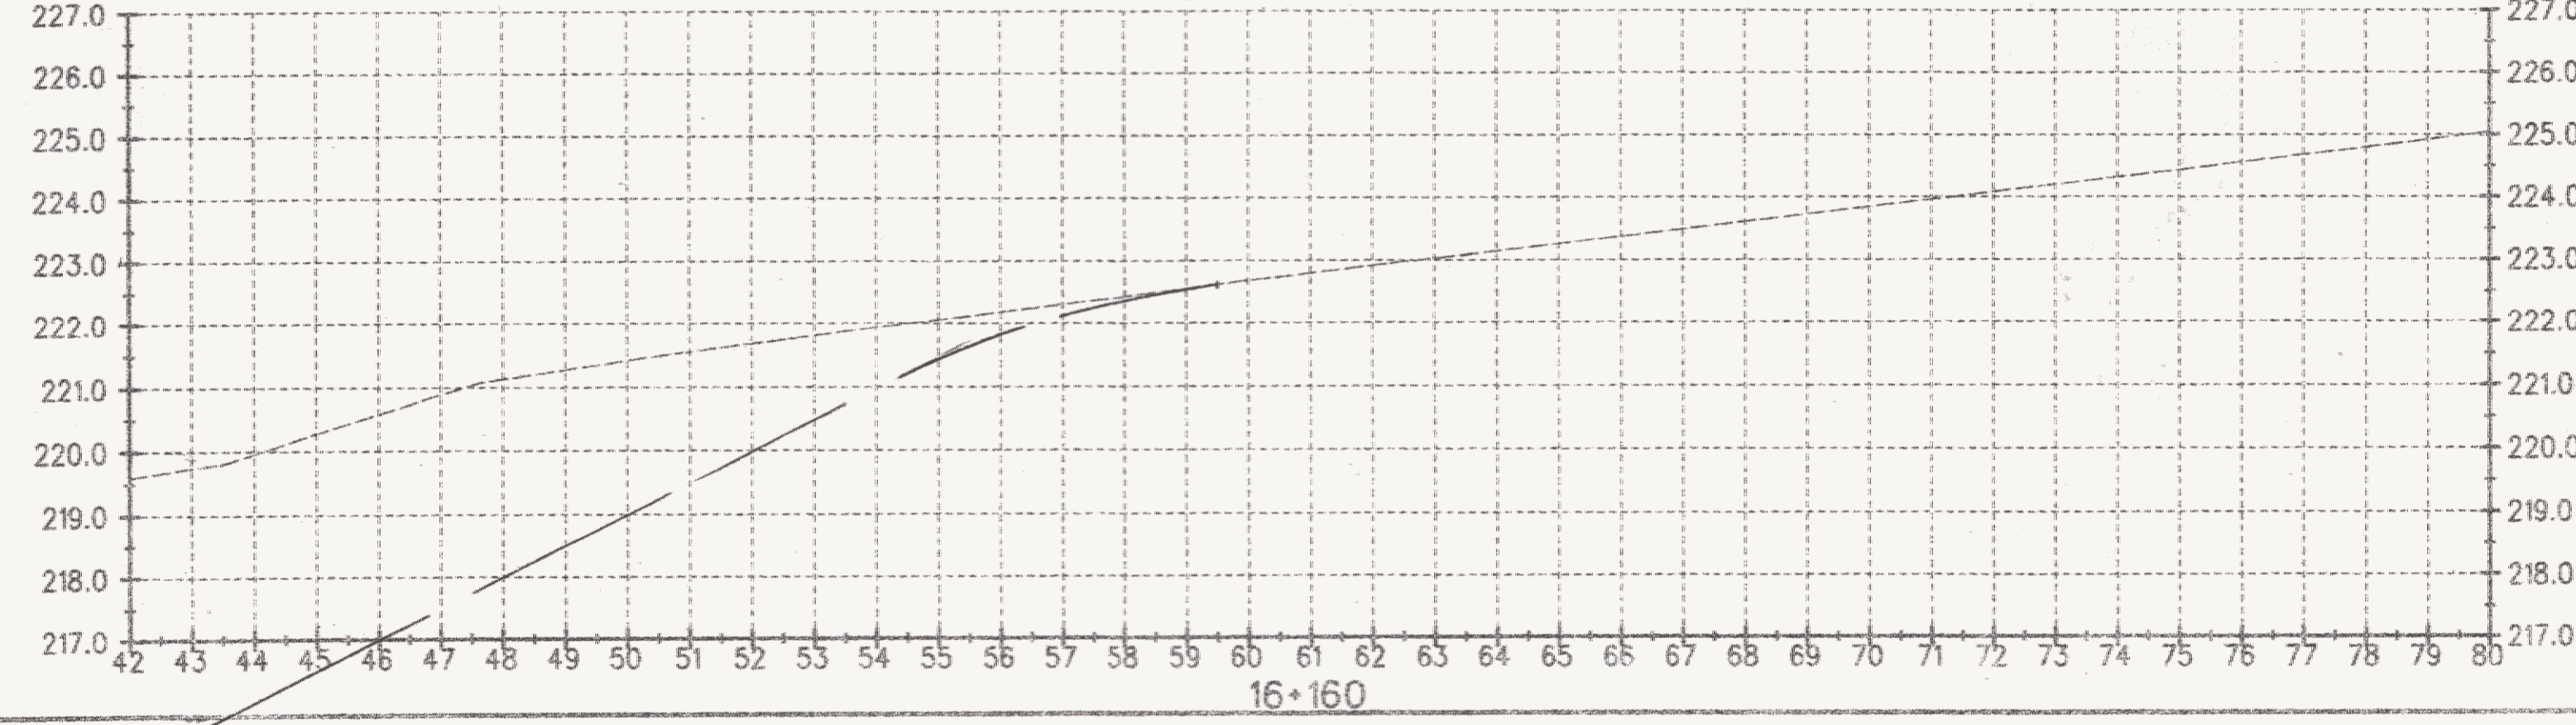


C=24 23.62
 F=46 43.12
 R=0 3.83

O.G. 1/14/03
 Rock 1/14/03
 Temp. 1/14/03
 FIG. 34985

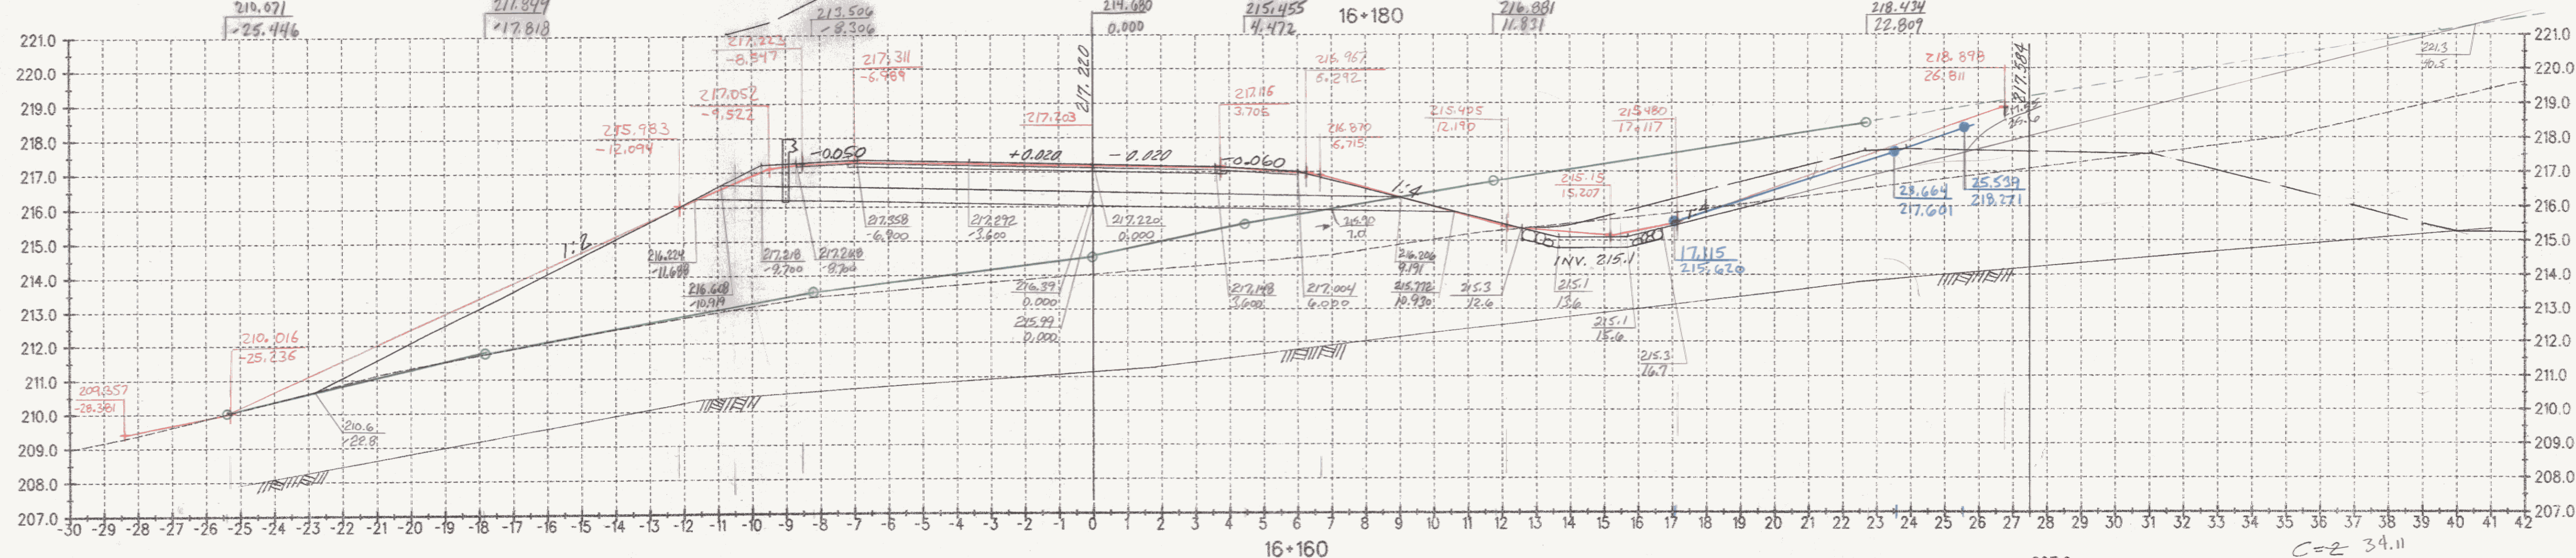

C=2 34.11
 F=66 48.33
 R=0 2.73

ALL DIMENSIONS IN MILLIMETERS
 EXCEPT AS INDICATED

H 1:100
 V 1:100

2 0 2 m

Metric

DATUM
 VERTICAL NAVD 88
 HORIZONTAL NAD 83 (1992)

SURVEYED BY	C.H.A. & V.S.E.	DATE	
DRAWN BY	J.S.L.	DATE	
SQUAD LEADER	T.P.K.		
DESIGN FILE NO.	N/A		
IPARM FILE		DATE PLOTTED	
PROJ. NAME	BENNINGTON - HOOSICK		
	D.P.I. 0146(1) C/3		
PROJ. NO.	P.I.N. 1306.60.201		
SHEET	442 OF 473 SHEETS		