



$C = 213$ 101.89
 $F = 45$ 54.14
 $R = 43$ 100.66
 AESTHETIC FILL = 104 91.56

O.G. 1/14/03
 Rock 1/16/03
 F.G. 2/3/03

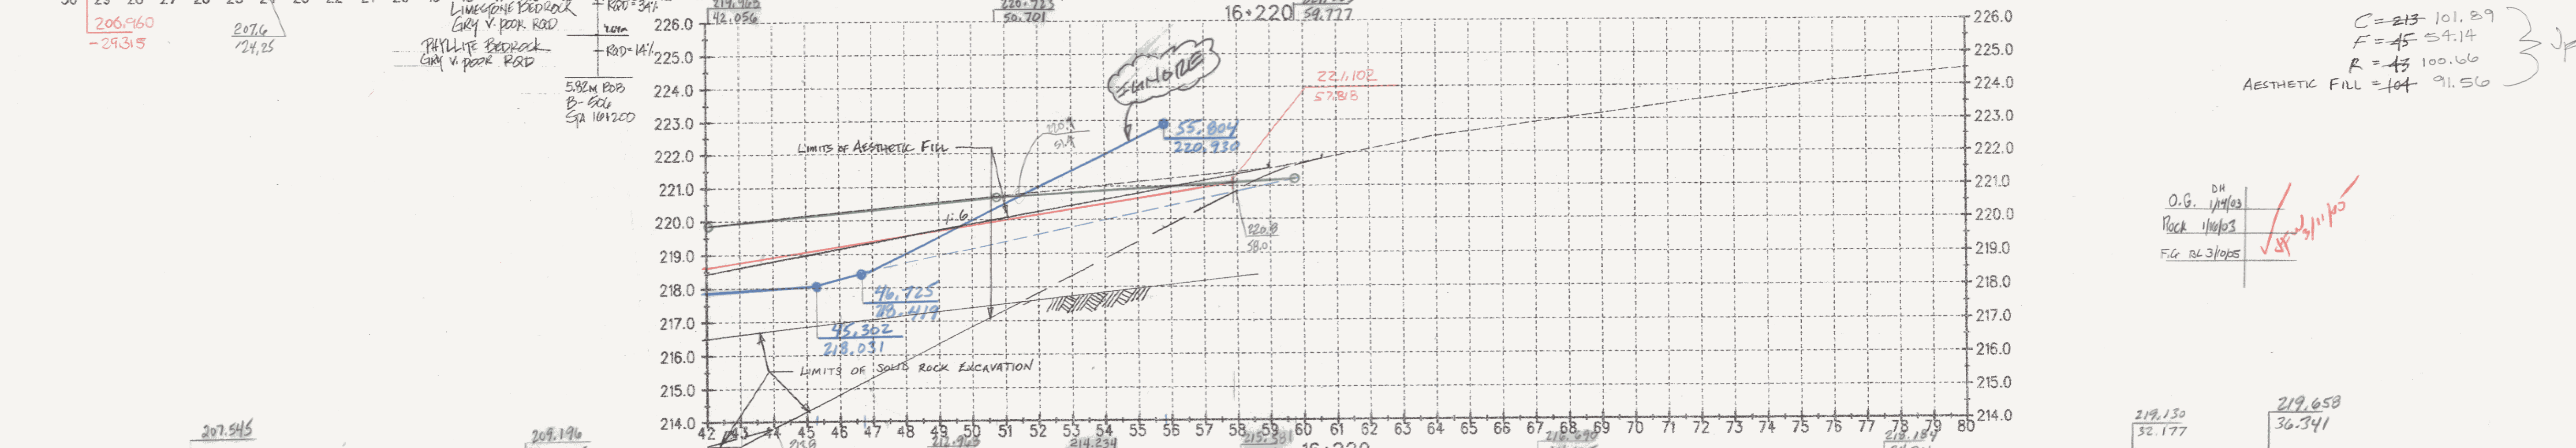

$C = 219$ 130.177
 $F = 219$ 658.341

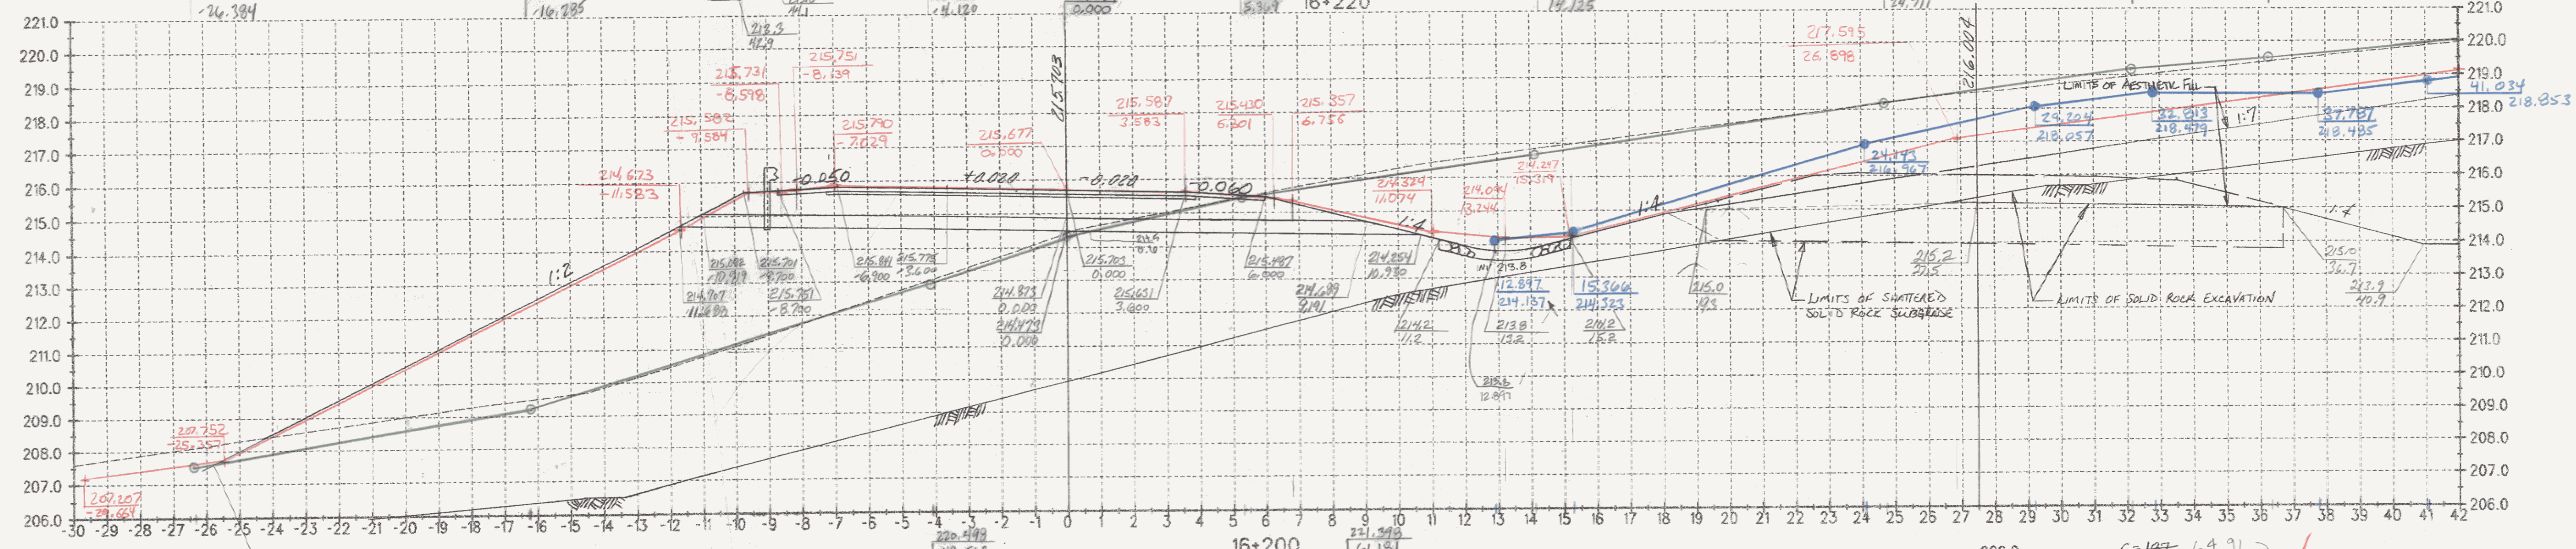

$C = 187$ 64.91
 $F = 55$ 57.24
 $R = 39$ 114.02
 AESTHETIC FILL = 93 76.89

ALL DIMENSIONS IN MILLIMETERS EXCEPT AS INDICATED
 2 0 2 m
 H 1:100
 V 1:100



DATUM
 VERTICAL NAVD 88
 HORIZONTAL NAD 83 (1992)

SURVEYED BY C.H.A. & V.S.E. DATE _____
 DRAWN BY J.S.L. DATE _____
 SQUAD LEADER T.P.K.
 DESIGN FILE NO. N/A
 IPARM FILE _____ DATE PLOTTED _____
 PROJ. NAME BENNINGTON - HOOSICK
 D.P.I. 0146(1) 4/3
 PROJ. NO. P.I.N. 1306.60.201
 SHEET 443 OF 473 SHEETS