


16+440

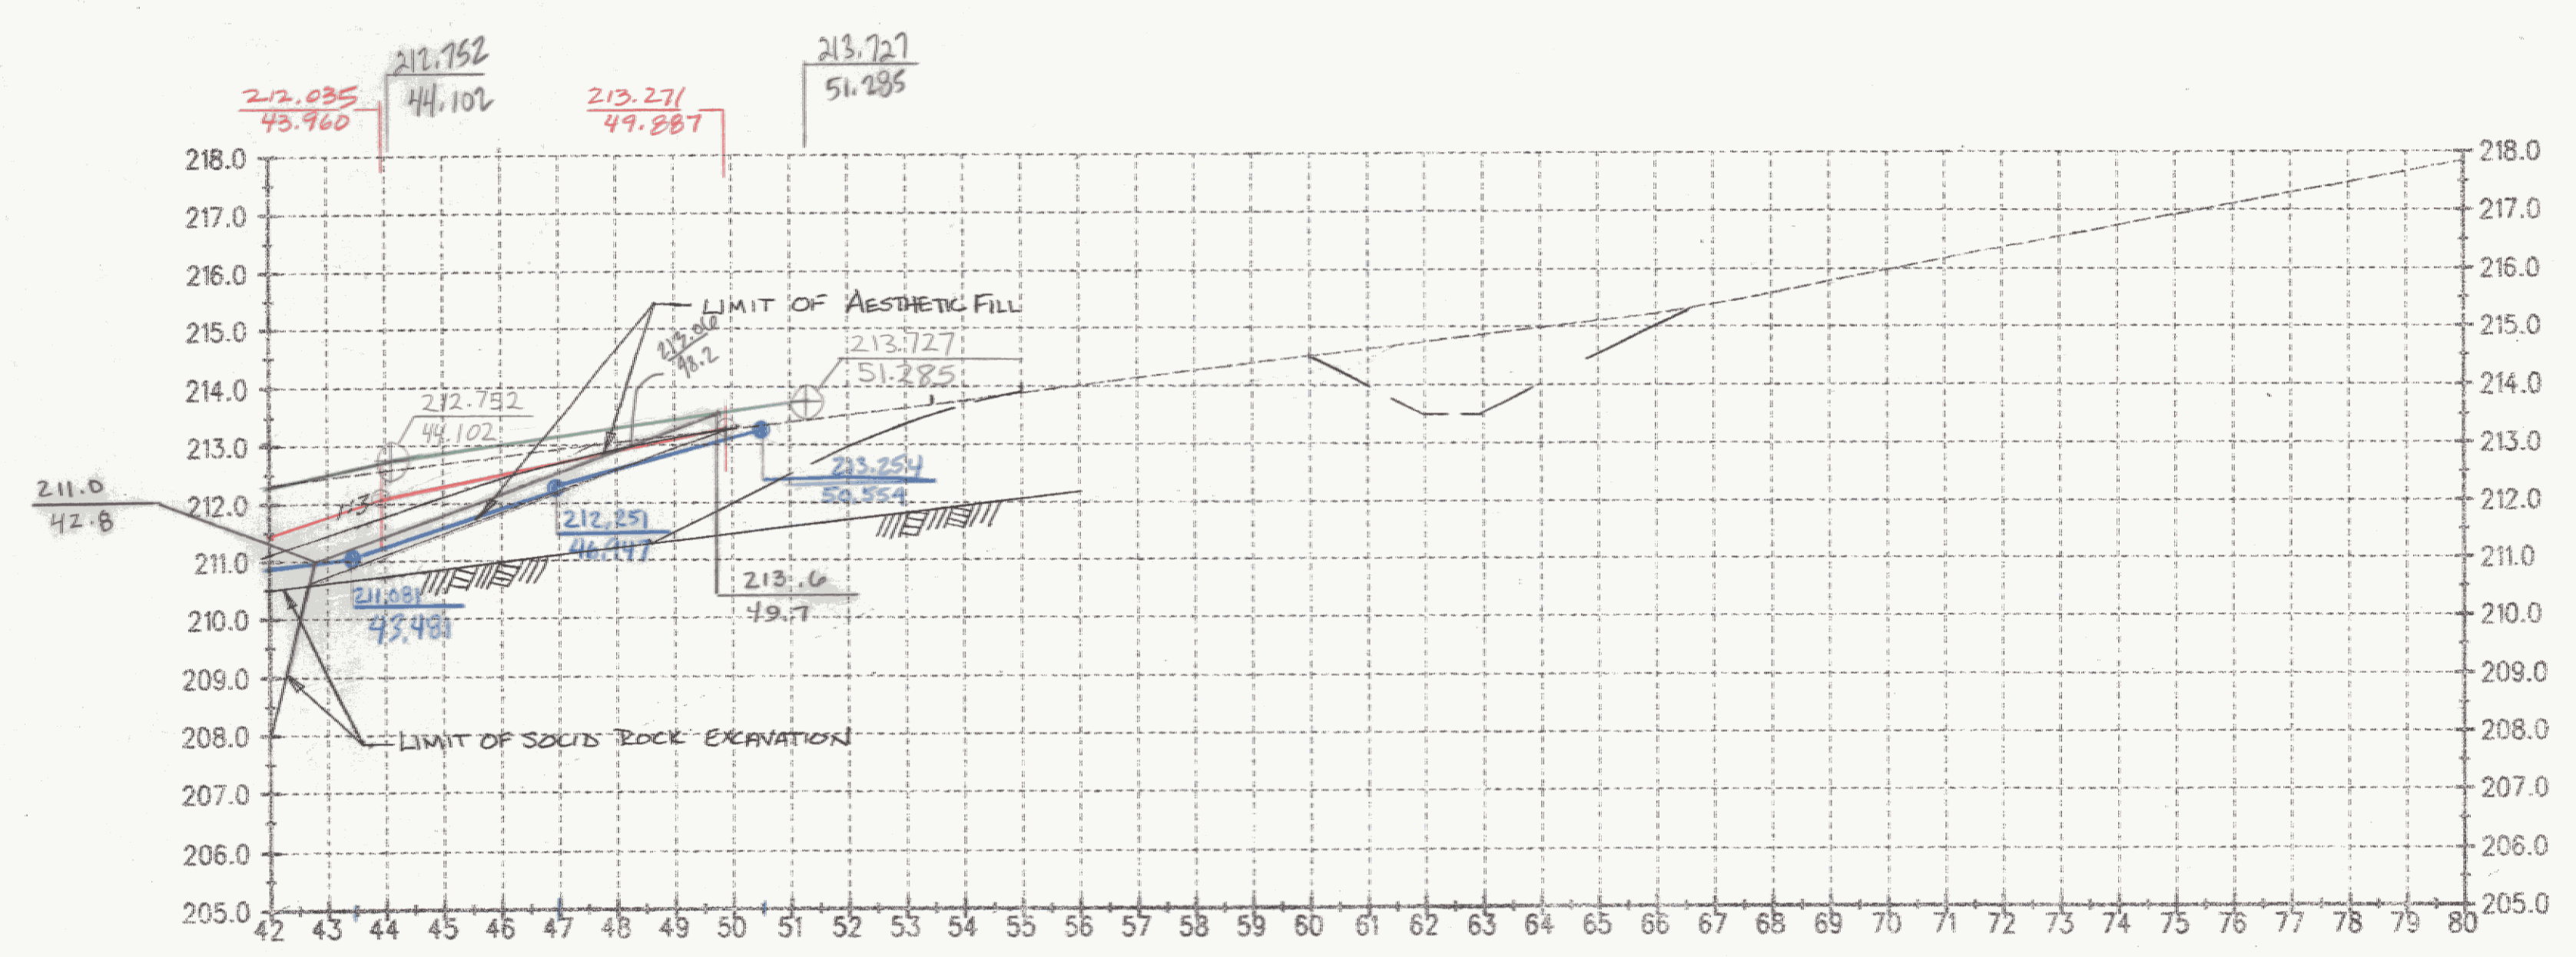

16+440

C = 174
 F = 50-46.88
 R = 88
 AESTHETIC FILL = 87 82.26

DATUM	
VERTICAL	NAVD 88
HORIZONTAL	NAD 83 (1992)

OG Plot BY: RD 10-31-02
 OG Check BY: DH 1-13-03
 SHOTS BY RRM 11/1/03
 FG. RMT 4/15/05

ALL DIMENSIONS IN MILLIMETERS EXCEPT AS INDICATED
 2 0 2 m
 H 1:100
 V 1:100

SURVEYED BY	C.H.A. & V.S.E.	DATE	
DRAWN BY	J.S.L.	DATE	
SQUAD LEADER	T.P.K.		
DESIGN FILE NO.	N/A		
IPARM FILE		DATE PLOTTED	
PROJ. NAME	BENNINGTON - HOOSICK		
	D.P.I. 0146(1) C/3		
PROJ. NO.	P.I.N. 1306.60.201	STA 16+440	
SHEET	492 OF 473 SHEETS		