


16+460

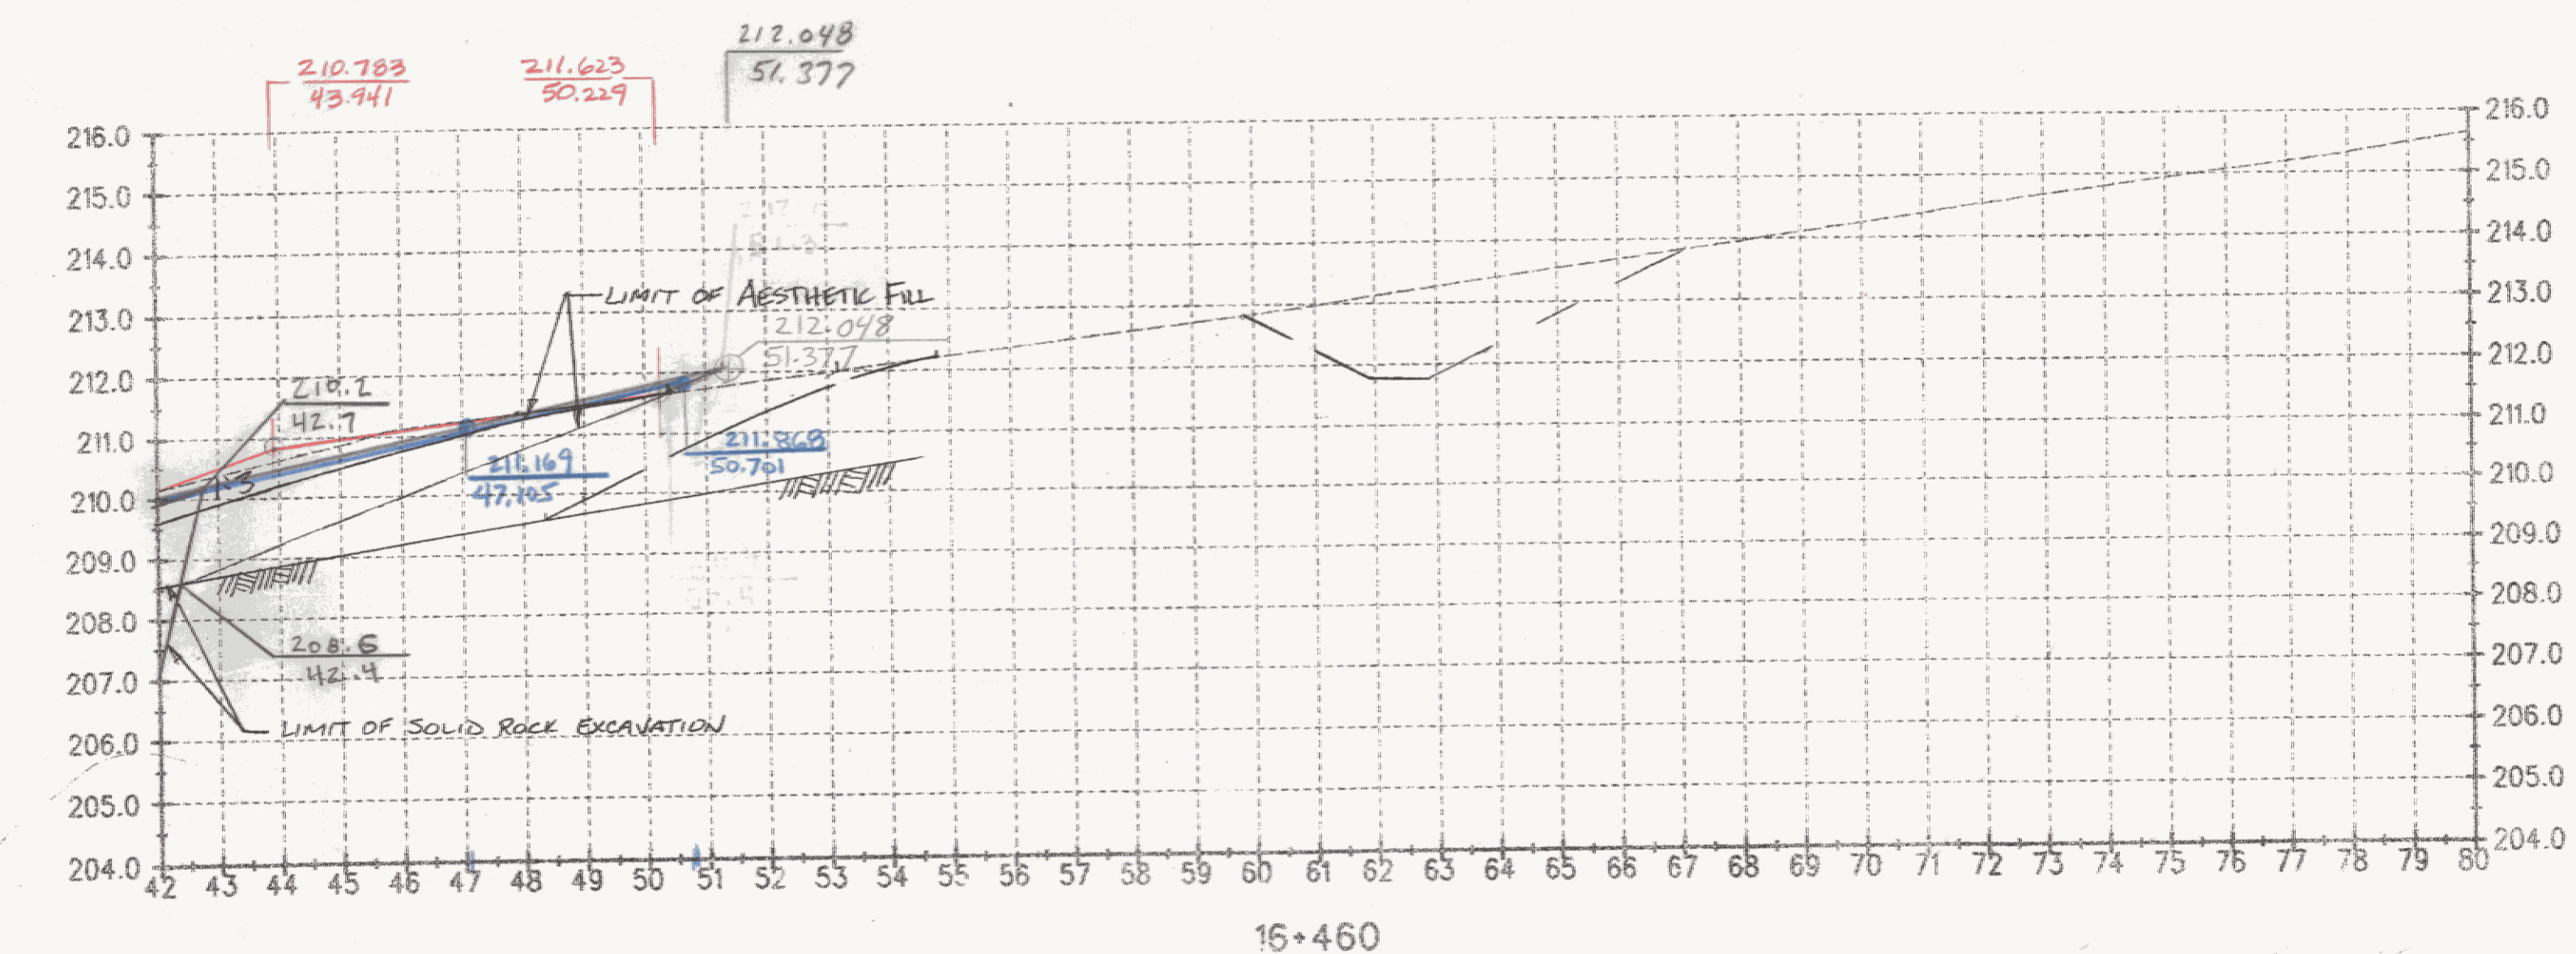


16+460

O.G. DH	1/18/03
Rock #	11/18/03
Test	
Shots RRM	11/31/03
FG. RMT	11/15/03

$C = 130$
 $F = 56 \text{ SB.15}$
 $R = 54 \text{ 100.89}$
 AESTHETIC FILL = 86 B4.31

DATUM	
VERTICAL	NAVD 88
HORIZONTAL	NAD 83 (1992)

OG Plot By: RD 10-31-02
Check By: JWS

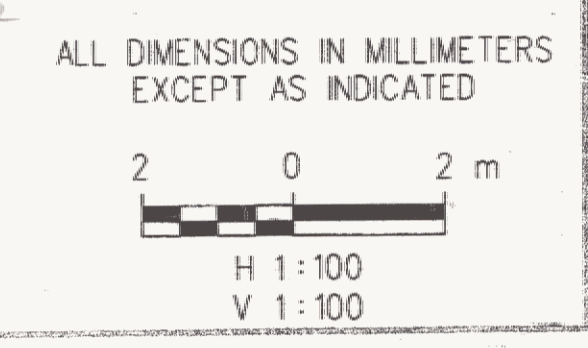

SURVEYED BY	C.H.A. & V.S.E.	DATE	
DRAWN BY	J.S.L.	DATE	
SQUAD LEADER	T.P.K.		
DESIGN FILE NO.	N/A		
IPARM FILE		DATE PLOTTED	
PROJ. NAME	BENNINGTON - HOOSICK		
	D.P.I. 0146(1) c/3		
PROJ. NO.	P.I.N. 1306.60.201	STA	16+460
SHEET	433 OF 473 SHEETS		