
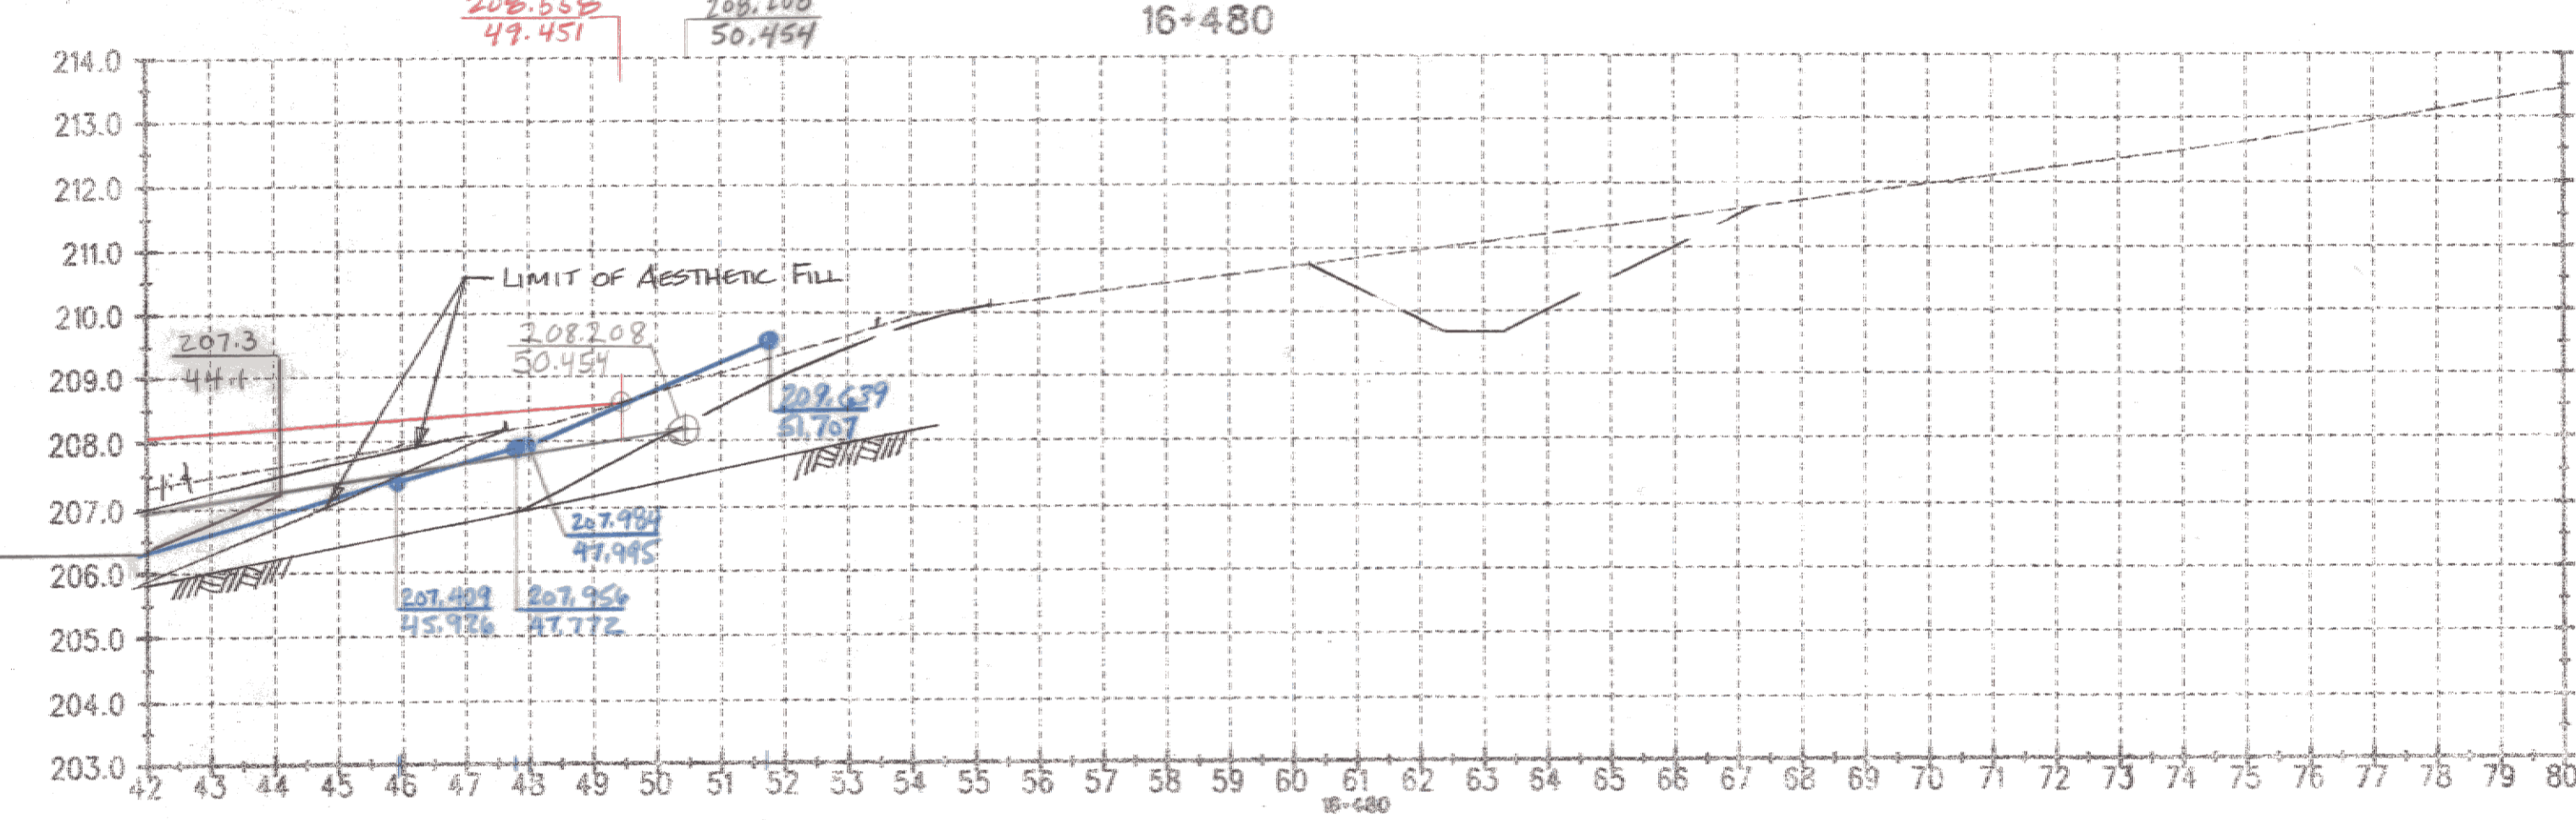



C = 94 10.48
F = 100 108.04
R = 38 67.25
AESTHETIC FILL = 84 75.26

D.G. P. 11/13/03
R.R.M. 11/31/03
BY R.R.M. 11/31/03
FG. 415105

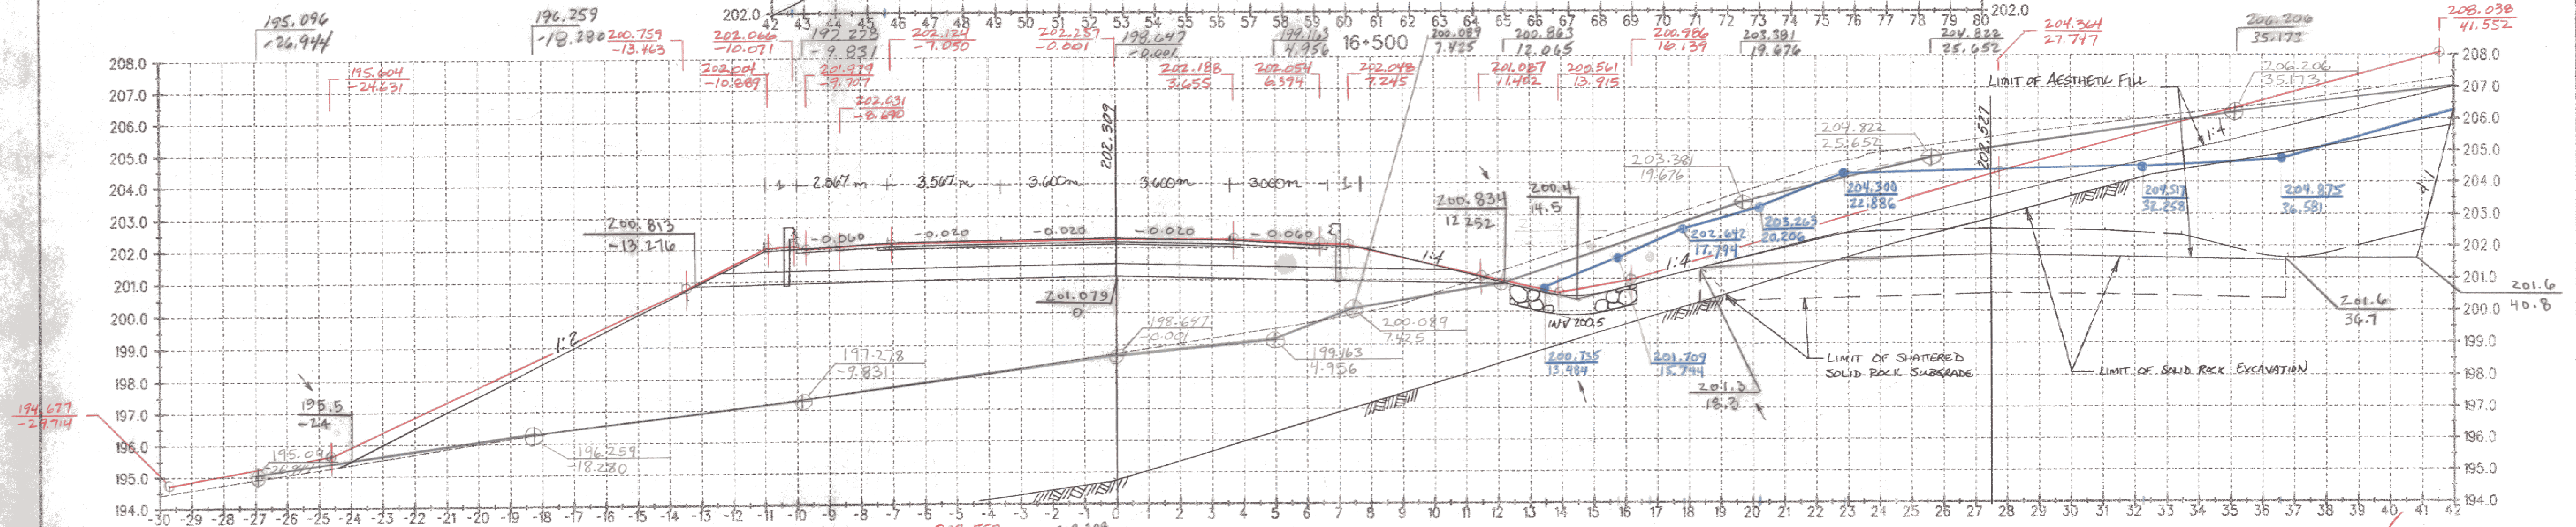

C = 108 21.76
F = 77 79.53
R = 42 74.59
AESTHETIC FILL = 63 58.68

JFW 2/11/03
ALL DIMENSIONS IN MILLIMETERS EXCEPT AS INDICATED

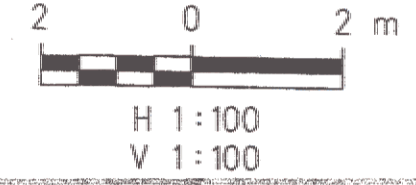

Metric

DATUM
VERTICAL NAVD 88
HORIZONTAL NAD 83 (1992)

OG Plot By: RD 10-31-02
Check By: RRM 11/31/03
FG. 415105

SURVEYED BY C.H.A. & V.S.E. DATE
DRAWN BY J.S.L. DATE
SQUAD LEADER T.P.K.
DESIGN FILE NO. N/A
IPARM FILE DATE PLOTTED
PROJ. NAME BENNINGTON - HOOSICK D.P.I. 0146(1) C13
PROJ. NO. P.I.N. 1306.60.201 STA 164.500
SHEET 454 OF 473 SHEETS