
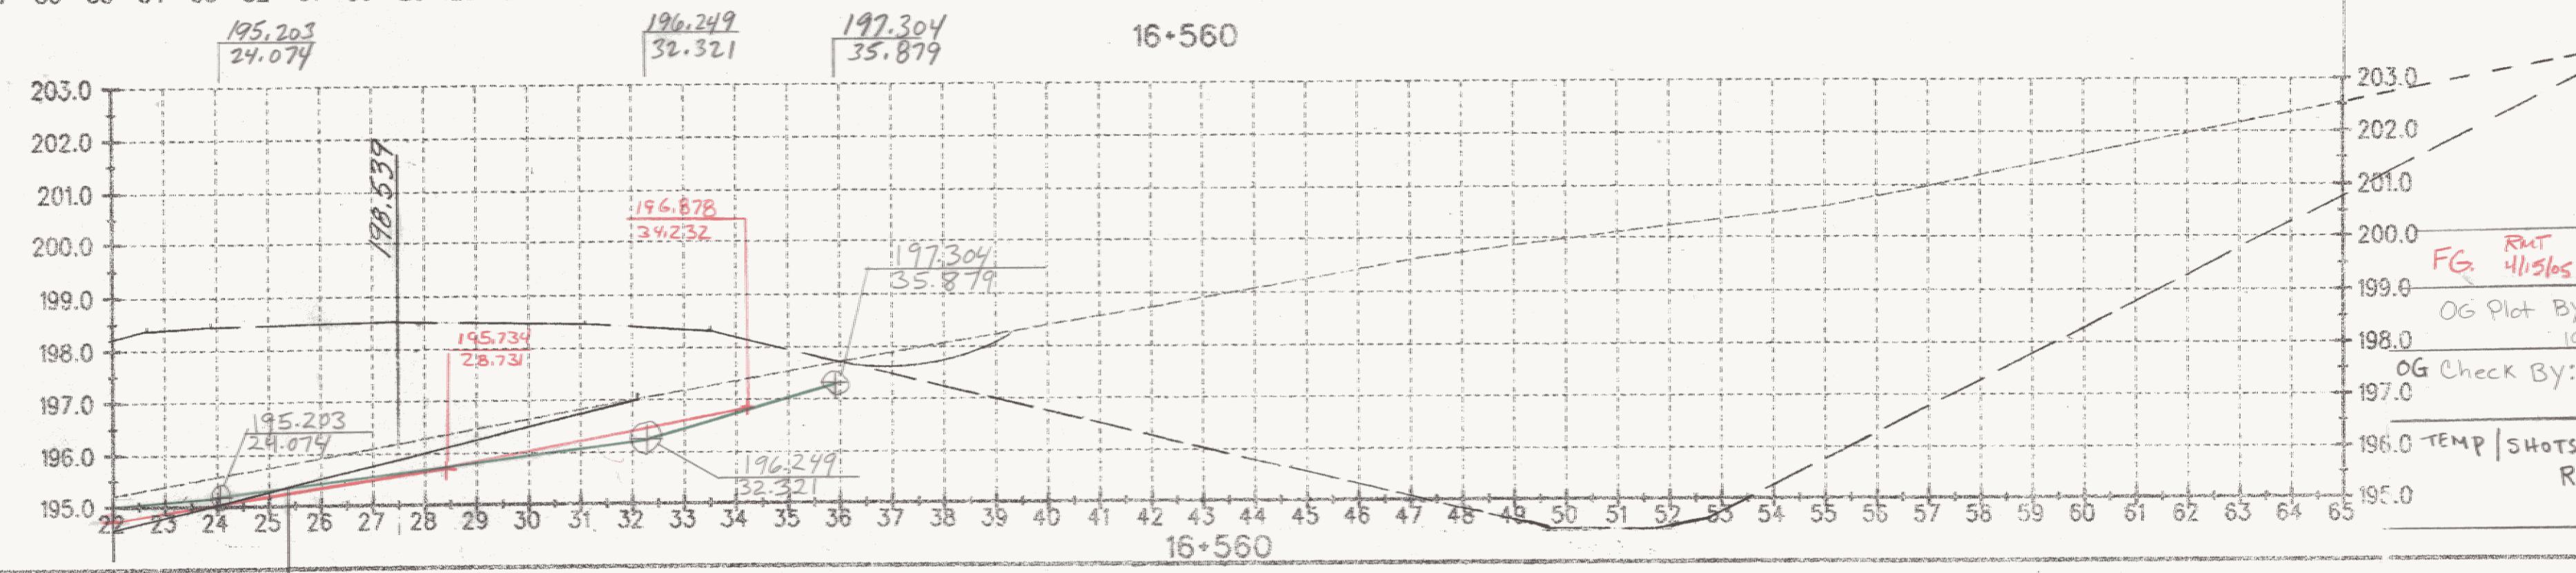


$C = 0.623$
 $F = 240 \text{ } 231.21$
 $R = 0$

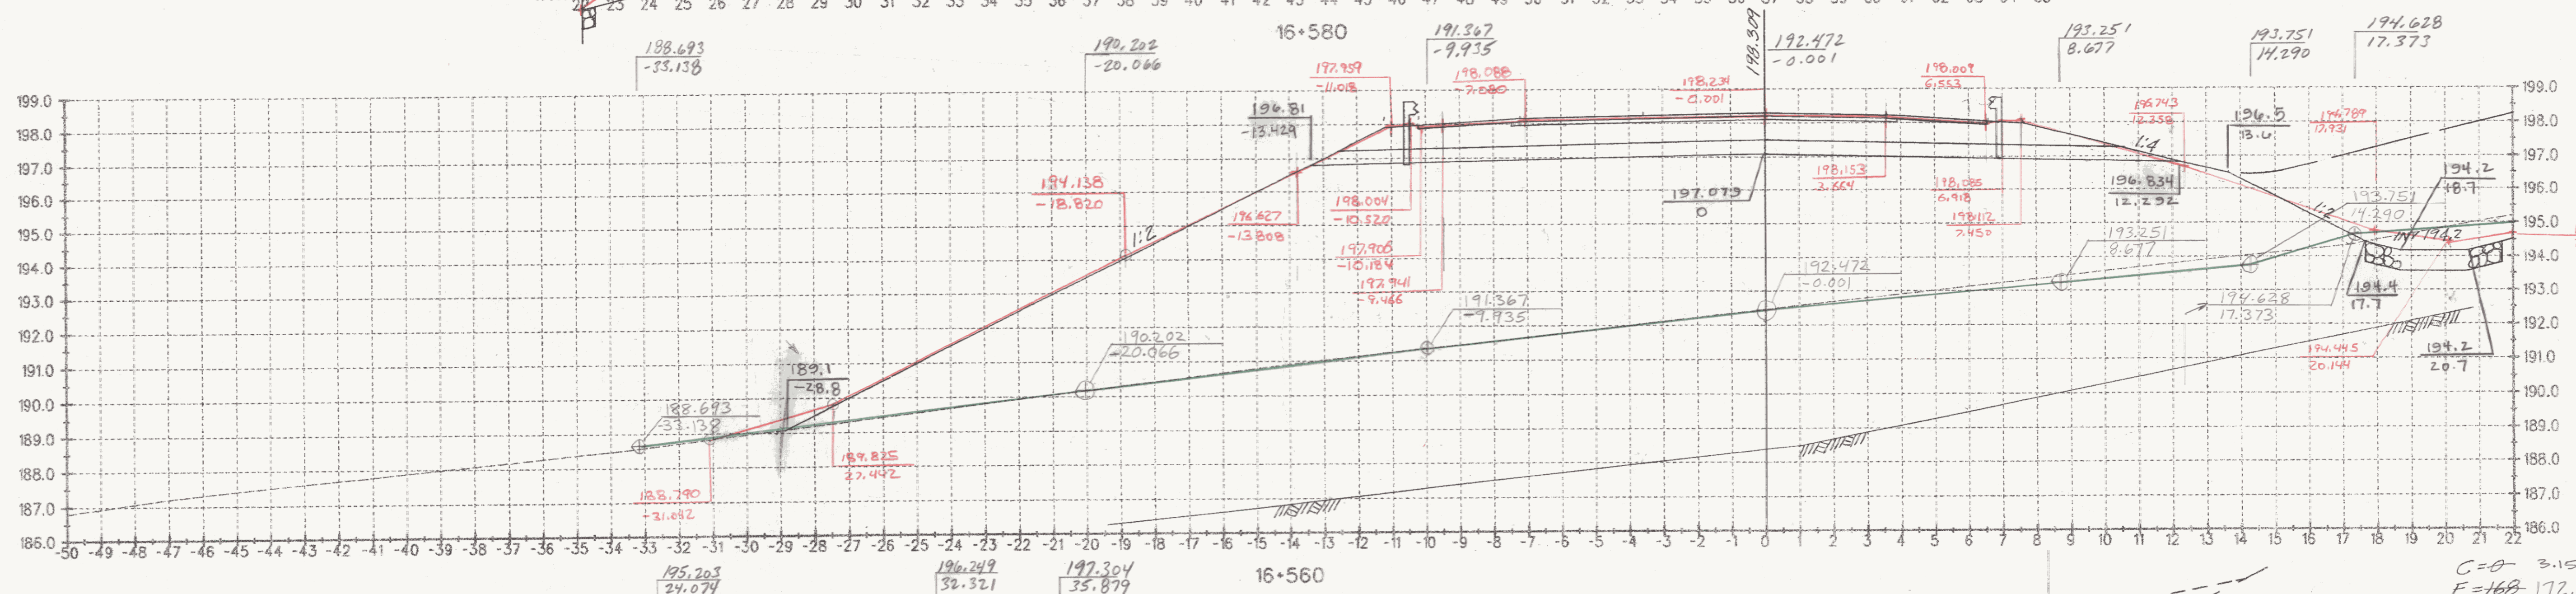

$C = 0.315$
 $F = 168 \text{ } 172.53$
 $R = 0$

ALL DIMENSIONS IN MILLIMETERS
 EXCEPT AS INDICATED
 2 0 2 m
 H 1:100
 V 1:100

DATUM	
VERTICAL	NAVD 1988
HORIZONTAL	N/A

SURVEYED BY C.H.A. & V.S.E. DATE _____
 DRAWN BY J.S.L. DATE _____
 SQUAD LEADER T.P.K. _____
 DESIGN FILE NO. N/A _____
 IPARM FILE _____ DATE PLOTTED _____
 PROJ. NAME BENNINGTON - HOOSICK
 D.P.I. 0146(1) C/3
 PROJ. NO. P.I.N. 1306.60.201
 SHEET 456 OF 473 SHEETS

JFW 2/12/03

JFW 11/8/05