



*1:10  
2000*

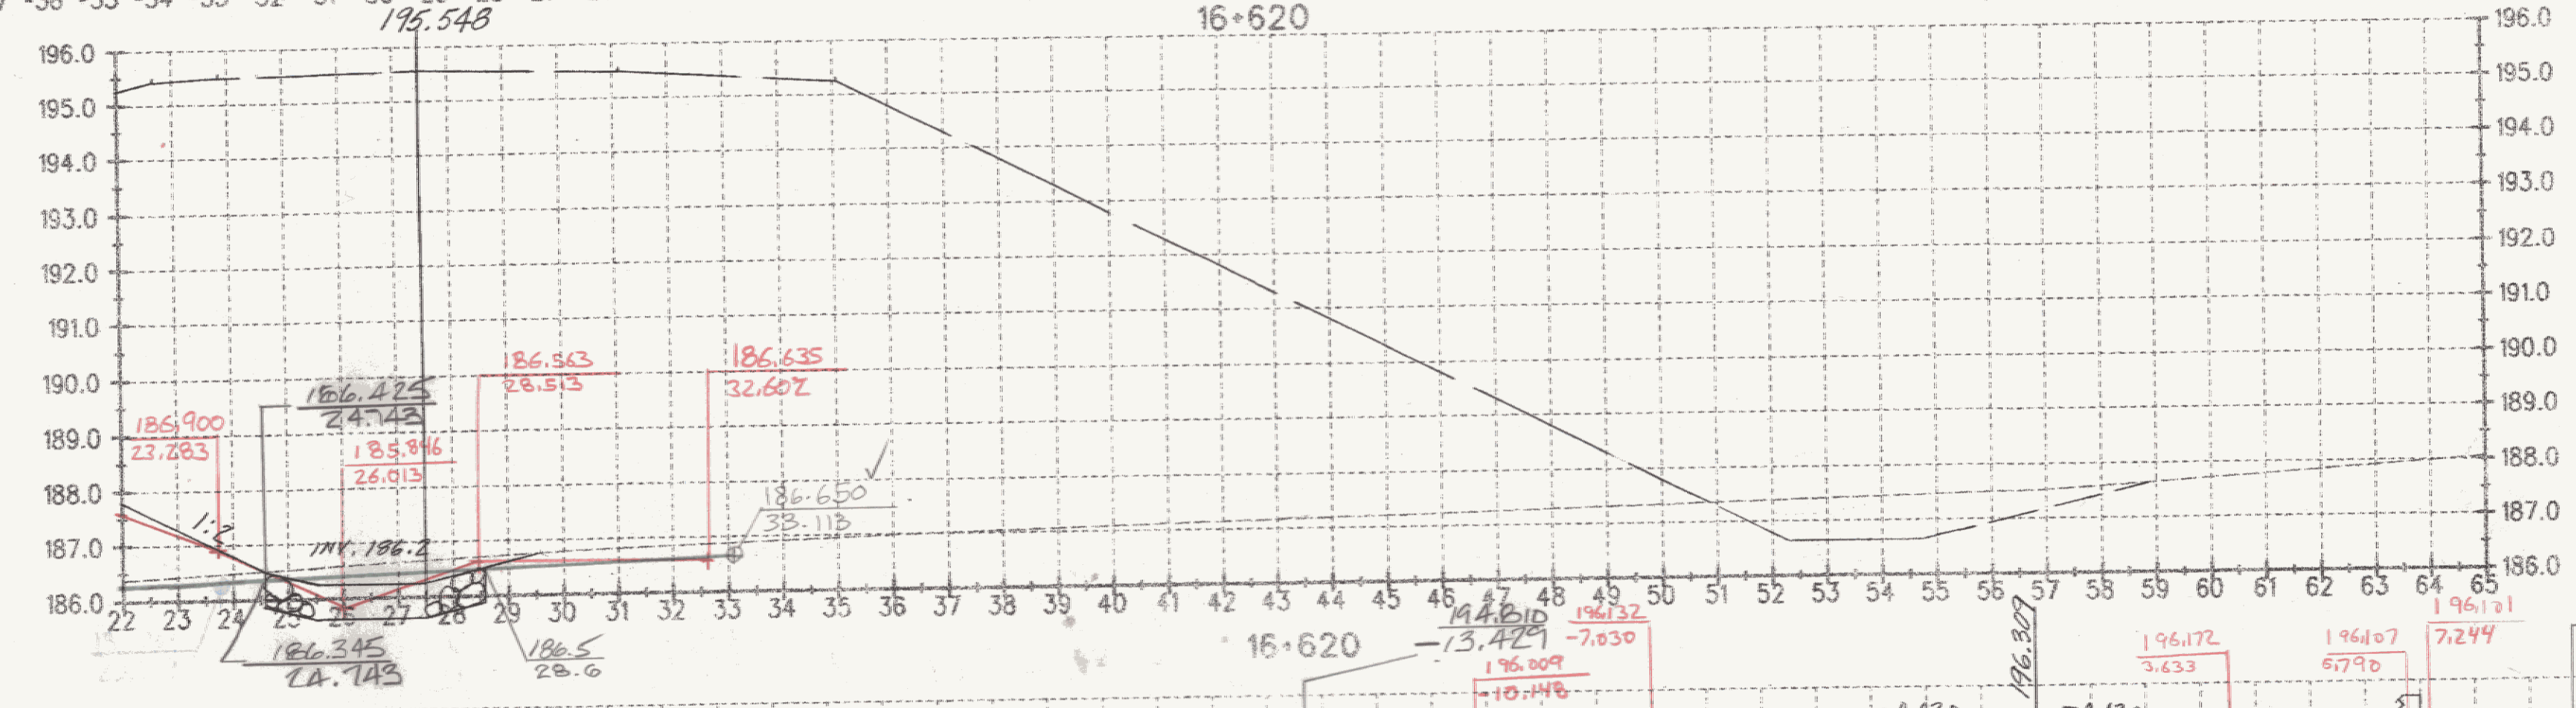

$C=0$   
 $F=348 \approx 341.92$  Jpw 2/12/03  
 $R=0$

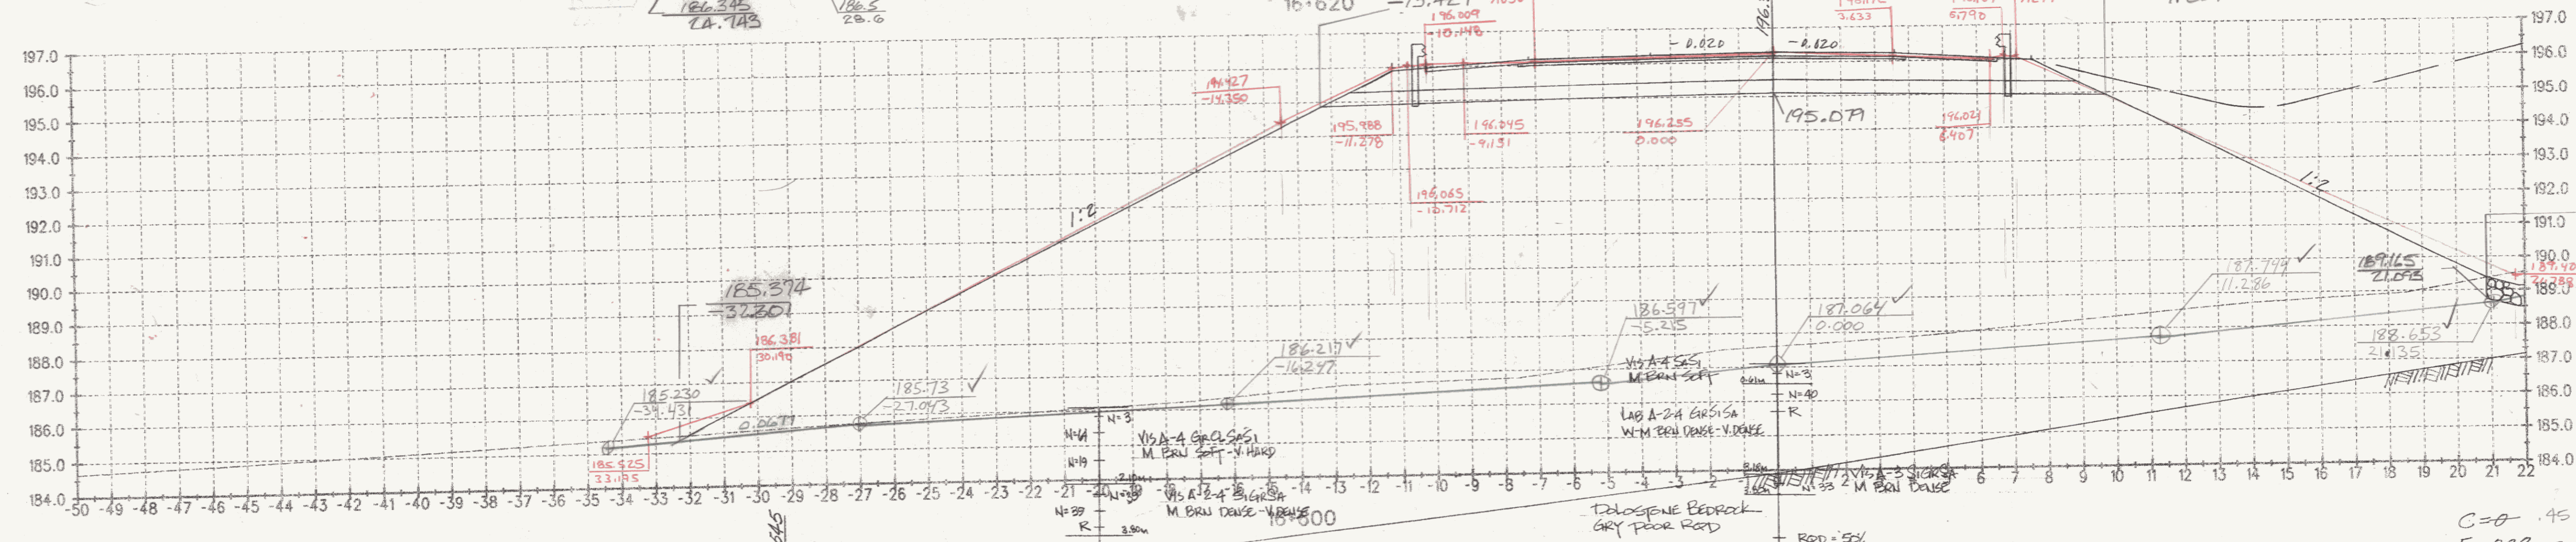

*NOTE: DITCH NET DRAWN IN CORRECT LOCATION*

$C=0.45$   
 $F=298 \approx 310.06$  Jpw 2/12/03  
 $R=0$

ALL DIMENSIONS IN MILLIMETERS EXCEPT AS INDICATED  
 2 0 2 m  
 H 1:100  
 V 1:100

**Metric**  
 DATUM: NAVD 1988  
 VERTICAL: N/A  
 HORIZONTAL: N/A

SURVEYED BY	C.H.A. & V.S.E.	DATE	
DRAWN BY	J.S.L.	DATE	
SQUAD LEADER	T.P.K.		
DESIGN FILE NO.	N/A		
IPARM FILE		DATE PLOTTED	
PROJ. NAME	BENNINGTON - HOOSICK D.P.I. 0146(1) C/3		
PROJ. NO.	P.I.N. 1306.60.201	STA	16+120
SHEET 457 OF 473 SHEETS			

OG Plot By: RD 10/8/02  
 Check By: Jpw