

C=0
 F=70 69.48
 R=0
 Jpw 2/12/03

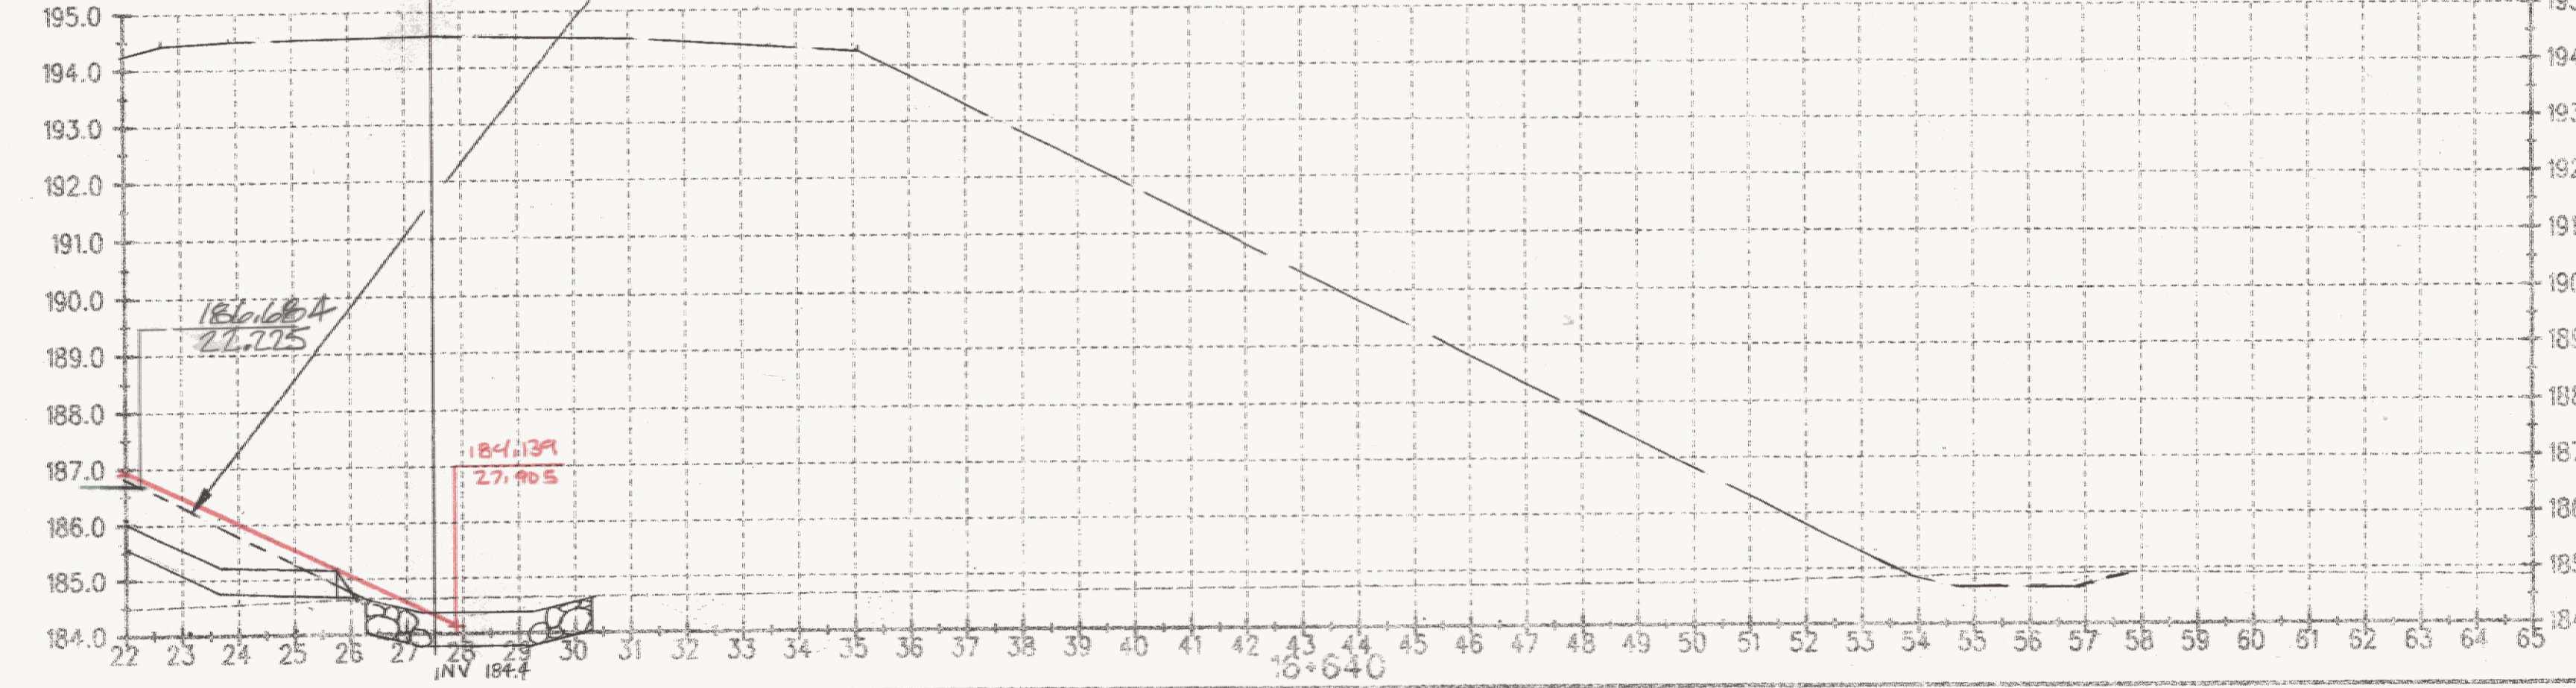
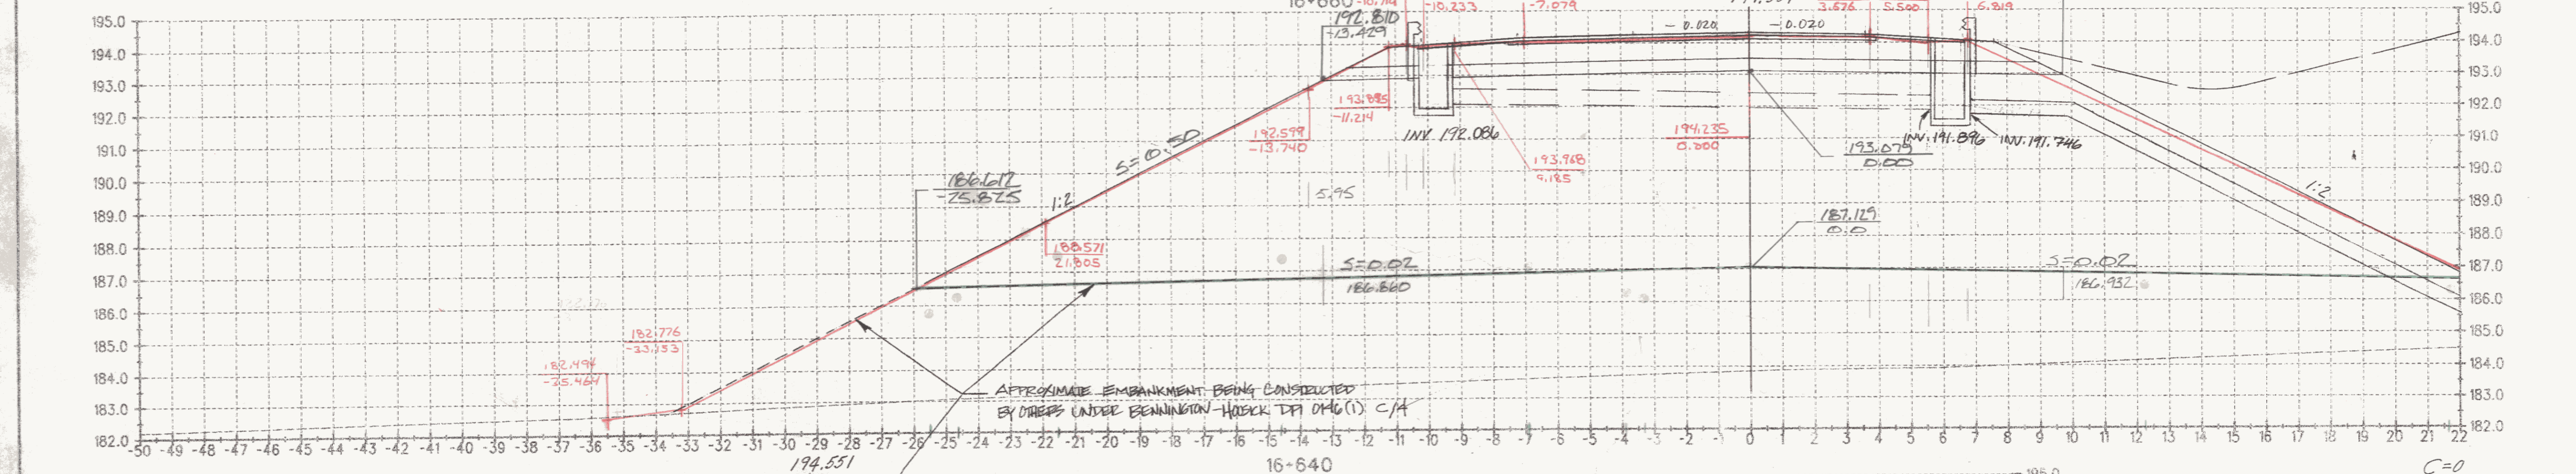


FIG 5/9/05
 C=0
 F=210 212.14
 R=0
 ALL DIMENSIONS IN MILLIMETERS EXCEPT AS INDICATED
 H 1:100
 V 1:100
 Jpw 2/12/03

Metric

DATUM
 VERTICAL NAVD 1988
 HORIZONTAL N/A

SURVEYED BY	C.H.A. & V.S.E.	DATE	
DRAWN BY	J.S.L.	DATE	
SQUAD LEADER	T.P.K.		
DESIGN FILE NO.	N/A		
IPARM		DATE	
FILE		PLOTTED	
PROJ. NAME	BENNINGTON - HOOSICK		
PROJ. NO.	D.P.I. 0146(1) C/3		
	P.I.N. 1306.60.201		
SHEET	458 OF 473 SHEETS		