


ABW 1+096  
AIRPORT BROOK WEST

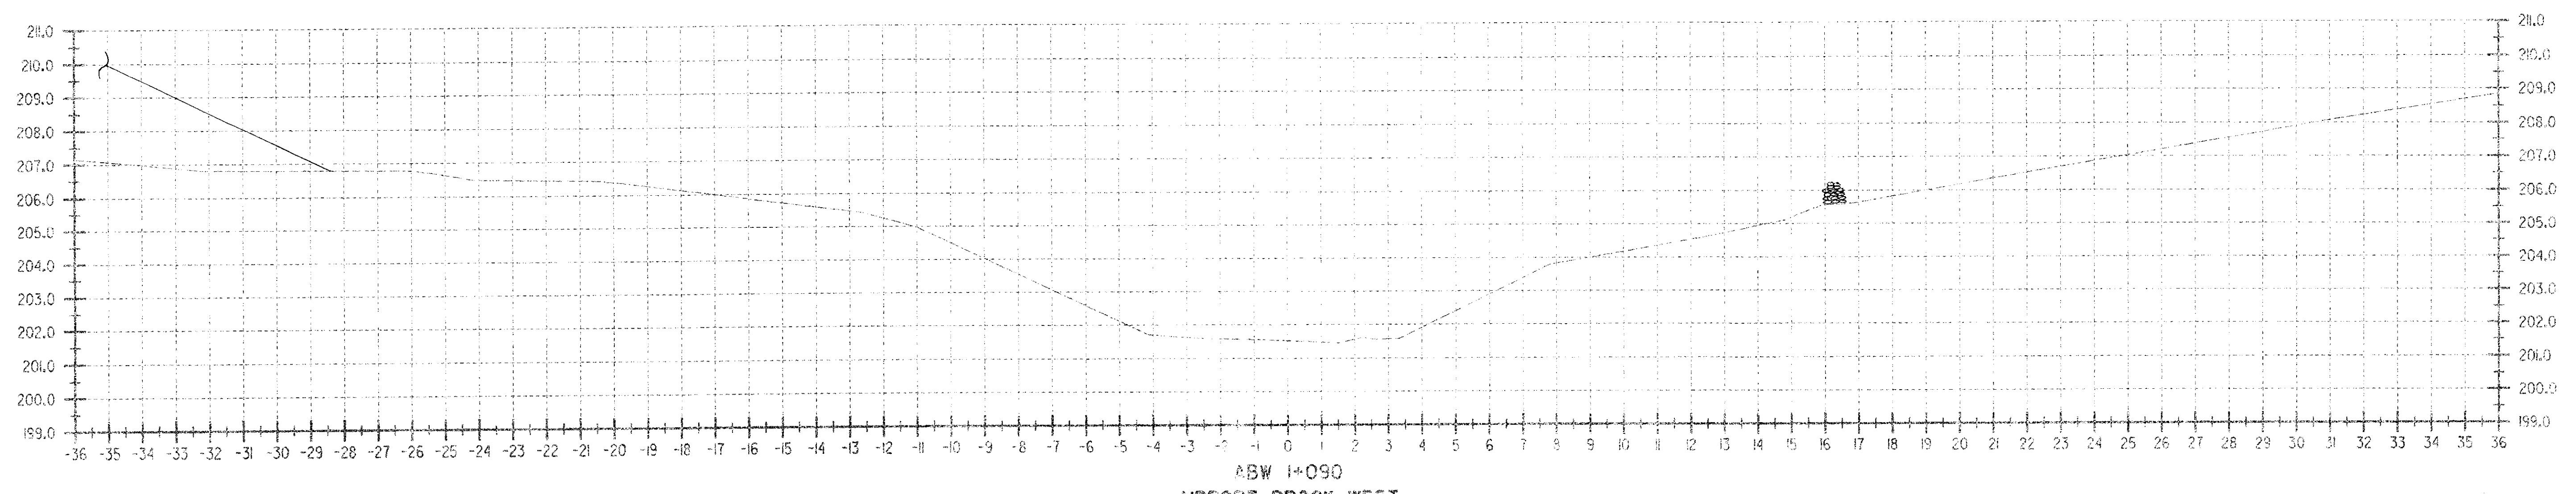

ABW 1+090  
AIRPORT BROOK WEST

DATUM  
 VERTICAL NAVD 88  
 HORIZONTAL NAD 83 (1992)

ALL DIMENSIONS IN MILLIMETERS  
 EXCEPT AS INDICATED  
 2 0 2 m  
 H 1:100  
 V 1:100

SURVEYED BY C.H.A. & V.S.E. DATE 12/93  
 DRAWN BY J.S.L. DATE 6/98  
 SQUAD LEADER T.P.K.  
 DESIGN FILE NO. /516/YAOT/VISECTS.D  
 I/PARM \_\_\_\_\_ DATE PLOTTED \_\_\_\_\_  
 FILE \_\_\_\_\_  
 PROJ. NAME BENNINGTON - HOOSICK  
D.P.J. 01450 015  
 PROJ. NO. P.I.N. 1306.60  
 SHEET 168 OF 173 SHEETS