


LEFT  
NET C = 0  
NET F = 31

RIGHT  
NET C = 4  
NET F = 234

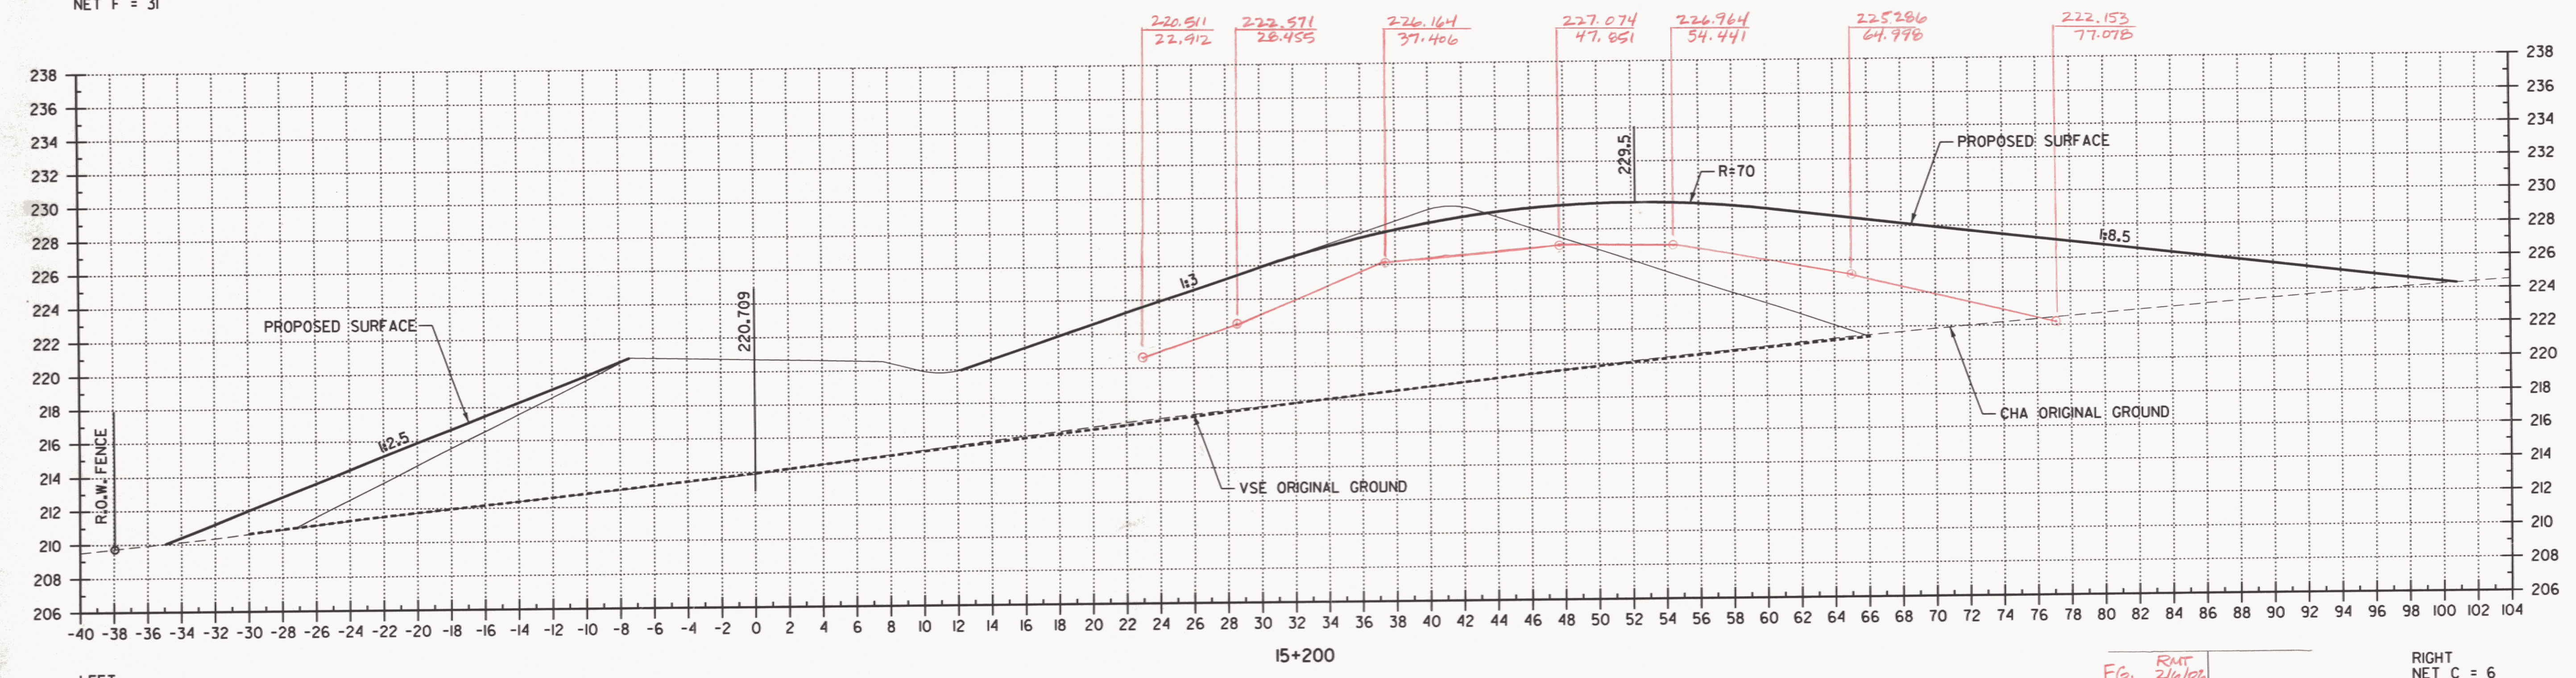

LEFT  
NET C = 0  
NET F = 29

RIGHT  
NET C = 6  
NET F = 209

FG. RMT  
2/6/03

FILE NAME = \\5116\VAOT\CONTRACT3\XSECT01.DGN  
DATE/TIME = 01/21/03  
USER = 1459

DATUM  
VERTICAL NAVD 88  
HORIZONTAL NAD 83 (1992)

ALL DIMENSIONS IN METERS  
EXCEPT AS INDICATED  
4 0 4 m  
H 1: 200  
V 1: 200

**REVISED  
CROSS  
SECTIONS**

SURVEYED BY C.H. & V.S.E. DATE 12/93  
DRAWN BY J.S.L. DATE 1/03  
SQUAD LEADER T.P.K.  
DESIGN FILE NO. XSECT01.DGN  
IPARM \_\_\_\_\_ DATE PLOTTED 1/03  
PROJ. NAME BENNINGTON - HOOSICK  
D.P.I. 0146(II) C/3  
PROJ. NO. P.I.N. 1306.60  
SHEET 2 OF 8 SHEETS 478