


LEFT
NET C = 0
NET F = 31

RIGHT
NET C = 23
NET F = 235

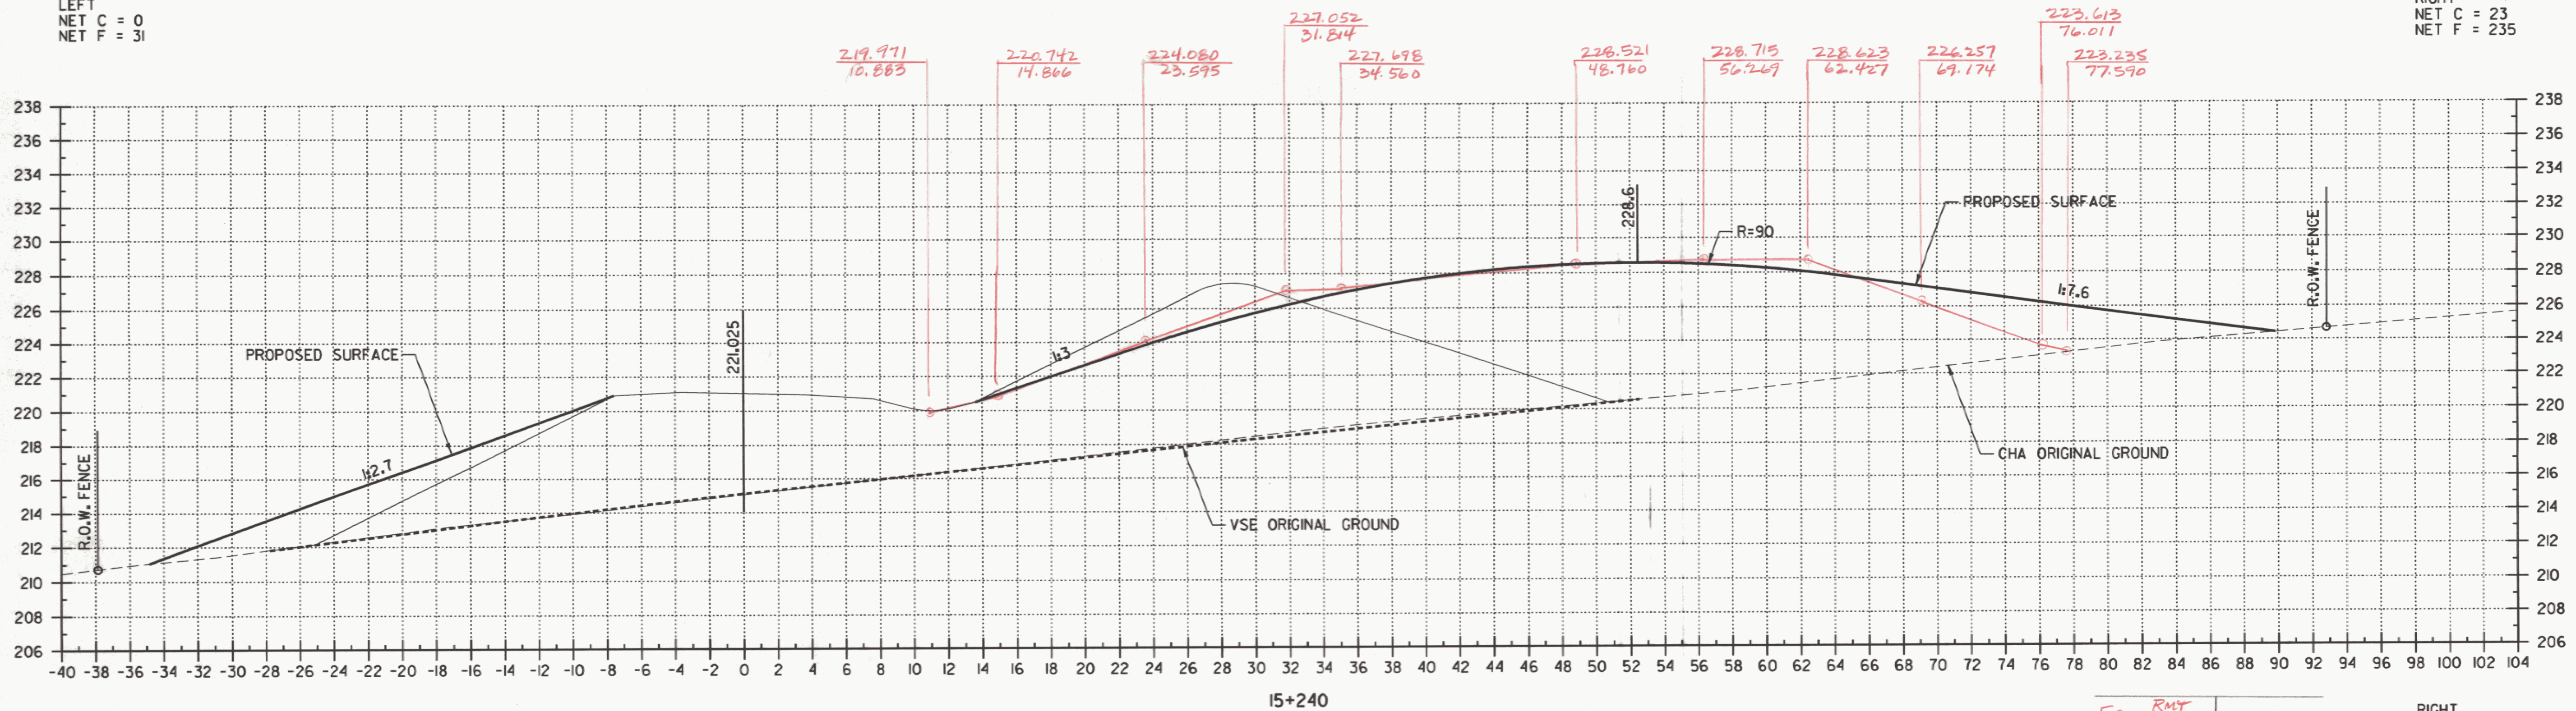

LEFT
NET C = 0
NET F = 34

RIGHT
NET C = 23
NET F = 256

FG RMT
21606

FILE NAME F:\51615\VAOT\CONTRACT3\XSECT01.DGN
DATE/TIME = 01/21/03
USER = 2068

DATUM	
VERTICAL	NAVD 88
HORIZONTAL	NAD 83 (0992)

ALL DIMENSIONS IN METERS
EXCEPT AS INDICATED

H 1:200
V 1:200

**REVISED
CROSS
SECTIONS**

SURVEYED BY C.H. & V.S.E. DATE 12/93
DRAWN BY J.S.L. DATE 1/03
SQUAD LEADER T.P.K.
DESIGN FILE NO. XSECT01.DGN
IPARM FILE DATE PLOTTED 1/03
PROJ. NAME BENNINGTON - HOOSICK
D.P.I. 0146(1) C/3
PROJ. NO. P.I.N. 1306.60
SHEET 3 OF 8 SHEETS 479