


LEFT
NET C = 0
NET F = 34

RIGHT
NET C = 22
NET F = 252

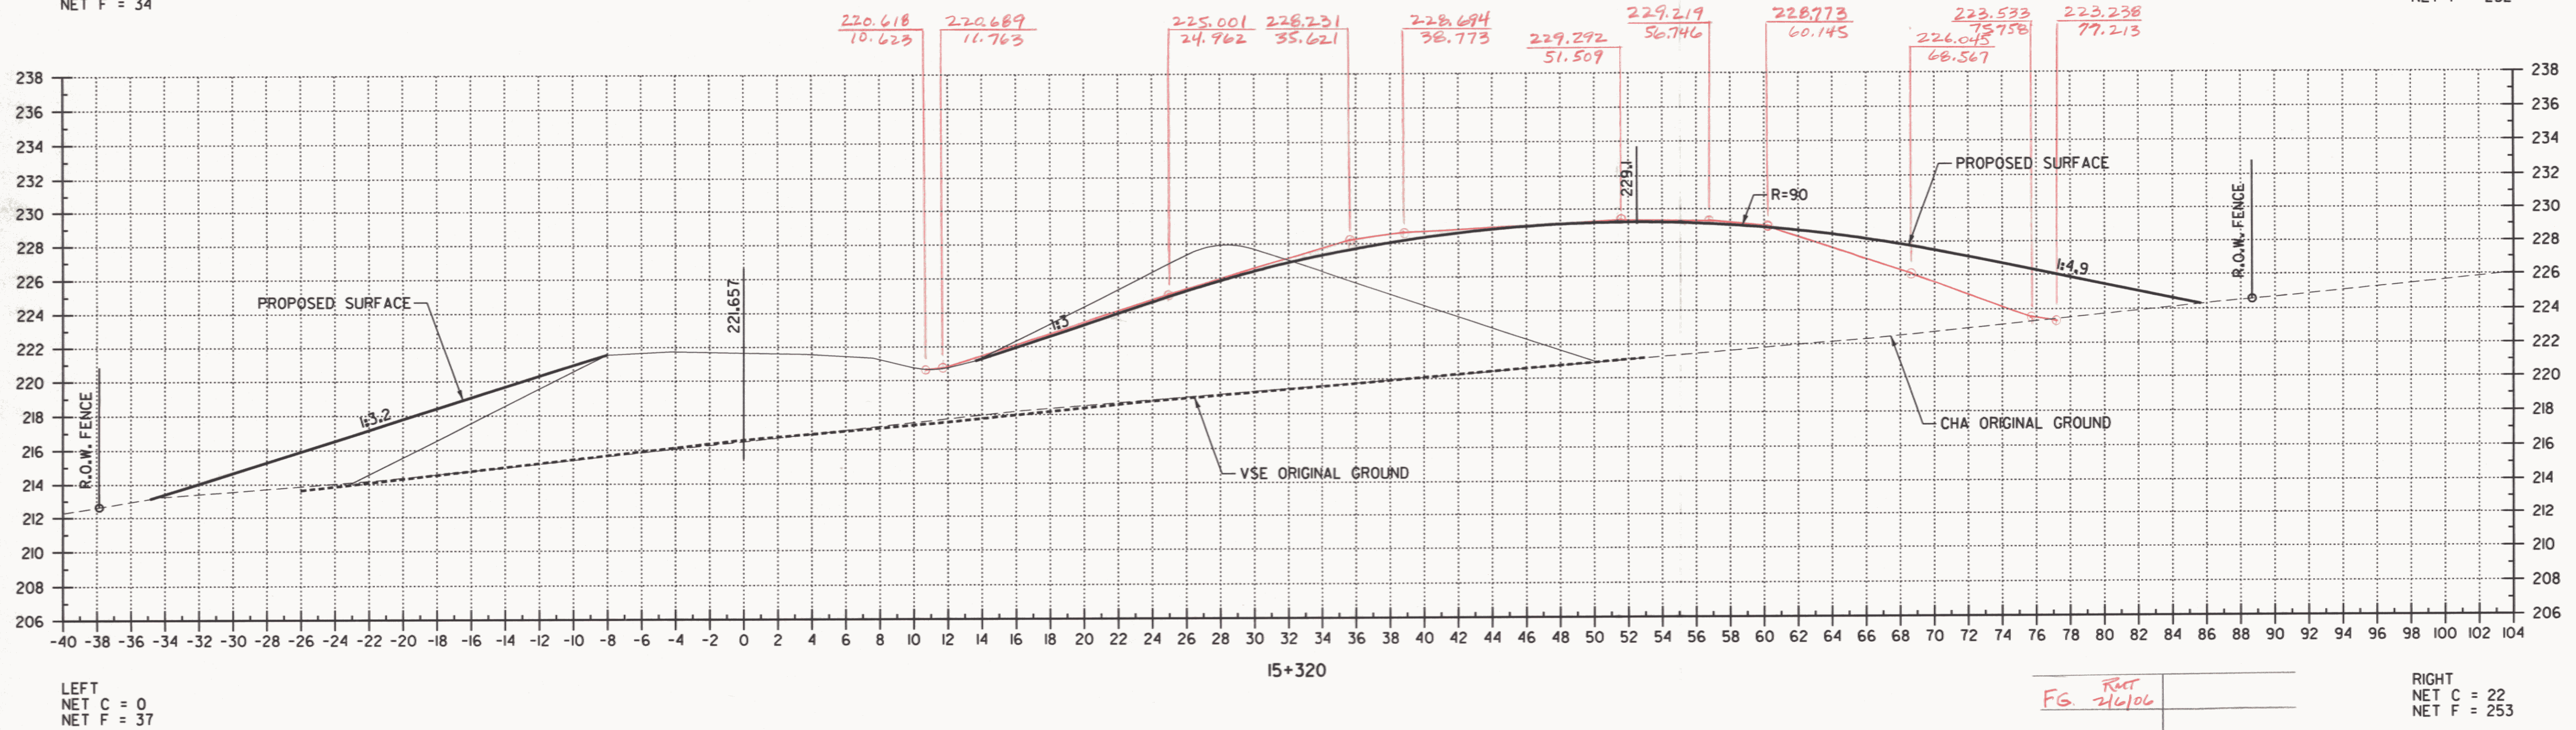

LEFT
NET C = 0
NET F = 37

RIGHT
NET C = 22
NET F = 253

REV
FG 2/6/06

FILE NAME = ut:\5116\VAOT\CONTRACT3\XSECT01.DGN
DATE/TIME = 01/21/03
USER = 2066

DATUM	
VERTICAL	NAVD 88
HORIZONTAL	NAD 83 (1992)

ALL DIMENSIONS IN METERS
EXCEPT AS INDICATED

H 1:200
V 1:200

**REVISED
CROSS
SECTIONS**

SURVEYED BY	C.H. & V.S.E.	DATE	12/93
DRAWN BY	J.S.L.	DATE	1/03
SQUAD LEADER	T.P.K.		
DESIGN FILE NO.	XSECT01.DGN		
IPARM FILE		DATE PLOTTED	1/03
PROJ. NAME	BENNINGTON - HOOSICK D.P.I. 0146(1) C/3		
PROJ. NO.	P.I.N. 1306.60		
SHEET	5 OF 8 SHEETS		

481