


LEFT
NET C = 0
NET F = 12

RIGHT
NET C = 6
NET F = 99

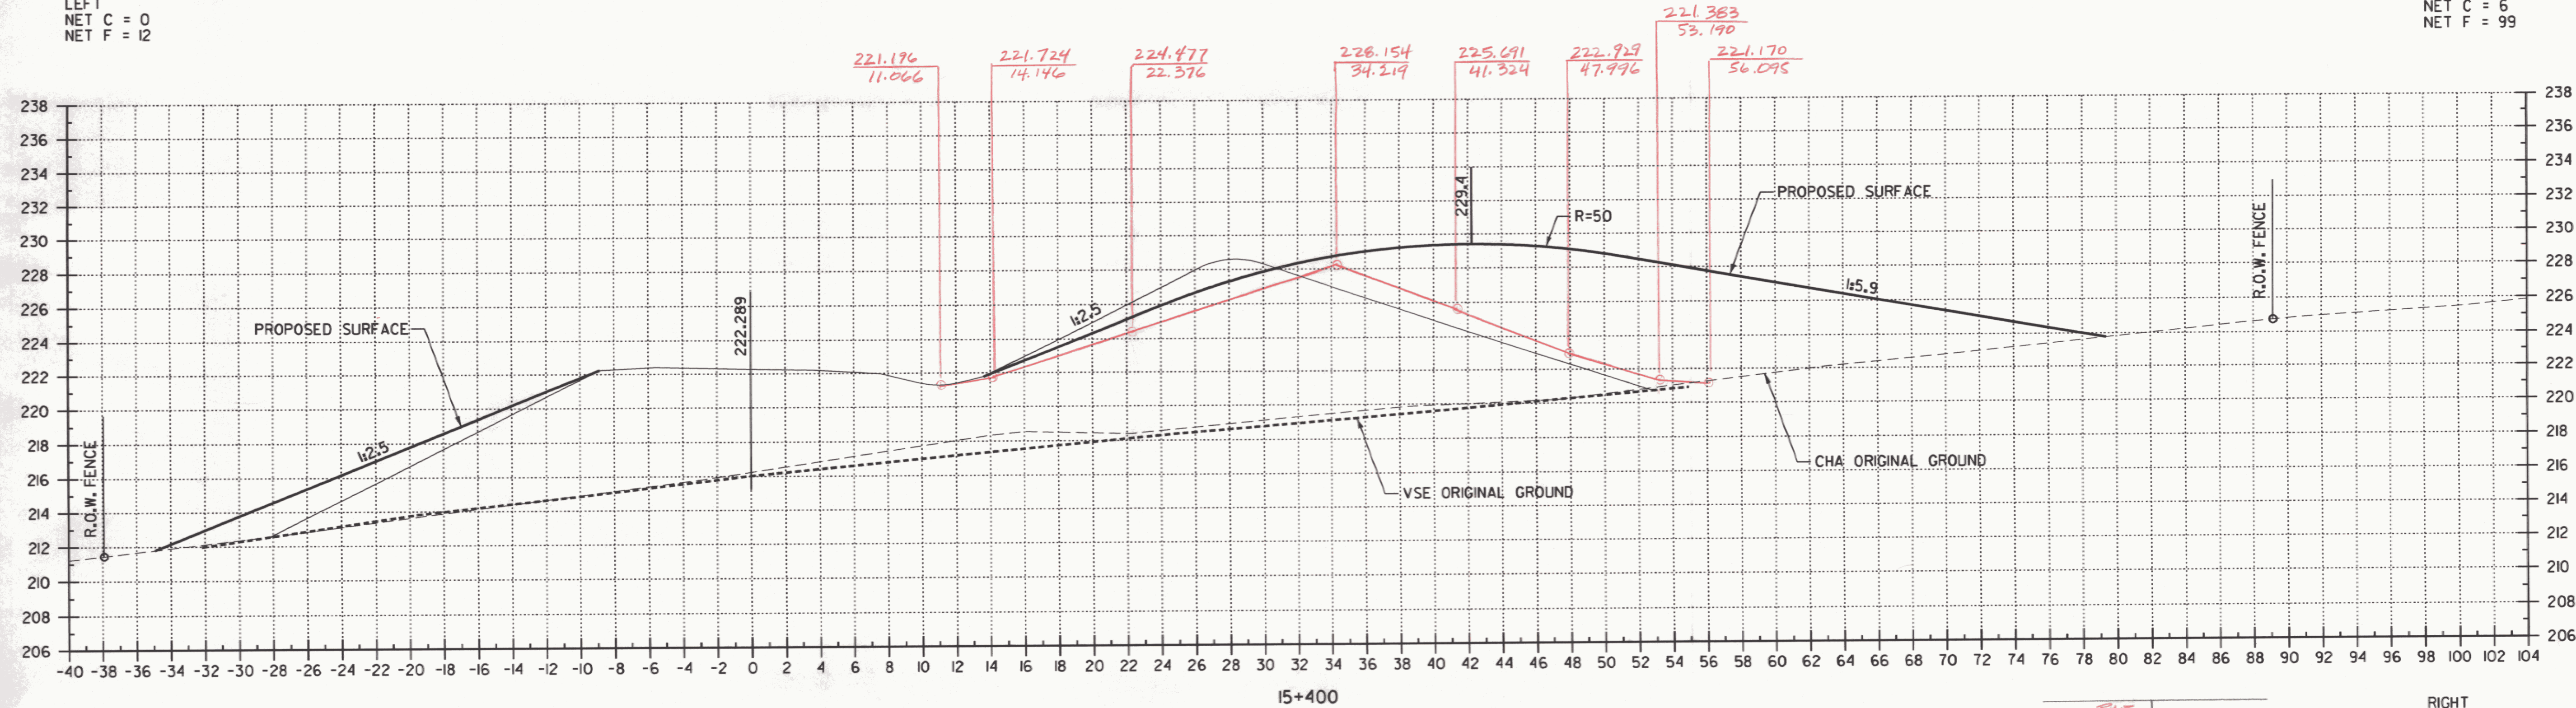


LEFT
NET C = 0
NET F = 25

RIGHT
NET C = 12
NET F = 198

FG R/W
2/6/06

FILE NAME = J:\516\VAOT\CONTRACT3\XSECT01.DGN
DATE/TIME = 01/21/03
USER = Z068

DATUM
VERTICAL NAVD 88
HORIZONTAL NAD 83 (992)

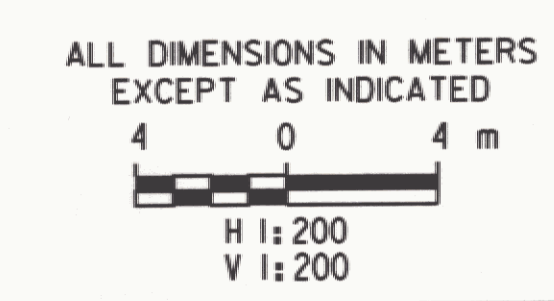

**REVISED
CROSS
SECTIONS**

SURVEYED BY C.H. & V.S.E. DATE 12/93
DRAWN BY J.S.L. DATE 1/03
SQUAD LEADER T.P.K.
DESIGN FILE NO. XSECT01.DGN
IPARM FILE DATE PLOTTED 1/03
PROJ. NAME BENNINGTON - HOOSICK
D.P.I. 0146(II) C/3
PROJ. NO. P.I.N. 1306.60
SHEET 7 OF 8 SHEETS 483