


LEFT
NET C = 0
NET F = 0

RIGHT
NET C = 0
NET F = 1

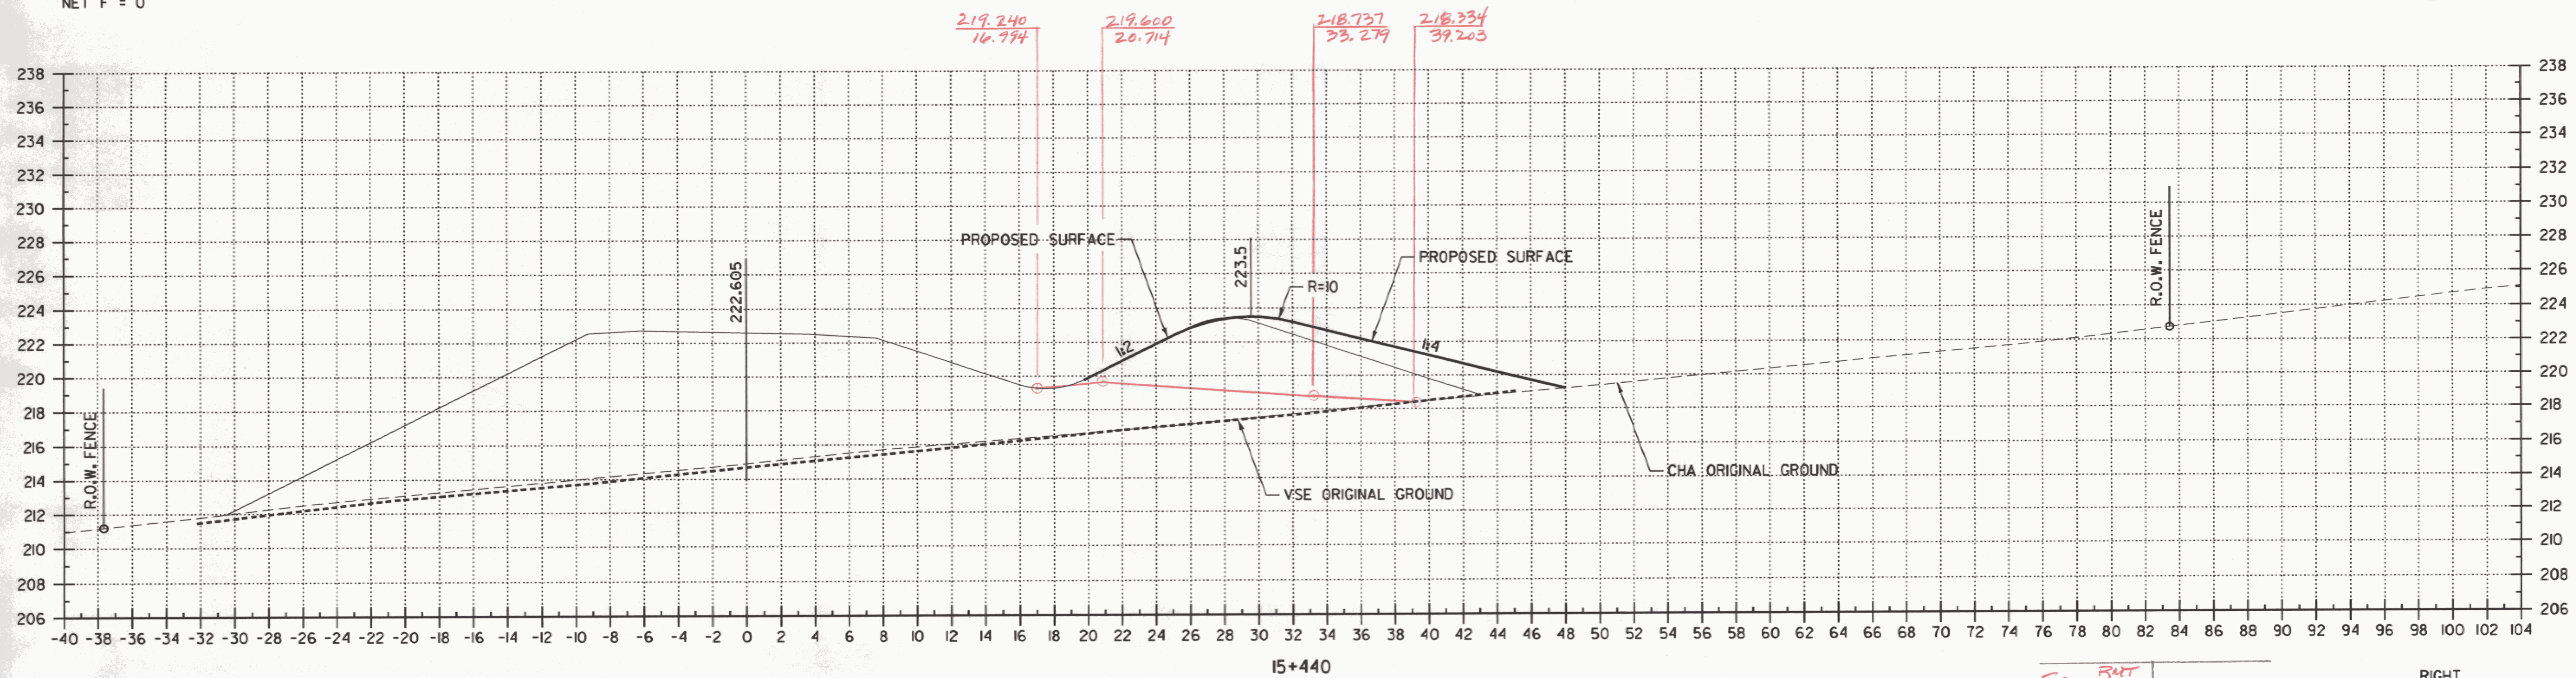

LEFT
NET C = 0
NET F = 0

RIGHT
NET C = 0
NET F = 19

FC. RUT
2/6/04

DATUM	
VERTICAL	NAVD 88
HORIZONTAL	NAD 83 (1992)

ALL DIMENSIONS IN METERS
EXCEPT AS INDICATED

H 1:200
V 1:200

**REVISED
CROSS
SECTIONS**

SURVEYED BY	C.H. & V.S.E.	DATE	12/93
DRAWN BY	J.S.L.	DATE	1/03
SQUAD LEADER	T.P.K.		
DESIGN FILE NO.	XSECT01.DGN		
IPARM FILE		DATE PLOTTED	1/03
PROJ. NAME	BENNINGTON - HOOSICK		
	D.P.L 0146(I) C/3		
PROJ. NO.	P.I.N. 1306.60		
SHEET 8 OF 8 SHEETS			484