

INDEX OF SHEETS  
SEE DWG. NO. IND-1 & IND-2

# STATE OF VERMONT AGENCY OF TRANSPORTATION




## PROPOSED IMPROVEMENT TOWN OF BENNINGTON COUNTY OF BENNINGTON VT. ROUTE 9

### BENNINGTON-HOOSICK D.P.I. 0146(I) C/4

BEGINNING APPROXIMATELY 4565 m (2.837 MILES) EAST OF THE VERMONT/NEW YORK STATE LINE AT STA. 16+695.000, BENNINGTON - HOOSICK D.P.I. 0146(I) C/4 PROCEEDS EASTERLY 610.027 m (0.379 MILE) CROSSING SILK ROAD AND THE WALLOOMSAC RIVER BEFORE TERMINATING AT THE VT. ROUTE 67A INTERCHANGE AT STA. 10+064.800 = W.B. STA. 17+305.027. THE PROJECT WILL INCLUDE RECONSTRUCTION OF THE EXISTING RAMPS FOR THE VT. ROUTE 67A INTERCHANGE RESULTING IN 1193.040 m (0.741 MILE) OF NEW RAMP CONSTRUCTION TO PROVIDE FULL-DIRECTIONAL ACCESS BETWEEN THE NEW HIGHWAY AND VT. ROUTE 67A, COLD PLANING AND PAVING 604.000 m (0.375 MILE) OF VT. ROUTE 67A, AND PAVING 251.723 m (0.156 MILE) OF SILK ROAD.

LENGTH OF ROADWAY 348.873 m (0.217 MILE)  
LENGTH OF STRUCTURE 261.154 m (0.162 MILE)  
LENGTH OF PROJECT 610.027 m (0.379 MILE)

VT STATE PLANE GRID

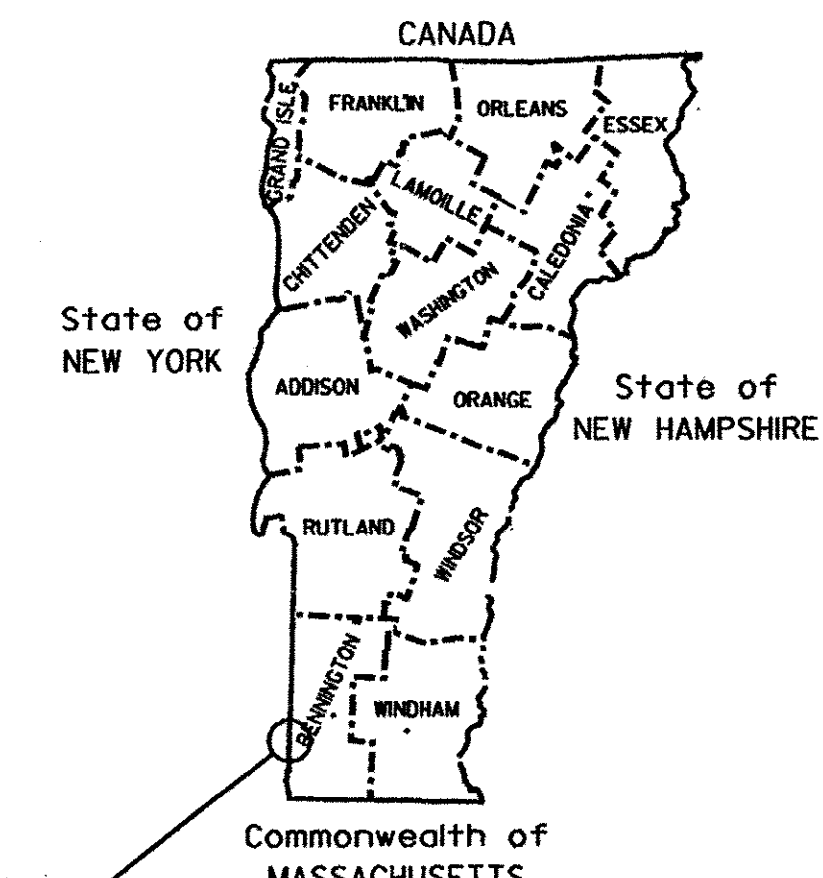

PROJECT LOCATION  
AC D.P.I. 0146(I)

#### TRAFFIC DATA

2000 ADT = 5300  
2020 ADT = 6600  
2020 ADTT = 460  
2020 DHV = 840  
T = 7%  
D = 52%  
V = 100 km/h  
2000 ~ 2020 CUM. ESALS = 4,825,000  
2000 ~ 2040 CUM. ESALS = 17,229,000  
PRINCIPAL ARTERIAL

RECORD PLANS	
CONTRACTOR:	KUBRICKY CONSTRUCTION CORP. - GLENS FALLS, NY
RESIDENT ENGINEER:	CHRIS BARKER
CONSTRUCTION BEGAN:	FEBRUARY 27, 2001
CONSTRUCTION COMPLETE:	JULY 27, 2004
RECORD PLANS BY:	CHRIS BARKER & NICK GARBACIK


I HEREBY CERTIFY THAT ALL THE CONSTRUCTION REQUIRED BY THIS SET OF DRAWINGS HAS BEEN ACCOMPLISHED AS INDICATED HEREIN.

BY Chris Barker RESIDENT ENGINEER  
DATE Oct. 14, 2013

NOTE: Any further information concerning final quantities, amounts or other details relative to this project may be found at Central Files in the electronic archives.


WORK TO BE PERFORMED UNDER THE VERMONT PORTION OF THIS PROJECT INCLUDES CONSTRUCTION OF A LIMITED ACCESS HIGHWAY AROUND THE NORTHWEST PORTION OF BENNINGTON (RELOCATION OF VT. ROUTE 9) AND WILL CONSIST OF ROADWAY AND BRIDGE CONSTRUCTION - WITH ASSOCIATED GRADING, PAVING, DRAINAGE, PAVEMENT MARKINGS, SIGNING AND INCIDENTAL ITEMS.

BITUMINOUS CONCRETE PAVEMENT SUPERPAVE MIXTURE DESIGN CRITERIA	
DESIGN LANE / DESIGN LIFE ESAL	8,614,500
DESIGN NUMBER OF CYRATIONS	100
PERFORMANCE GRADED ASPHALT BINDER	PG 58-28

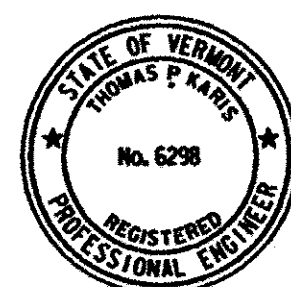

PLANS PREPARED BY  
**CHA CLOUGH, HARBOUR & ASSOCIATES LLP**  
ENGINEERS, SURVEYORS, PLANNERS & LANDSCAPE ARCHITECTS  
111 WINNERS CIRCLE ALBANY, NEW YORK, 12205

BY Thomas P. Harter

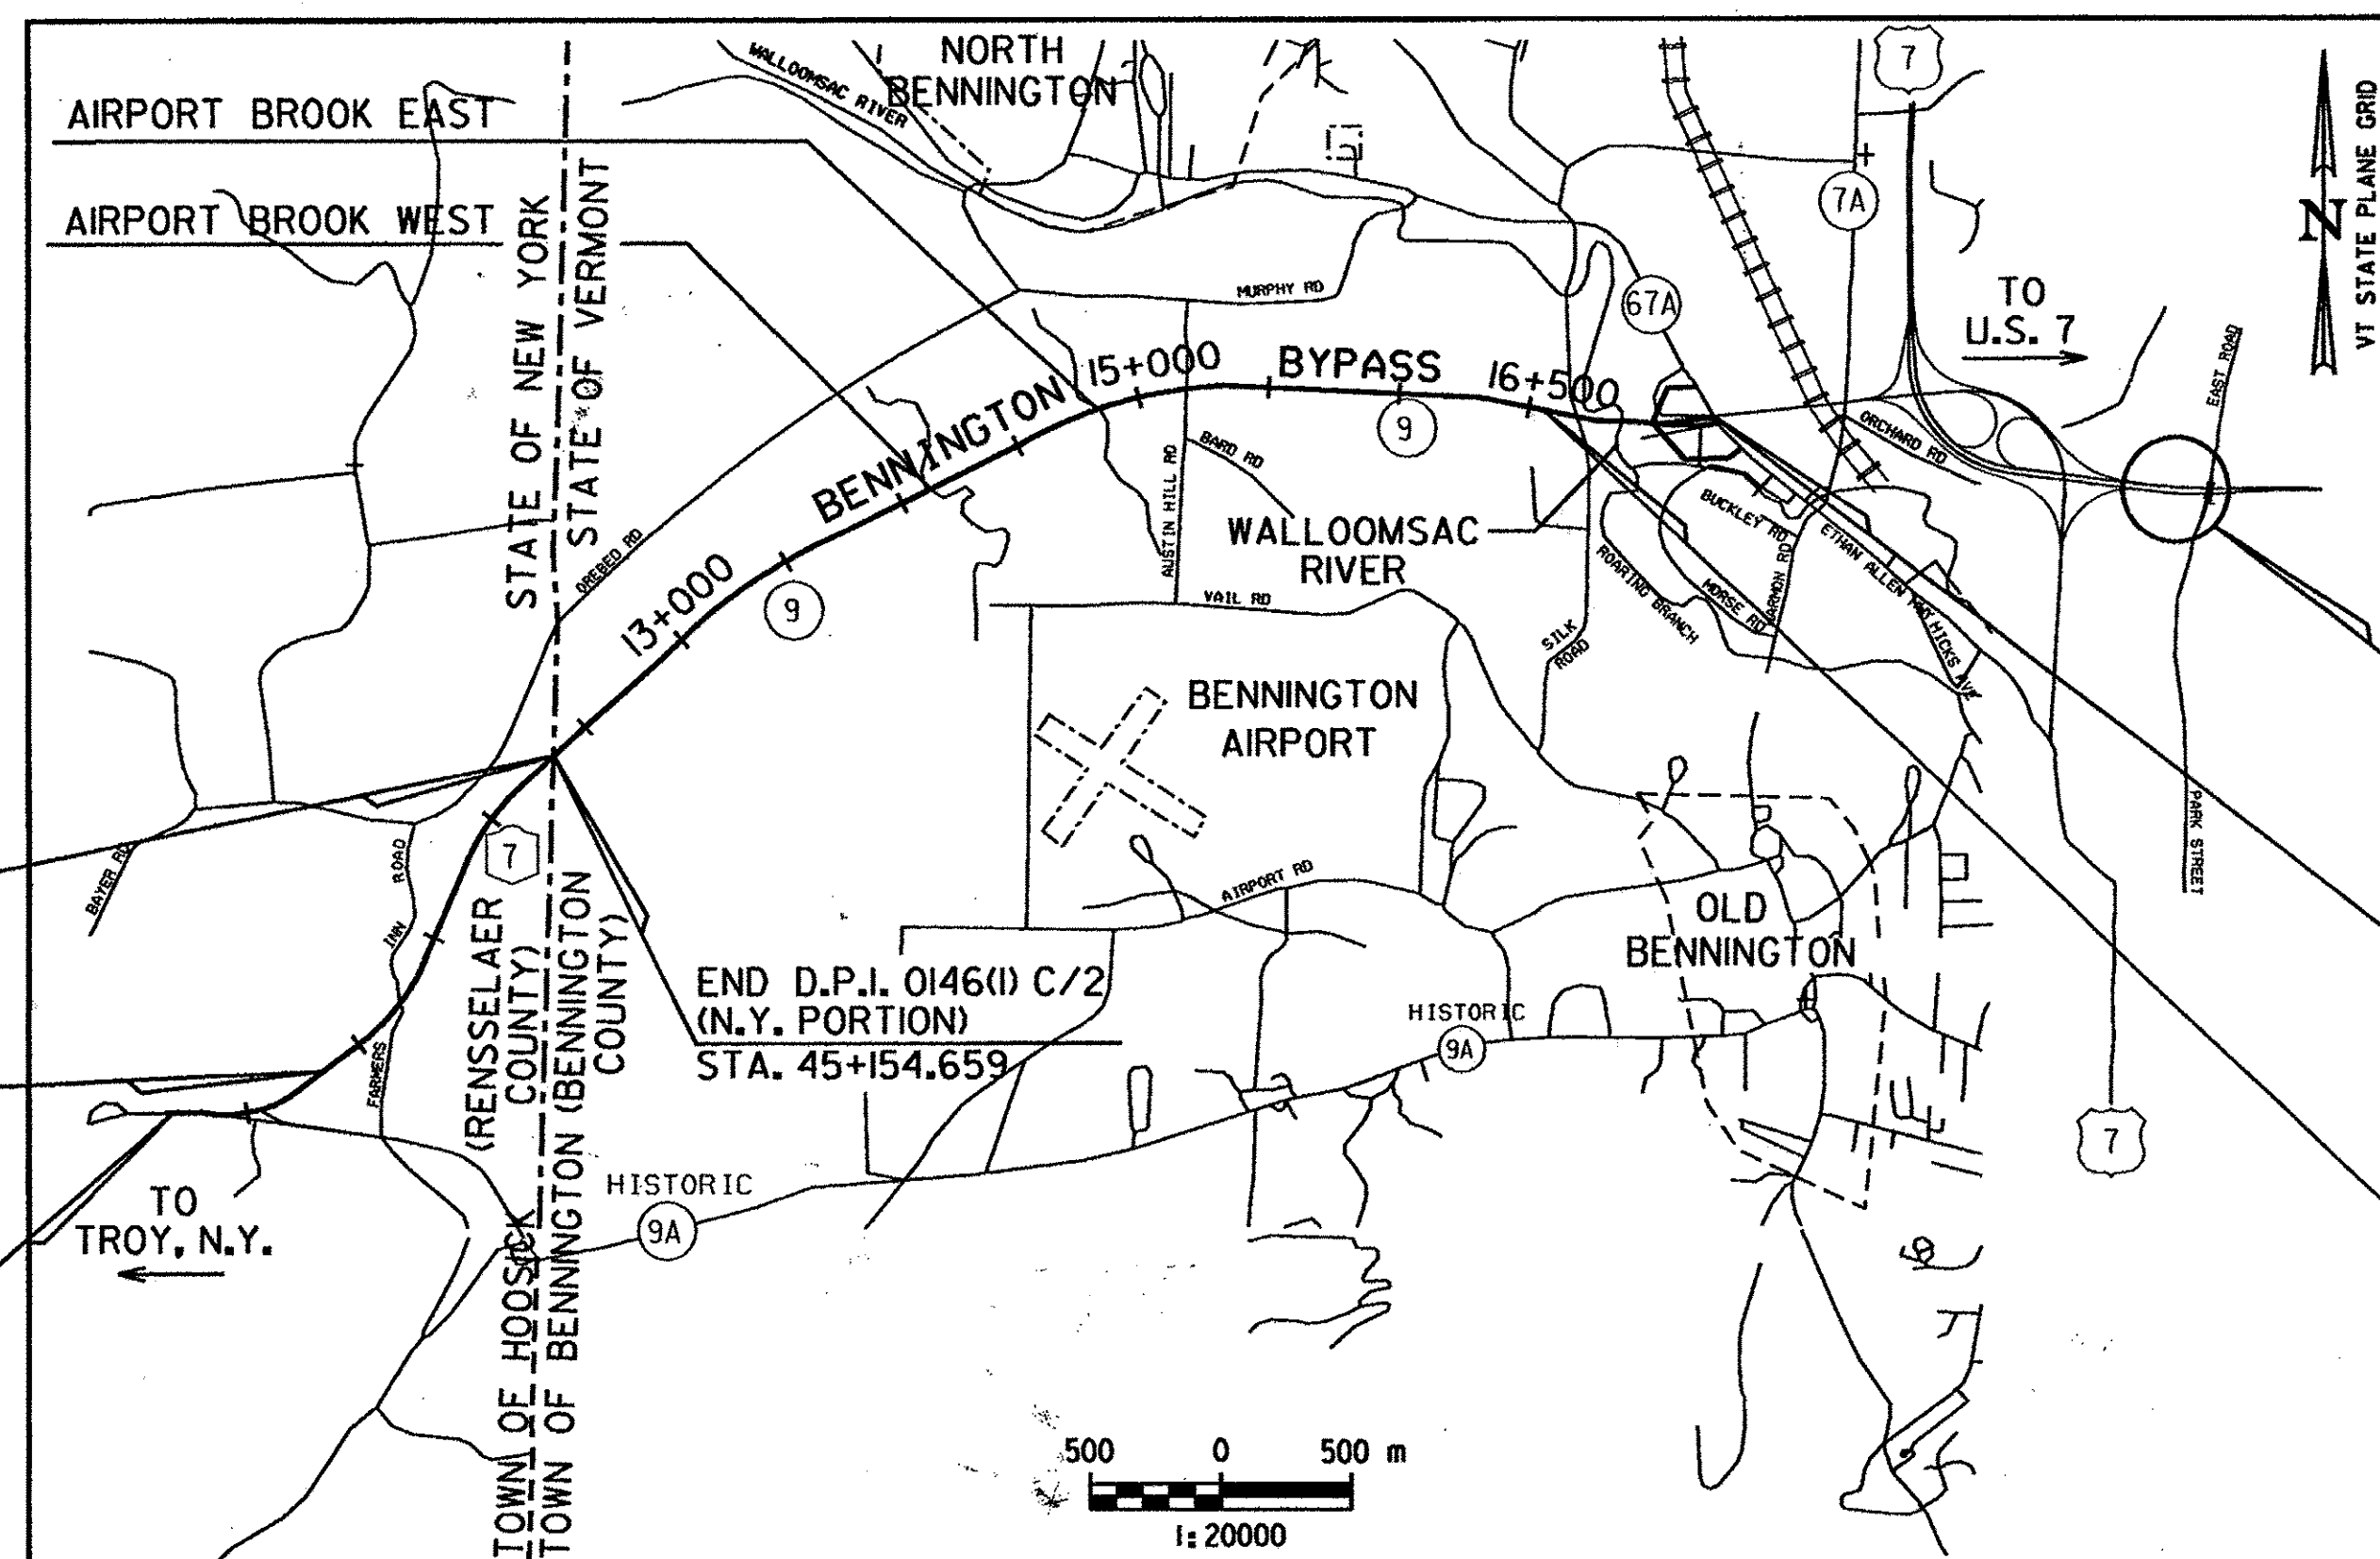

## CONTRACT PLANS SEPTEMBER 15, 2000

THESE PLANS ARE SUBJECT TO SUCH ENGINEERING CHANGES AS MAY BE REQUIRED BY THE FEDERAL HIGHWAY ADMINISTRATION OR THE CHIEF ENGINEER.

CONSTRUCTION IS TO BE CARRIED ON IN ACCORDANCE WITH THESE PLANS AND THE STANDARD SPECIFICATIONS FOR CONSTRUCTION DATED 1995, AS APPROVED BY THE FEDERAL HIGHWAY ADMINISTRATION ON AUGUST 21, 1995 FOR USE ON THIS PROJECT, INCLUDING ALL SUBSEQUENT REVISIONS AND SUCH REVISED SPECIFICATIONS AND SPECIAL PROVISIONS AS ARE INCORPORATED IN THESE PLANS.

OFF-SITE  
BORROW AREA

END D.P.I. 0146(I) C/4  
BEGIN D.P.I. 0146(I) C/6  
(VT. PORTION)  
STA. 10+064.800 =  
W.B. STA. 17+305.027

END D.P.I. 0146(I) C/3  
BEGIN D.P.I. 0146(I) C/4  
(VT. PORTION)  
STA. 16+695.000



SUBMITTED BY ORDER OF THE STATE TRANSPORTATION BOARD	
APPROVED <u>M. W. Houten</u>	DATE <u>9/21/00</u>
SPECIAL PROJECTS ENGINEER	
DEPARTMENT OF TRANSPORTATION FEDERAL HIGHWAY ADMINISTRATION	
APPROVED _____	DATE _____
DIVISION ADMINISTRATOR	
PROJECT BENNINGTON-HOOSICK AC-NH-D.P.I. 0146(I) C/4 P.L.N. 1306.60	
DWG. NO. T-1	SHEET 1 OF 385 SHEETS

#### CONVENTIONAL SIGNS

- COUNTY LINE
- TOWN LINE
- LIMITS OF ACCESS
- POINT OF ACCESS
- FENCE LINE
- STONE WALL
- TRAVELED WAY
- GUARD RAIL
- RAILROAD
- SURVEY LINE
- CULVERT
- POWER POLE
- TELEPHONE POLE
- TREES
- CONTROL OF ACCESS
- PROPERTY LINE
- R.O.W. TAKING LINE
- SLOPE RIGHTS
- TOP OF CUT
- TOE OF SLOPE

DATUM  
VERTICAL NAVD 88  
HORIZONTAL NAD 83 (1992)

FILE NAME = u:\5116\voct\contract4\cover.dgn  
DATE/TIME = 11 SEP 2000  
USER = 1459