

MATCH LINE ROW SHEET 56

MATCH LINE ROW SHEET 59


MATCH LINE ROW SHEET 60

MATCH LINE ROW SHEET 58

MATCH LINE ROW SHEET 58

LINES SHOWN ON THIS PLAN AS EXISTING PROPERTY LINES P/L ARE BELIEVED TO BE ACCURATE BUT SHOULD NOT BE RELIED UPON FOR PURPOSES UNRELATED TO THE STATE OF VERMONT'S ACQUISITION OF LAND AND RIGHTS FOR THIS PROJECT.

THIS SHEET TO BE USED FOR RIGHT-OF-WAY INFORMATION ONLY

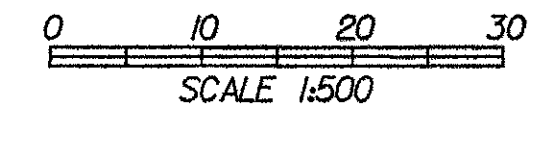

DATUM
 VERTICAL NAVD 88
 HORIZONTAL NAD 83 (1992)

PROJECT: BENNINGTON - HOOSICK	PROJECT NO.: D.P.I. 0146 (1)
DESIGN FILE NAME:	PLOT DATE:
IPARM FILE NAME:	SURVEY DATE:
SURVEYED BY:	DRAWN BY: VSE
SQUAD LEADER: DHH	SHEET: 43 OF 385
DWG. NO. ROW-57	