


MATCH LINE ROW SHEET A



Metric

APPROX. LOCATION OF ACCESS
TO AIRPORT BEACON NO. 1

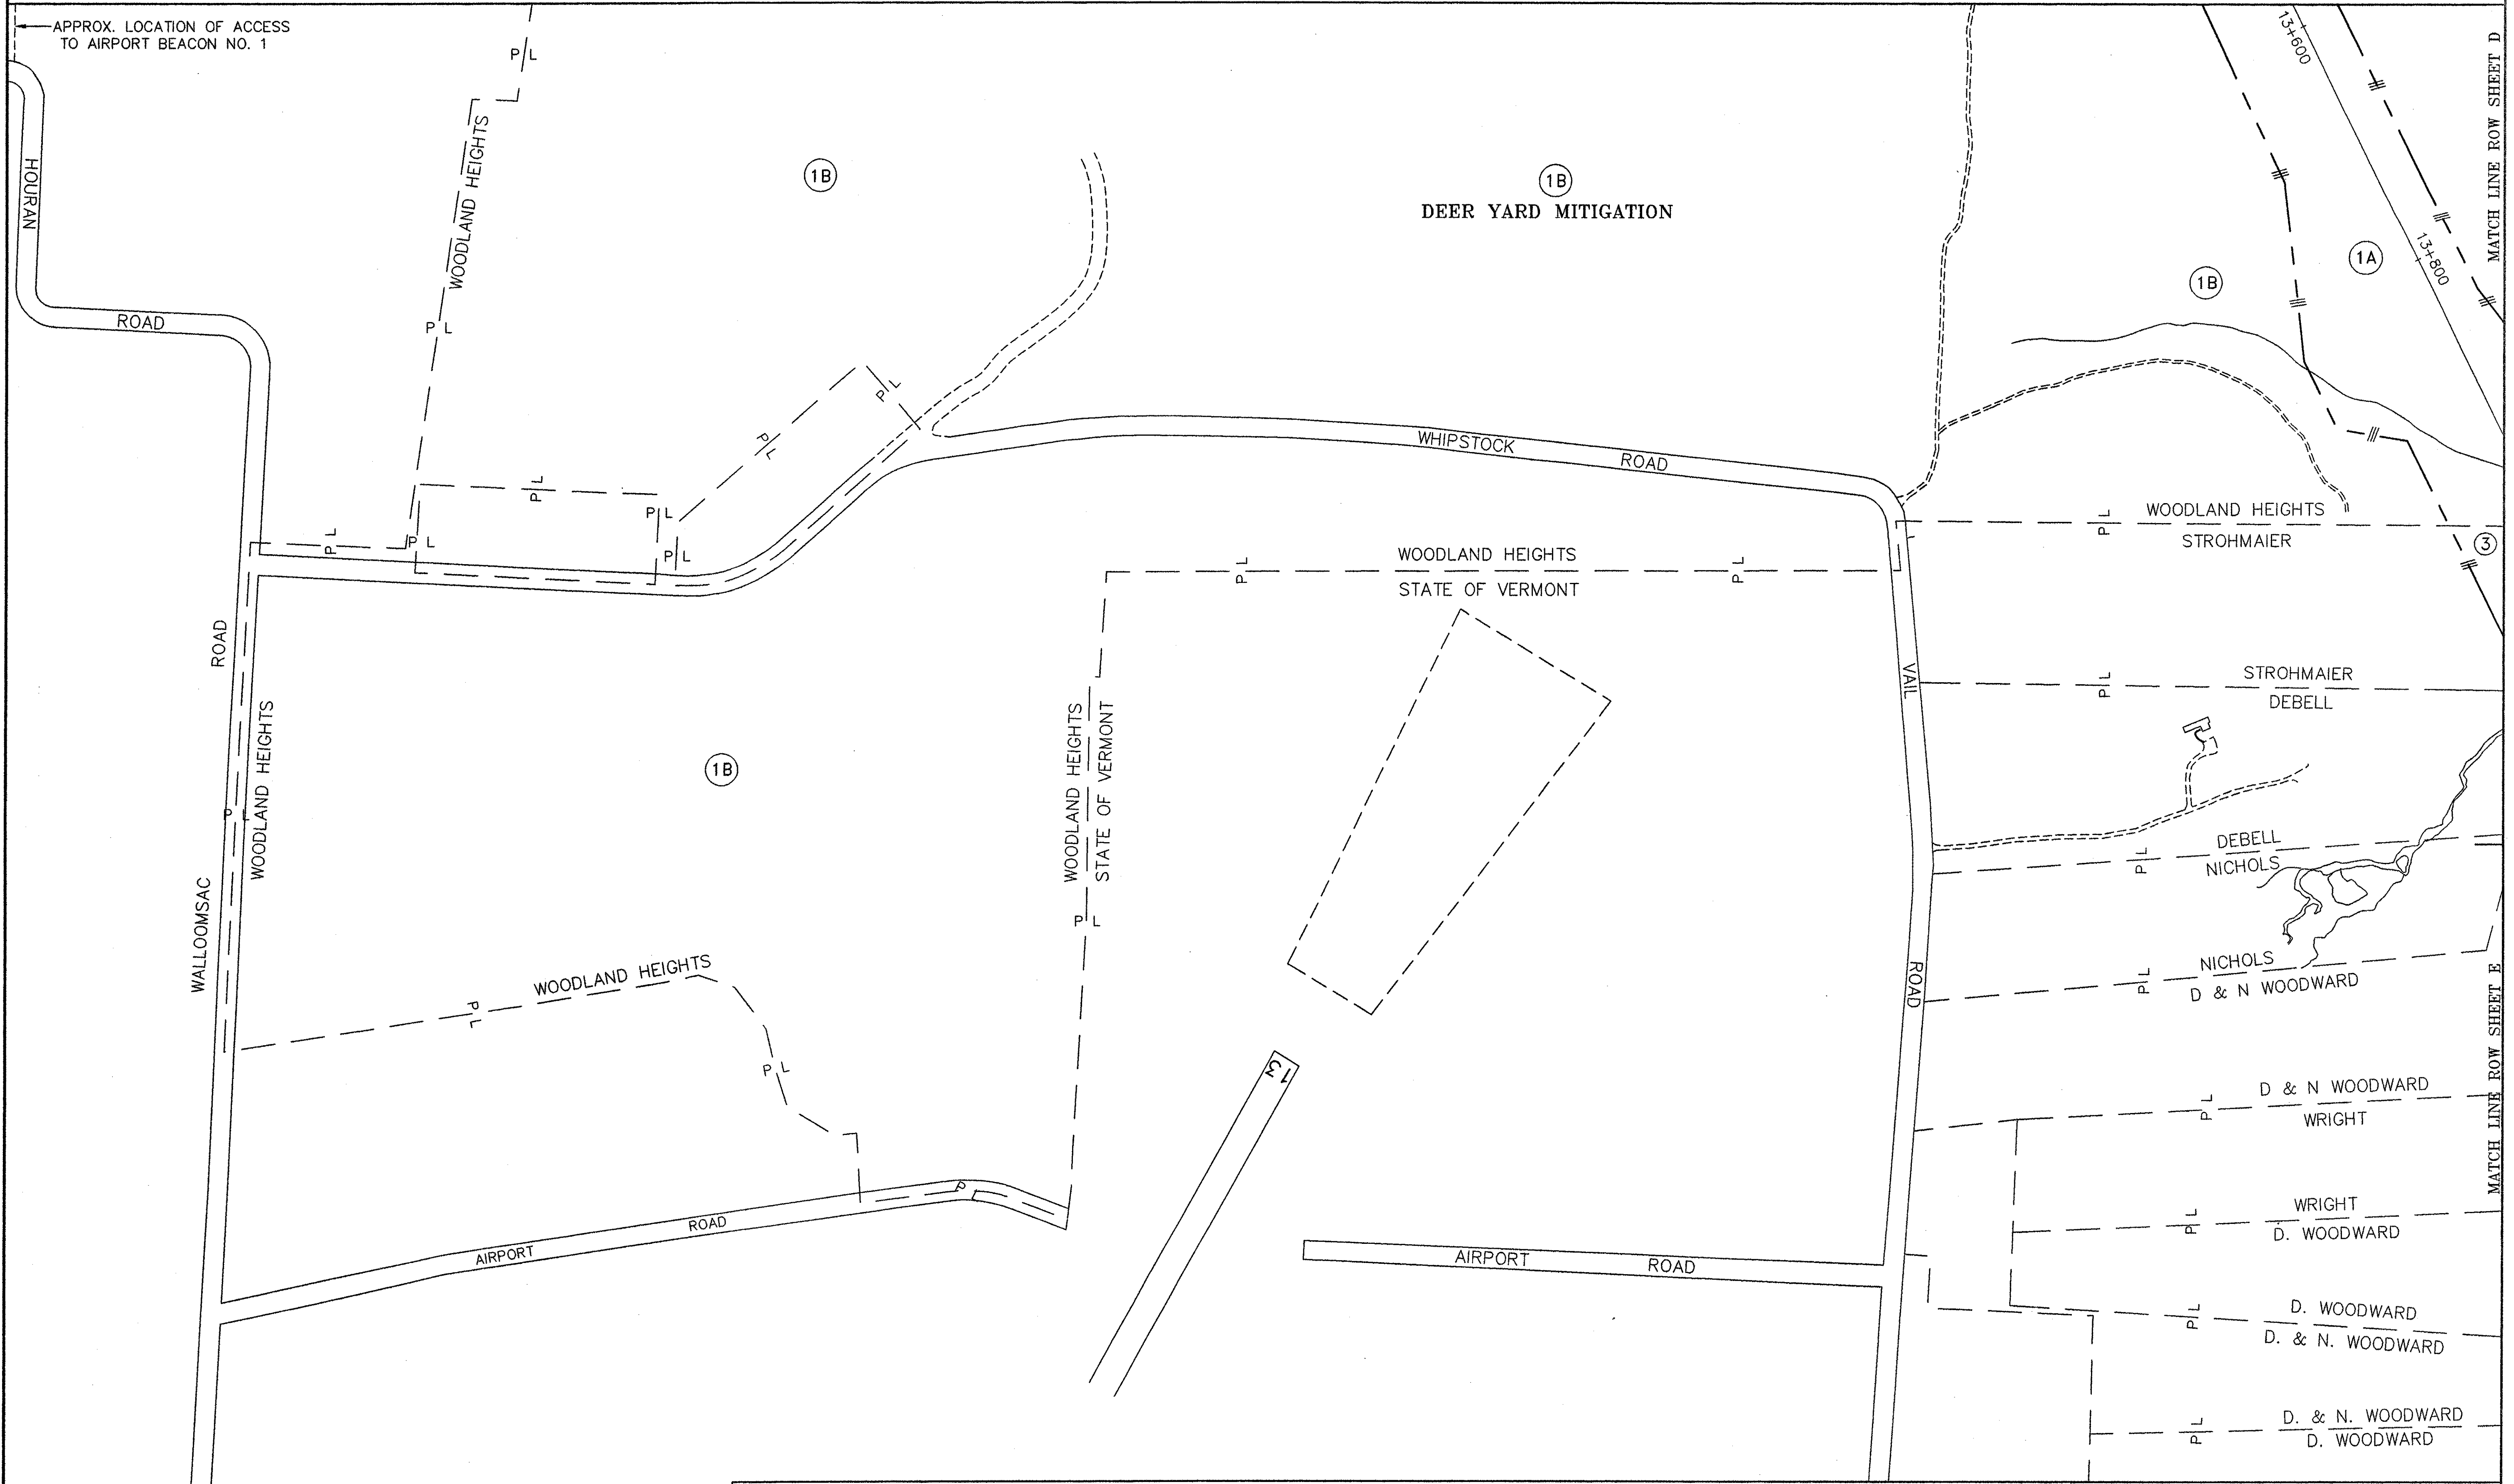

MATCH LINE ROW SHEET C

WATER AND SEWER SYSTEMS WITHIN AND
IMMEDIATELY ADJACENT TO THE PROPOSED
ACQUISITION AREAS ARE SHOWN TO THE
BEST OF OUR KNOWLEDGE.

BENNINGTON-HOOSICK
D.P.I. 0146(1)

DWG. NO. ROW-B SHEET 49 OF 385
SCALE: 1" = 200' (1" = 60.96 m)