



LINE ROW SHEET E

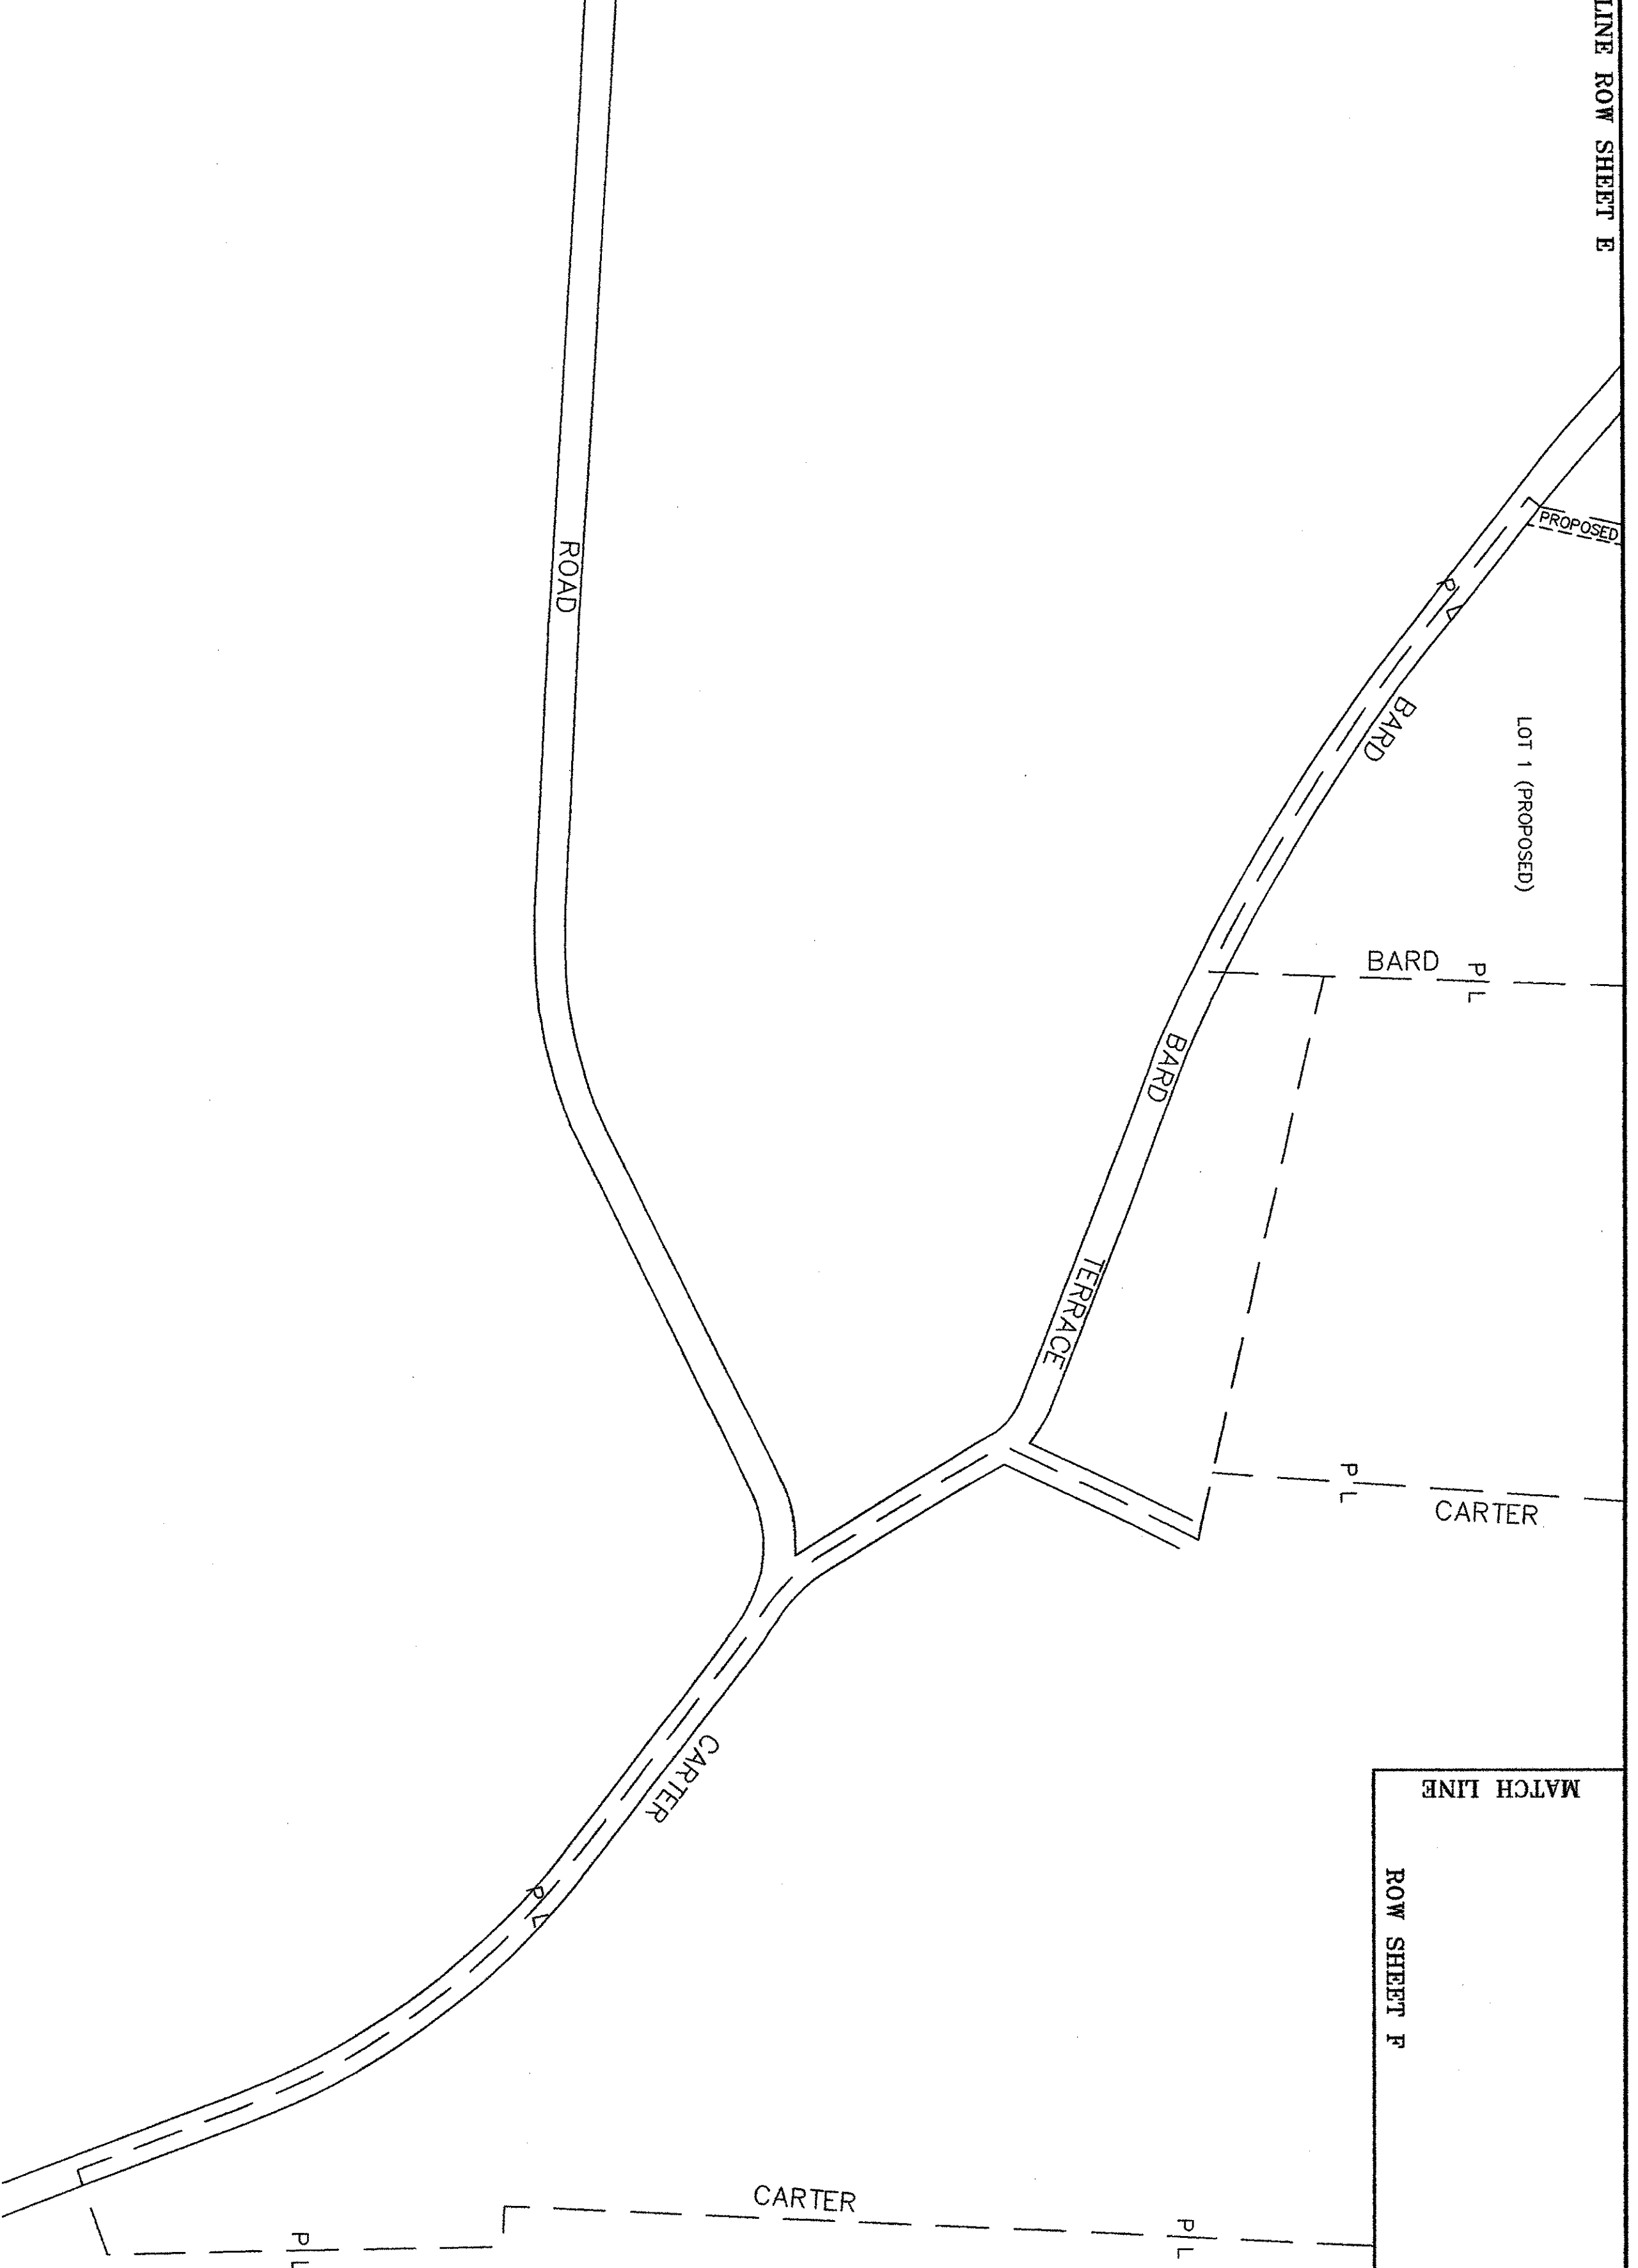

MATCH LINE

ROW SHEET F

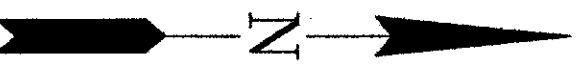

WATER AND SEWER SYSTEMS WITHIN AND IMMEDIATELY ADJACENT TO THE PROPOSED ACQUISITION AREAS ARE SHOWN TO THE BEST OF OUR KNOWLEDGE.

BENNINGTON-HOOSICK
 D.P.I. 0146(1)
 DWG. NO. ROW-C SHEET 50 OF 385
 SCALE: 1" = 200' (1" = 60.96 m)