



N/F UNITED STATES OF AMERICA
BK. 0-331, PG. 154

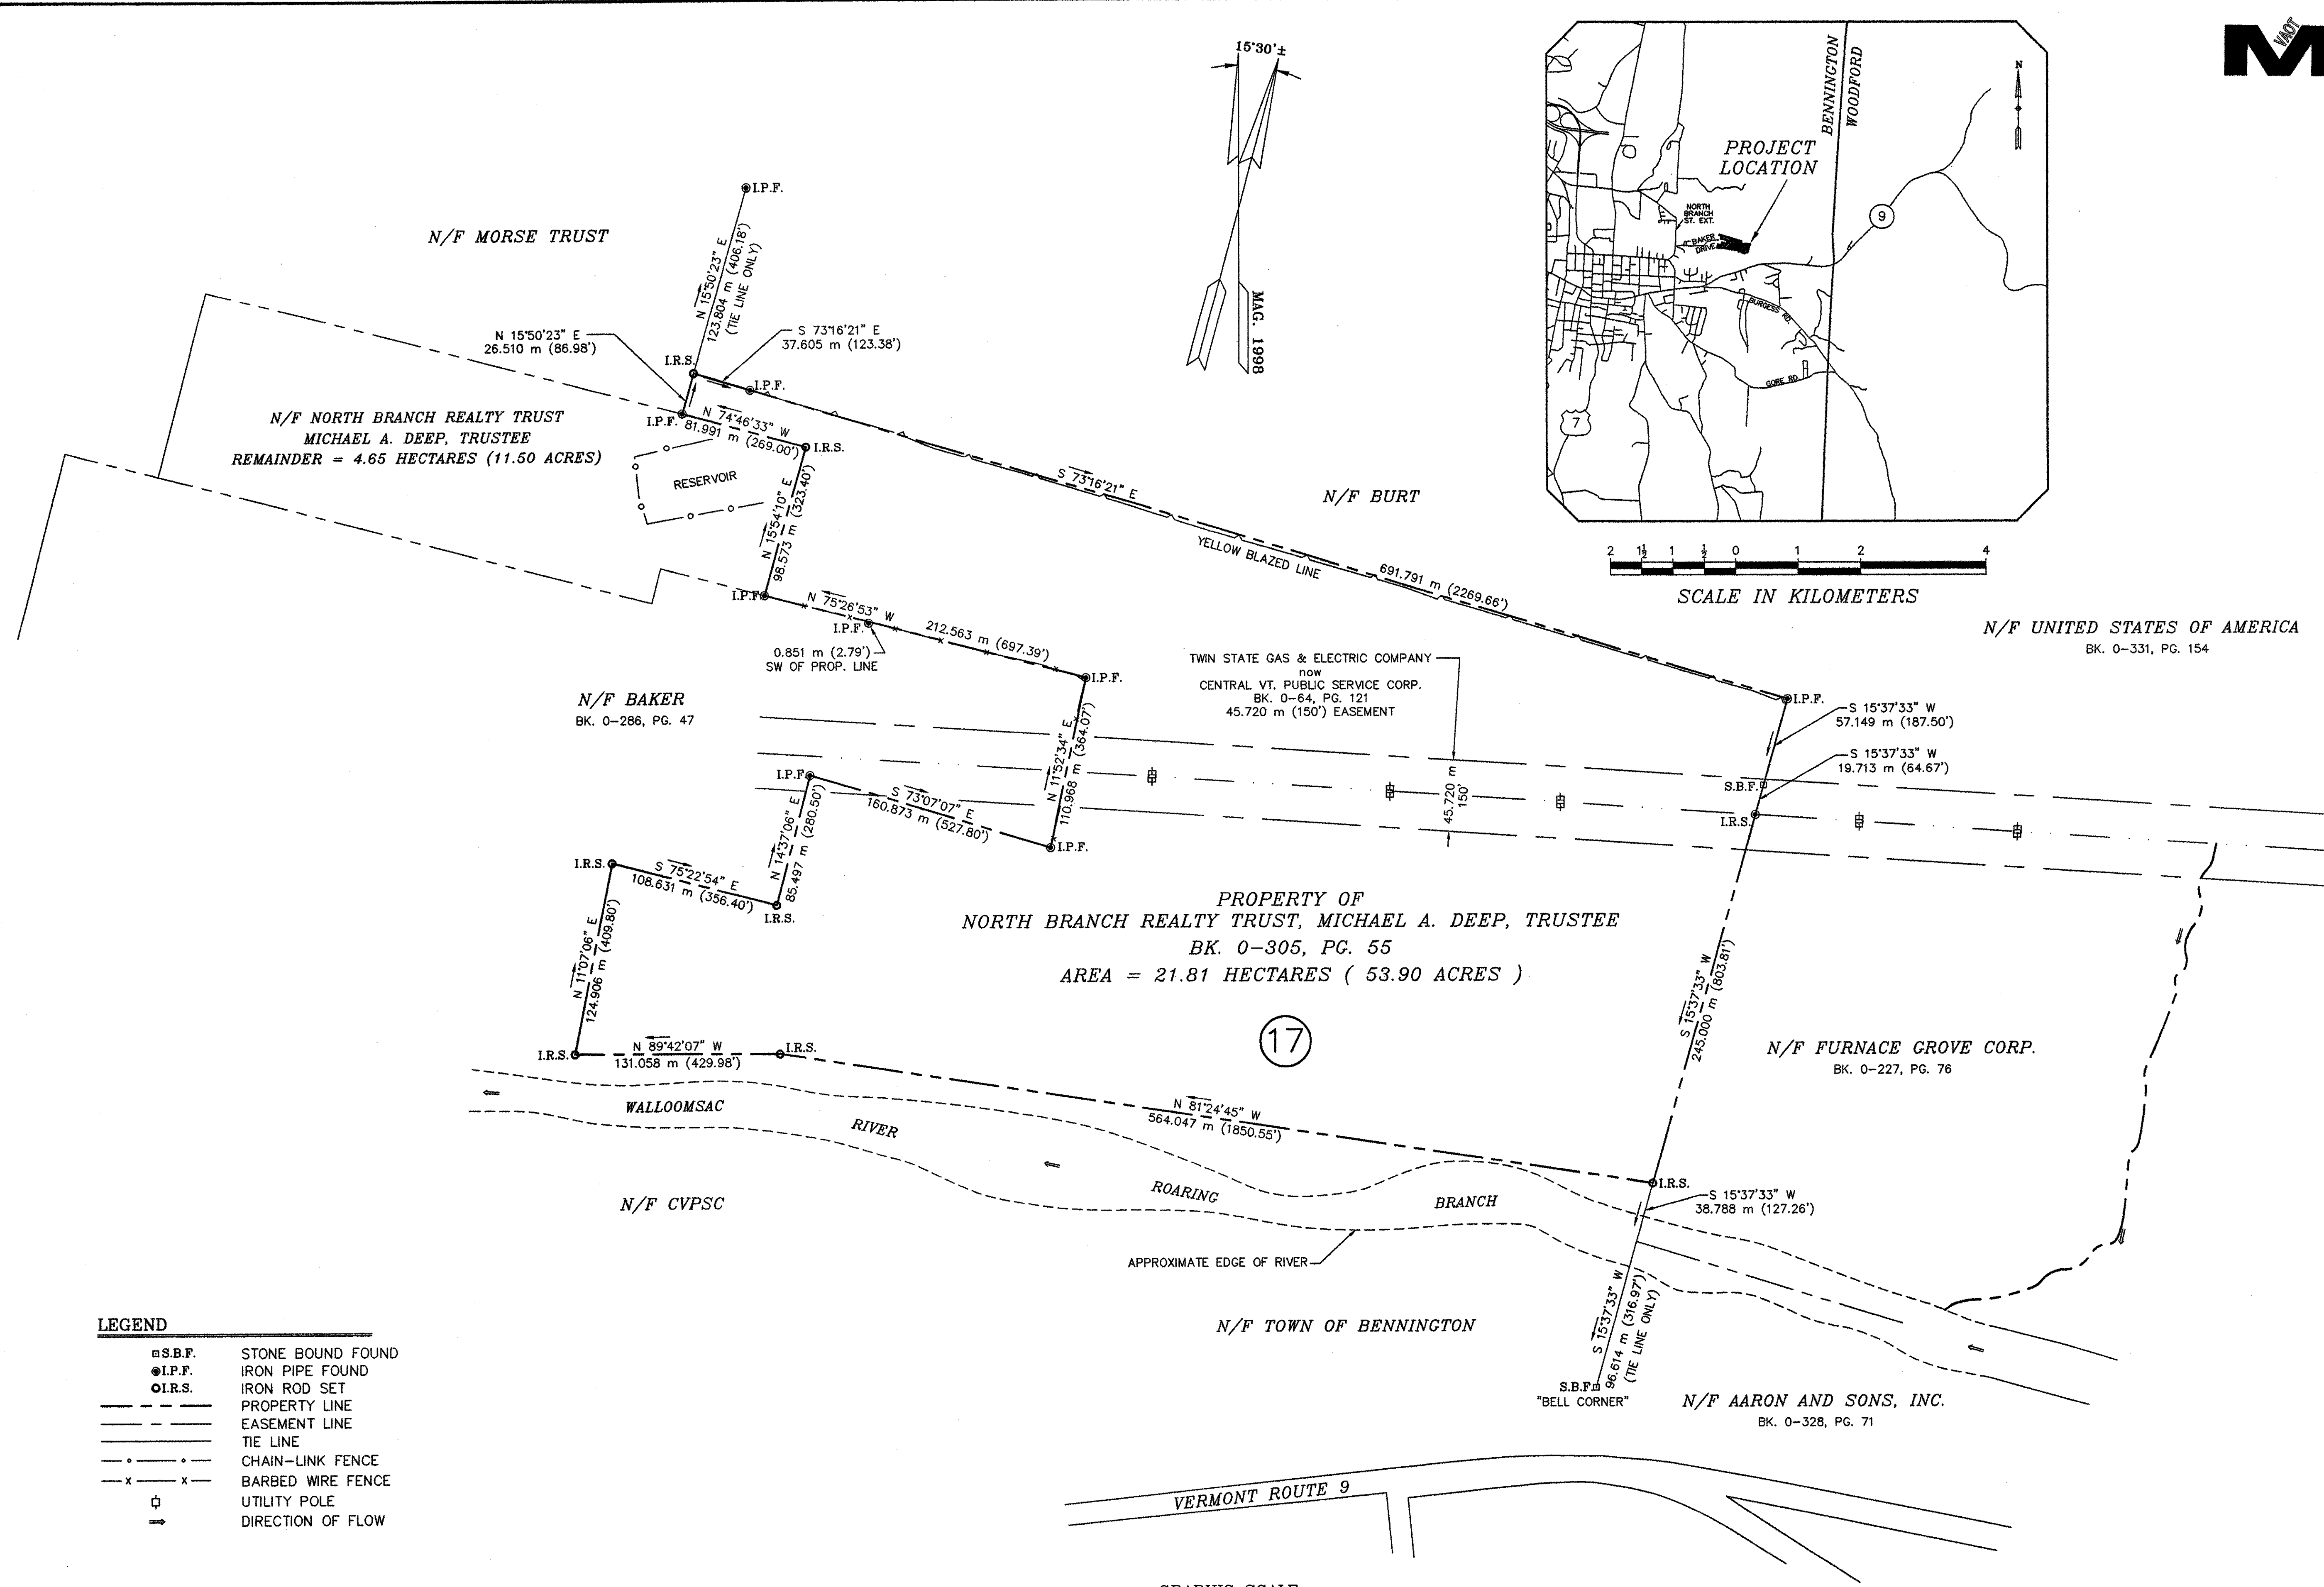

LEGEND

□ S.B.F.	STONE BOUND FOUND
● I.P.F.	IRON PIPE FOUND
○ I.R.S.	IRON ROD SET
---	PROPERTY LINE
- - -	EASEMENT LINE
---	TIE LINE
- · - · -	CHAIN-LINK FENCE
- x - x -	BARBED WIRE FENCE
⊕	UTILITY POLE
→	DIRECTION OF FLOW

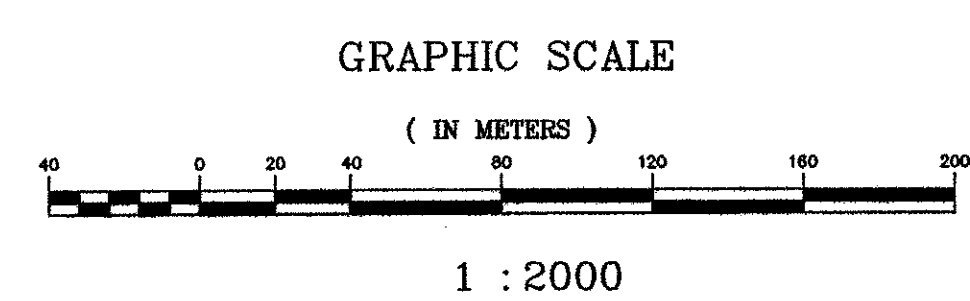

WATER AND SEWER SYSTEMS WITHIN AND IMMEDIATELY ADJACENT TO THE PROPOSED ACQUISITION AREAS ARE SHOWN TO THE BEST OF OUR KNOWLEDGE.

BENNINGTON-HOOSICK
D.P.I. 0146(1)

DWG. NO. ROW-H SHEET 55 OF 385
SCALE: 1:2000 (1"=166.67')

The following information was considered during compilation of this plan:

- Those deeds to which reference is made on this plan, and deeds in the chains of title to the parcels shown hereon. These deeds are a matter of public record in the Town of Bennington, Vermont.
- A compilation plat entitled, "FURNACE GROVE CORPORATION, TRACT 246", prepared by Allan Hopkins, recorded on Jan. 9, 1997, in Map Slide #99 of the Bennington land records.