

604.42 CHANGING ELEVATION OF SEWER MANHOLE  
 STA. 6I+135.7 LT

616.20 GRANITE SLOPE EDGING  
 STA. ABIO+035.5 - STA. ABIO+059.8 RT (71.4 m)  
 STA. ABIO+043.6 - STA. ABIO+110.0 LT (65.9 m)  
 STA. ABIO+043.6 - STA. ABIO+110.0 RT (65.9 m)

616.26 PRECAST REINFORCED CONCRETE CURB, TYPE B OR  
 616.28 CAST-IN-PLACE CEMENT CONCRETE CURB, TYPE B  
 STA. ABIO+036.5 - STA. ABIO+094.4 LT (82.6 m)  
 STA. ABIO+040.2 - STA. ABIO+110.0 RT (78.3 m)  
 STA. 6I+040.0 - STA. 6I+067.3 LT (27.3 m)  
 STA. 6I+158.7 - STA. 6I+196.9 LT (38.2 m)

616.41 REMOVAL OF EXISTING CURB  
 STA. 6I+040.0 - STA. 6I+087.0 LT (47.9 m) 54.9 m  
 STA. 6I+158.7 - STA. 6I+196.9 LT (41.2 m) 38.25 m  
 STA. ABIO+040.2 - STA. ABIO+080.0 RT (42.9 m)  
 STA. ABIO+037.0 - STA. ABIO+079.6 LT (48.7 m)  
 STA. ABIO+037.0 - STA. ABIO+110.0 RT (92.1 m)  
 STA. ABIO+079.6 - STA. ABIO+110.0 RT (42.0 m)


621.80 REMOVAL AND DISPOSAL OF GUARDRAIL  
 STA. 6I+088.0 - STA. 6I+104.0 LT (26.7 m)

629.20 ADJUST ELEVATION OF VALVE BOX  
 STA. 6I+040.8 RT  
 STA. 6I+177.0 RT  
 STA. ABIO+010.0 RT  
 STA. ABIO+123.5 RT 020.0 RT

620.12 CHAIN-LINK FENCE, 1.8 m  
 STA. ABIO+072.500 - STA. ABIO+102.300 RT (27.2 m)  
 STA. ABIO+102.300 - STA. ABIO+110.000 RT (7.8 m)  
 STA. 6I+040.000 - STA. 6I+075.600 LT (35.8 m)  
 STA. 6I+075.600 - STA. 6I+093.100 LT (29.5 m)


620.21 BRACING ASSEMBLY FOR CHAIN-LINK FENCE, 1.8 m  
 ABIO+072.500 RT (IEA)  
 ABIO+102.300 RT (IEA)  
 STA. 6I+075.600 LT (IEA)  
 STA. 6I+093.100 LT (IEA)

620.55 REMOVAL OF EXISTING FENCE  
 STA. ABIO+068.700 - STA. ABIO+110.000 RT (36.4 m)

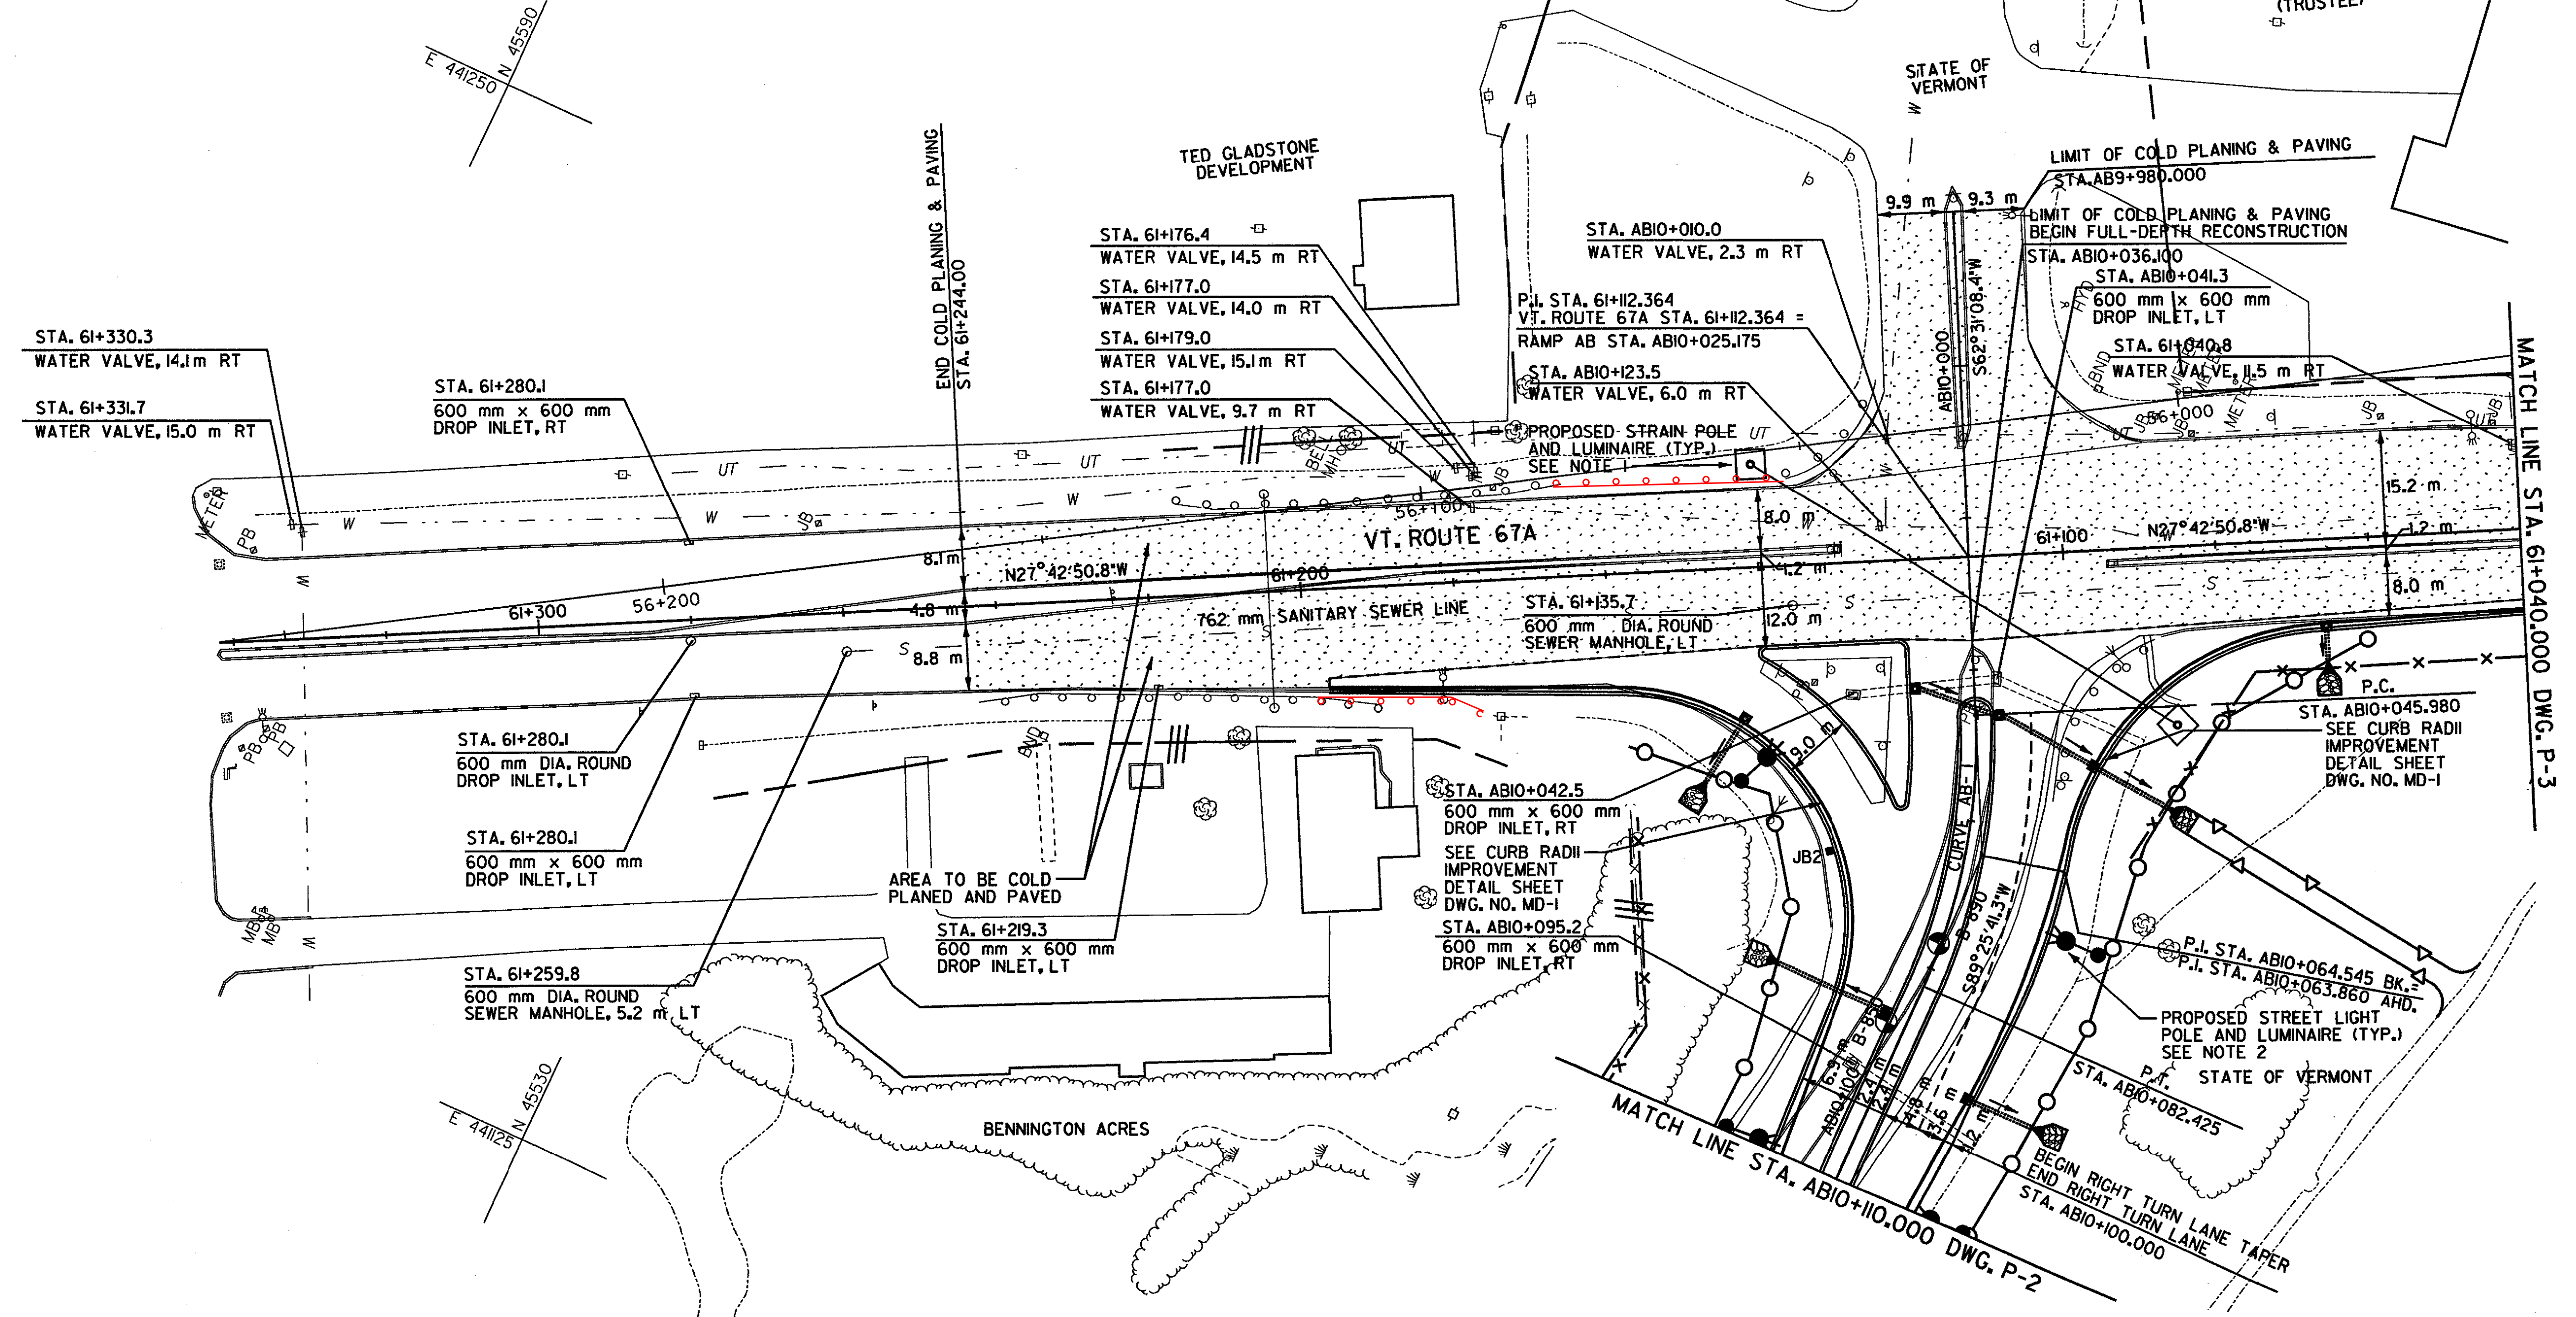

- NOTES:  
 1. SEE DWG. NO. SD-1 TO SD-8 FOR PROPOSED TRAFFIC SIGNAL PLANS.  
 2. SEE DWG. NO. SLP-1 TO SLP-3 FOR PROPOSED STREET LIGHTING PLANS.  
 3. ALL COLD PLANNED AREAS SHALL BE PAVED WITH A LEVELING COURSE FOR THE TRAVELING PUBLIC.

**CURVE AB-1**  
 P.C. = STA. ABIO+045.980  
 P.T. = STA. ABIO+082.425  
 $\Delta = 26^\circ 54' 32.9''$  RT  
 R = 77.600 m  
 T = 18.565 m  
 L = 36.445 m  
 E = 2.190 m  
 $e_{max} = 0.020$  DN, RT

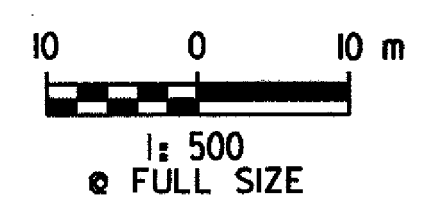

<b>PLAN</b>	SURVEYED BY	C.H.A. & V.S.E.	DATE	12/93
	DESIGNED BY	D.E.G.	DATE	9/00
	DRAWN BY	J.S.L.	DATE	9/00
	CHECKED BY	T.P.K.	DATE	9/00
DESIGN FILE NO. 5116/vaot/vtp26.dgn				
PROJ. NAME BENNINGTON - HOOSICK D.P.I. 0146(II) C/4				
PROJ. NO. P.I.N 1306.60				
DWG NO. P-6 SHEET 84 OF 385				

FILE NAME = ur\5116\vaot\contract4\tp26.dgn  
 DATE/TIME = 06 SEP 2000  
 USER = 1459

<b>DATUM</b>	
VERTICAL	NAVD 88
HORIZONTAL	NAD 83 (992)