


FILE NAME =u:\5116\voet\contract4\prf20.dgn
DATE/TIME =07 SEP 2000
USER =1499

DATUM	
VERTICAL	NAVD 88
HORIZONTAL	NAD 83 (1992)

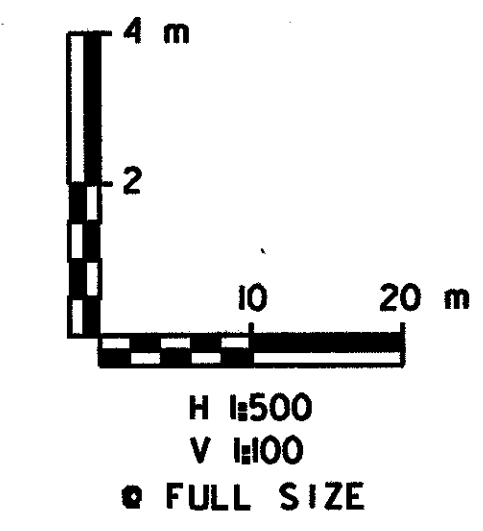

PROFILE VT. ROUTE 9	SURVEYED BY	C.H.A. & V.S.E.	DATE	12/93
	DESIGNED BY	D.E.G.	DATE	9/00
	DRAWN BY	J.S.L.	DATE	9/00
	CHECKED BY	T.P.K.	DATE	9/00
DESIGN FILE NO. /5116/prf20.dgn				
PROJ. NAME BENNINGTON - HOOSICK D.P.L. 0146(1) C/4				
PROJ. NO. P.I.N. 1306.60				
DWG NO. PF-1 SHEET 85 OF 385				