


FILE NAME = u:\5116\voat\contract4\vtprf22.dgn
DATE/TIME = 07 SEP 2000
USER = 1459

DATUM	
VERTICAL	NAVD 88
HORIZONTAL	NAD 83 (1992)

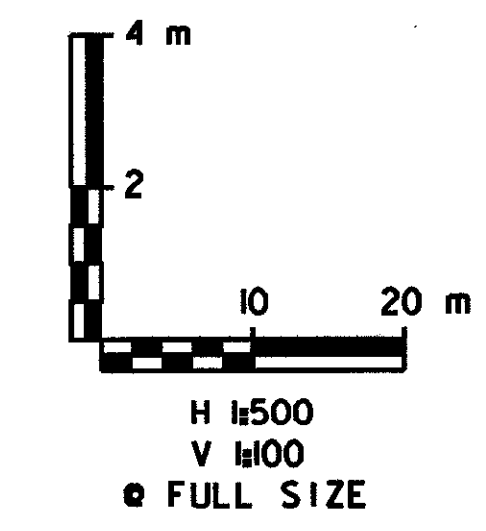

PROFILE VT. ROUTE 9

SURVEYED BY	C.H.A. & V.S.E.	DATE	12/93
DESIGNED BY	D.E.G.	DATE	9/00
DRAWN BY	J.S.L.	DATE	9/00
CHECKED BY	T.P.K.	DATE	9/00

DESIGN FILE NO. /5116/prf22.dgn

PROJ. NAME BENNINGTON - HOOSICK
D.P.L. 0146(I) C/4

PROJ. NO. P.I.N. 1306.60

DWG NO. PF-3 SHEET 87 OF 385