


FILE NAME = u:\5116\vaot\contract4\vtprf25.dgn  
 DATE/TIME = 07 SEP 2000  
 USER = 1469

DATUM	
VERTICAL	NAVD 88
HORIZONTAL	NAD 83 (1992)

SEE DWG. NO. PF-2  
 FOR VT. ROUTE 9 PROFILE

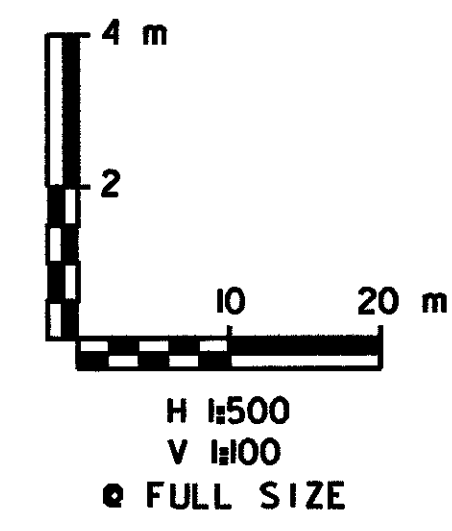

<b>PROFILE RAMP X</b>	SURVEYED BY	C.H.A. & V.S.E.	DATE	12/93
	DESIGNED BY	D.E.G.	DATE	9/00
	DRAWN BY	J.S.L.	DATE	9/00
	CHECKED BY	T.P.K.	DATE	9/00
DESIGN FILE NO. /5116/prf25.dgn				
PROJ. NAME BENNINGTON - HOOSICK D.P.J. 0146(C) C/4				
PROJ. NO. P.I.N. 1306.60				
DWG NO. PF-4 SHEET 88 OF 385				