


RAMP A

SEE DWG. NO. PF-2
FOR VT. ROUTE 9 PROFILE

SEE DWG. NO. PF-6
FOR RAMP AB PROFILE

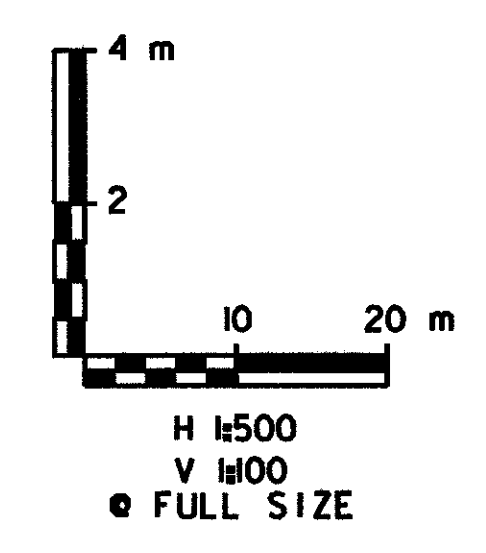

PROFILE RAMP A	SURVEYED BY	C.H.A. & V.S.E.	DATE	12/93
	DESIGNED BY	D.E.G.	DATE	9/00
	DRAWN BY	J.S.L.	DATE	9/00
	CHECKED BY	T.P.K.	DATE	9/00
DESIGN FILE NO. /5116/VAOT/prf28.dgn				
PROJ. NAME BENNINGTON - HOOSICK D.P.I. 0146(1) C/4				
PROJ. NO. P.J.N. 1306.60				
DWG NO. PF-7 SHEET 91 OF 385				

FILE NAME = u:\5116\vaot\contract4\vtprf28.dgn
DATE/TIME = 07 SEP 2000
USER = 1459

DATUM	
VERTICAL	NAVD 88
HORIZONTAL	NAD 83 (1992)