


FILE NAME = u:\5116\vaot\contract\vtprf30.dgn
 DATE/TIME = 07 SEP 2000
 USER = 1459

DATUM
 VERTICAL NAVD 88
 HORIZONTAL NAD 83 (1992)

SEE DWG. NO. PF-10
 FOR RAMP C PROFILE

SEE DWG. NO. PF-II
 FOR RAMP D PROFILE

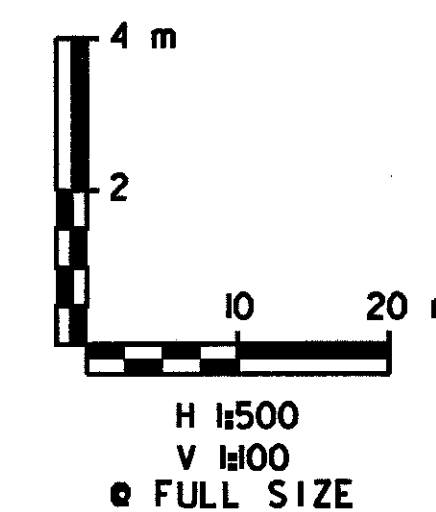

**PROFILE
 RAMP CD**

SURVEYED BY	C.H.A. & V.S.E.	DATE	12/93
DESIGNED BY	D.E.G.	DATE	9/00
DRAWN BY	J.S.L.	DATE	9/00
CHECKED BY	T.P.K.	DATE	9/00

DESIGN FILE NO. /5116/VAOT/VTprf30.dgn
 PROJ. NAME BENNINGTON - HOOSICK
 D.P.J. 0146(I) C/4
 PROJ. NO. P.I.N. 1306.60
 DWG NO. PF-9 SHEET 93 OF 385