


FILE NAME = u:\5116\root\contract4\trpf32.dgn
 DATE/TIME = 07 SEP 2000
 USER = 1459

DATUM	
VERTICAL	NAVD 88
HORIZONTAL	NAD 83 (1992)

SEE DWG. NO. PF-9
 FOR RAMP CD PROFILE

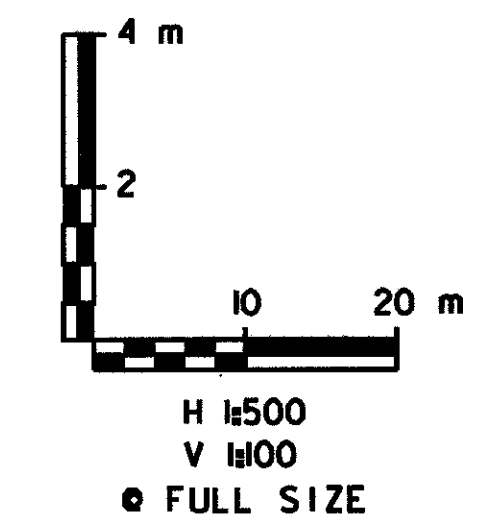

PROFILE RAMP D	SURVEYED BY	C.H.A. & V.S.E.	DATE	12/93
	DESIGNED BY	D.E.G.	DATE	9/00
	DRAWN BY	J.S.L.	DATE	9/00
	CHECKED BY	T.P.K.	DATE	9/00
DESIGN FILE NO. /5116/prf32.dgn				
PROJ. NAME BENNINGTON - HOOSICK D.P.I. 0146(II) C/4				
PROJ. NO. P.I.N. 1306.60				
DWG NO. PF-II SHEET 95 OF 385				