

BEGIN FULL-DEPTH RECONSTRUCTION
STA. CD10+028.800

VT. ROUTE 67A



CD10+100

RAMP CD

177.5 m

177.5 m

177.5 m

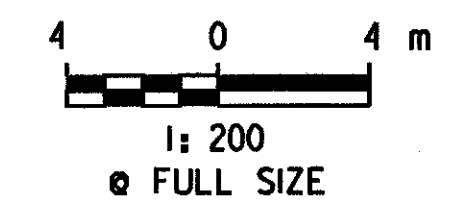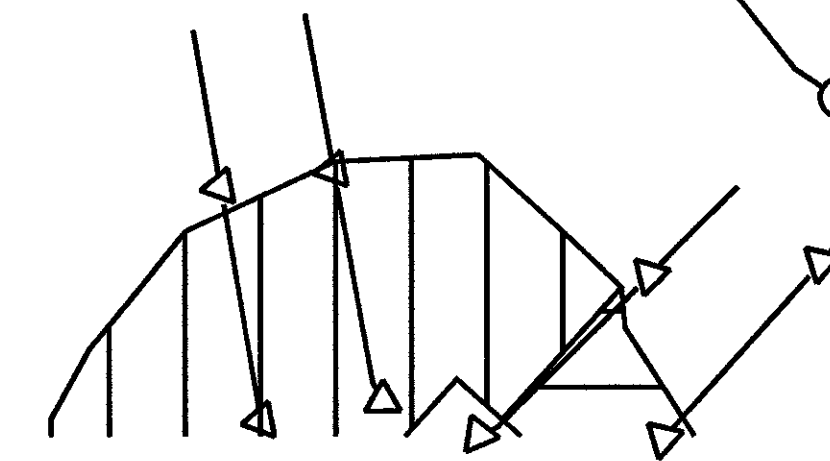

**VT. ROUTE 67A
/ RAMP CD
GRADING
PLAN**

SURVEYED BY	C.H.A. & V.S.E.	DATE	12/93
DESIGNED BY	D.E.G.	DATE	9/00
DRAWN BY	K.H.D.	DATE	9/00
CHECKED BY	T.P.K.	DATE	9/00
DESIGN FILE NO.	/516/VAOT/GPI.DGN		
PROJ. NAME	BENNINGTON - HOOSICK D.P.I. 0146(1) C/4		
PROJ. NO.	P.L.N. 1306.60		
DWG NO.	GP-1	SHEET	96 OF 385

DATUM	
VERTICAL	NAVD 88
HORIZONTAL	NAD 83 (1992)

FILE NAME = u:\5116\vaot\contract4\gpi.dgn
DATE/TIME = 09 SEP 2000
USER = J493