


FILE NAME = \\5116\vaot\contract4\gp2.dgn  
 DATE/TIME = 08 SEP 2000  
 USER = J459

<b>DATUM</b>	
VERTICAL	NAVD 88
HORIZONTAL	NAD 83 (1992)

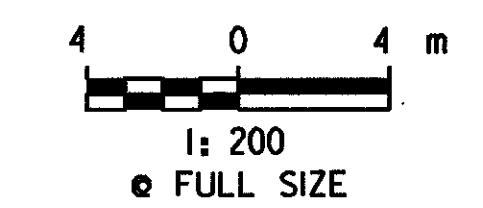

**VT. ROUTE 67A  
 / RAMP AB  
 GRADING  
 PLAN**

SURVEYED BY	C.H.A. & V.S.E.	DATE	12/93
DESIGNED BY	D.E.G.	DATE	9/00
DRAWN BY	K.H.D	DATE	9/00
CHECKED BY	T.P.K.	DATE	9/00
DESIGN FILE NO.	5116/vaot/GP2.DGN		
PROJ. NAME	BENNINGTON - HOOSICK D.P.I. 0146(1) C/4		
PROJ. NO.	P.I.N 1306.60		
DWG NO.	GP-2	SHEET	97 OF 385