


ALL ITEM 621.90 TEMPORARY TRAFFIC BARRIER (CONCRETE MEDIAN BARRIER) (MOD.) SHOWN ON THIS SHEET WILL BECOME THE PROPERTY OF THE AGENCY AT THE CLOSE OF THIS CONTRACT. THIS CONCRETE MEDIAN BARRIER SHALL REMAIN IN PLACE UNTIL VT. ROUTE 9 IS OPEN TO TRAFFIC DURING THE BENNINGTON - HOOSICK D.P.J. 0146(II) C/1 CONTRACT. THE BENNINGTON - HOOSICK D.P.J. 0146(II) C/1 CONTRACTOR SHALL REMOVE THIS TRAFFIC BARRIER. THE COST OF THIS WORK SHALL BE INCIDENTAL TO THE OTHER ITEMS IN THE BENNINGTON - HOOSICK D.P.J. 0146(II) C/1 CONTRACT.

LEGEND	
	ITEM 621.90 TEMPORARY TRAFFIC BARRIER (CONCRETE MEDIAN BARRIER)
	CONSTRUCTION SIGN
	PERMANENT SIGN (AS PER DWG. NOS. SSP-3, SSP-5 AND SSP-6)
	TYPE III BARRICADE
	REFLECTORIZED PLASTIC DRUM
	EXISTING SIGN
	TRAVEL LANE DIRECTION
	COVER SIGN FACE (OR PORTION THEREOF)

VT. ROUTE 67A / PROPOSED RAMP CD

DATUM	
VERTICAL	NAVD 88
HORIZONTAL	NAD 83 (1992)

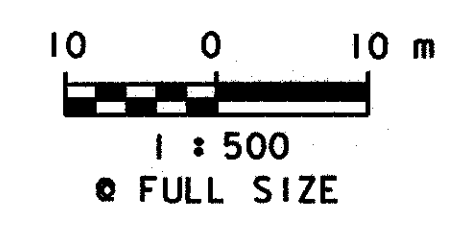

CONSTRUCTION SEQUENCING PHASE 4	SURVEYED BY	C.H.A. & V.S.E.	DATE	12/93
	DESIGNED BY	T.Y.B.	DATE	9/00
	DRAWN BY	K.H.D.	DATE	9/00
	CHECKED BY	T.P.K.	DATE	9/00
	DESIGN FILE NO.	5116/YAOT/CSP/CSP-10.DGN		
PROJ. NAME	BENNINGTON - HOOSICK D.P.J. 0146(II) C/4			
PROJ. NO.	P.I.N 1306.60			
DWG NO.	CSP-II	SHEET	108 OF 385	

FILE NAME = u:\5116\vaot\contract4\csp\csp-10.dgn
 DATE/TIME = 07 SEP 2000
 USER = 1459