


**PROPOSED SANITARY SEWER**

FILE NAME = su\5116\voct\contract4\sanddet1.dgn  
 DATE/TIME = 07 SEP 2000  
 USER = 1459

DATUM	
VERTICAL	NAVD 88
HORIZONTAL	NAD 83 (1992)

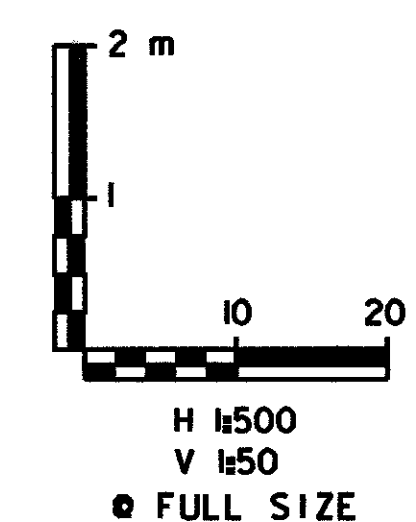

**PROPOSED  
 SANITARY  
 SEWER  
 PROFILE**

SURVEYED BY	C.H.A. & V.S.E.	DATE	12/93
DESIGNED BY	D.E.G.	DATE	9/00
DRAWN BY	J.N.	DATE	9/00
CHECKED BY	T.P.K.	DATE	9/00
DESIGN FILE NO.	SANDET1.DGN		
PROJ. NAME	BENNINGTON - HOOSICK D.P.I. 0146(1) C/4		
PROJ. NO.	P.I.N. 1306.60		
DWG NO.	SS-2	SHEET	129 OF 385