



COLOR: WHITE BORDER & TEXT (REFLECTORIZED)
GREEN BACKGROUND (REFLECTORIZED)

MATERIAL: PER VAOT STANDARD E-123M
SIGN - VT. ROUTE 9, RAMPS AB & CD
STA. AB10+140.0, LT
STA. CD10+130.0, LT

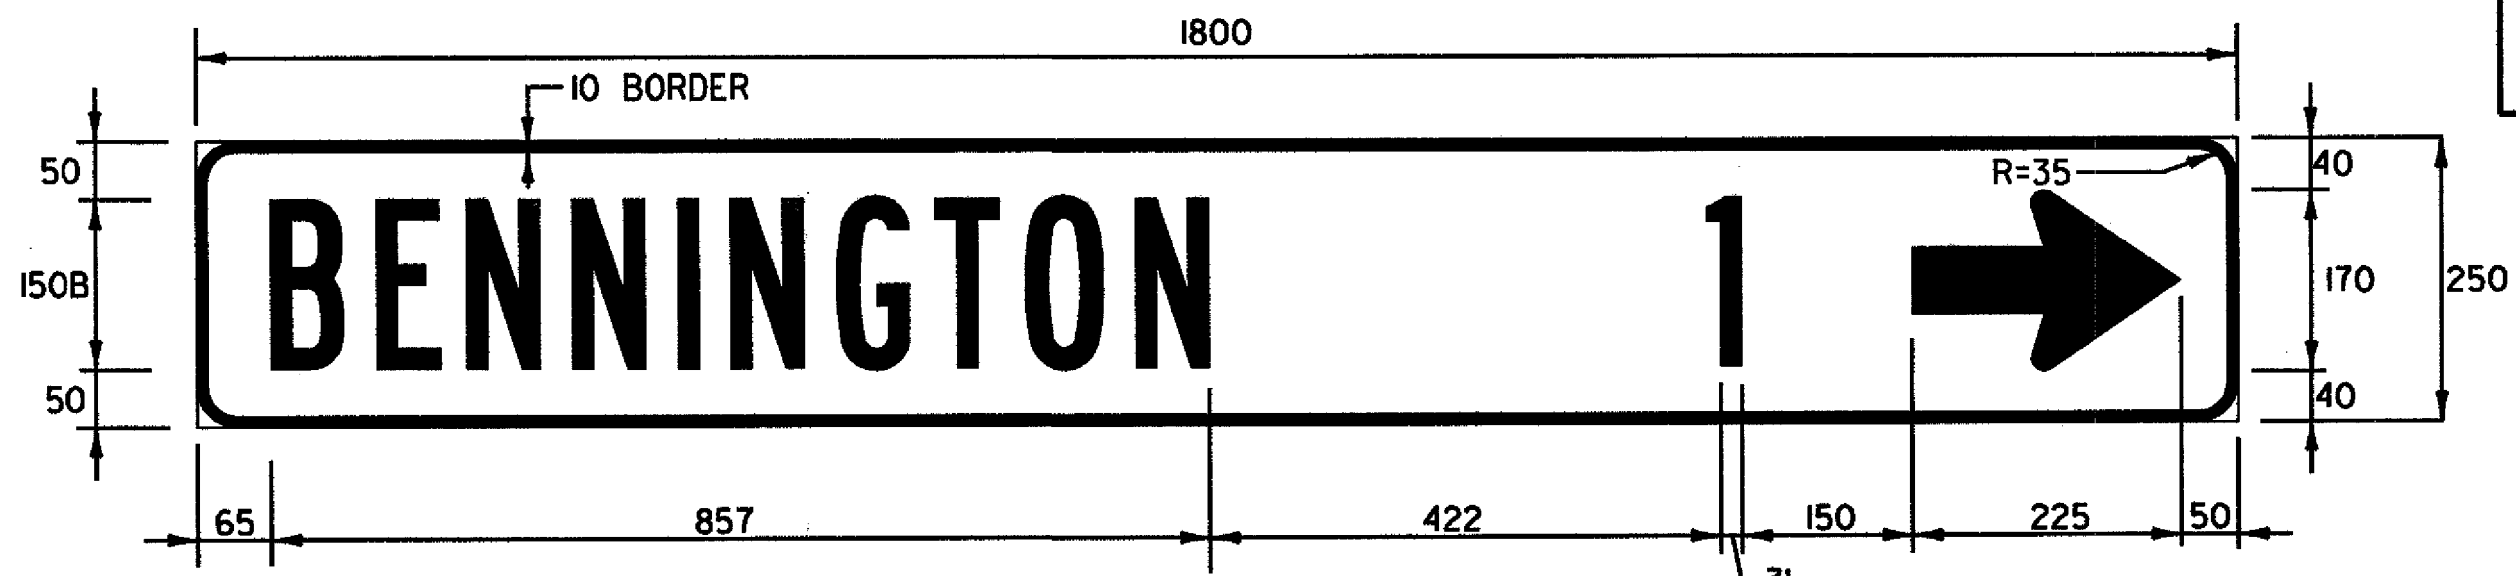


COLOR: WHITE BORDER & TEXT (REFLECTORIZED)
GREEN BACKGROUND (REFLECTORIZED)

MATERIAL: PER VAOT STANDARD E-123M
SIGN - VT. ROUTE 9, RAMPS AB & CD
STA. AB10+140.0, LT
STA. CD10+130.0, LT

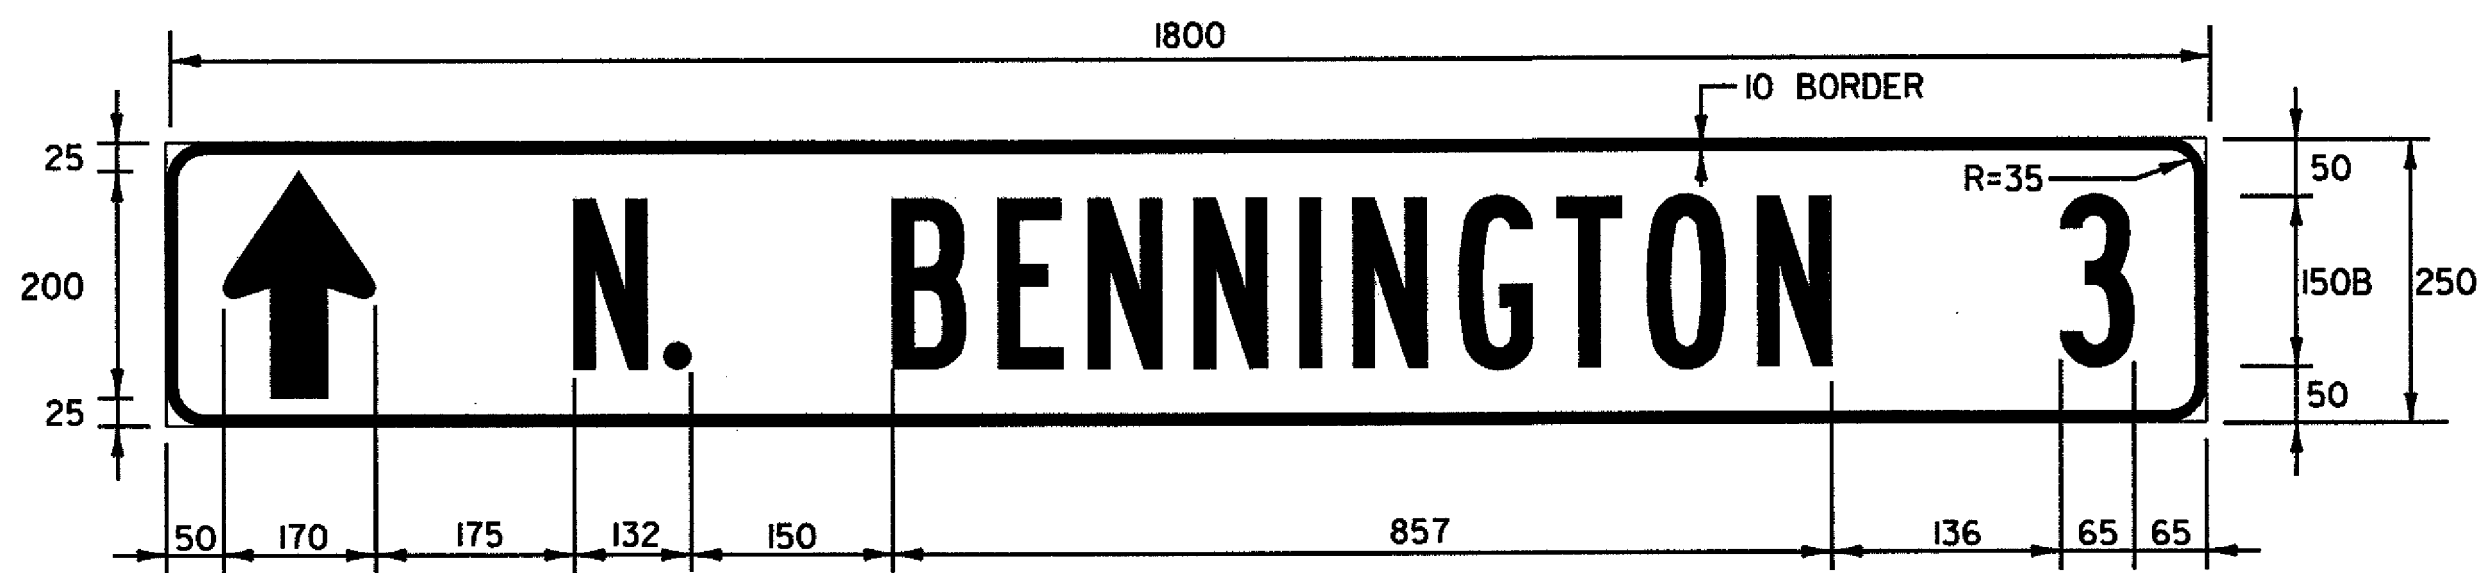


COLOR: WHITE BORDER & TEXT (REFLECTORIZED)
GREEN BACKGROUND (REFLECTORIZED)

MATERIAL: PER VAOT STANDARD E-123M
SIGN - VT. ROUTE 67A
STA. 60+670.0, RT
STA. 60+900.0, RT
STA. 61+244.1, RT

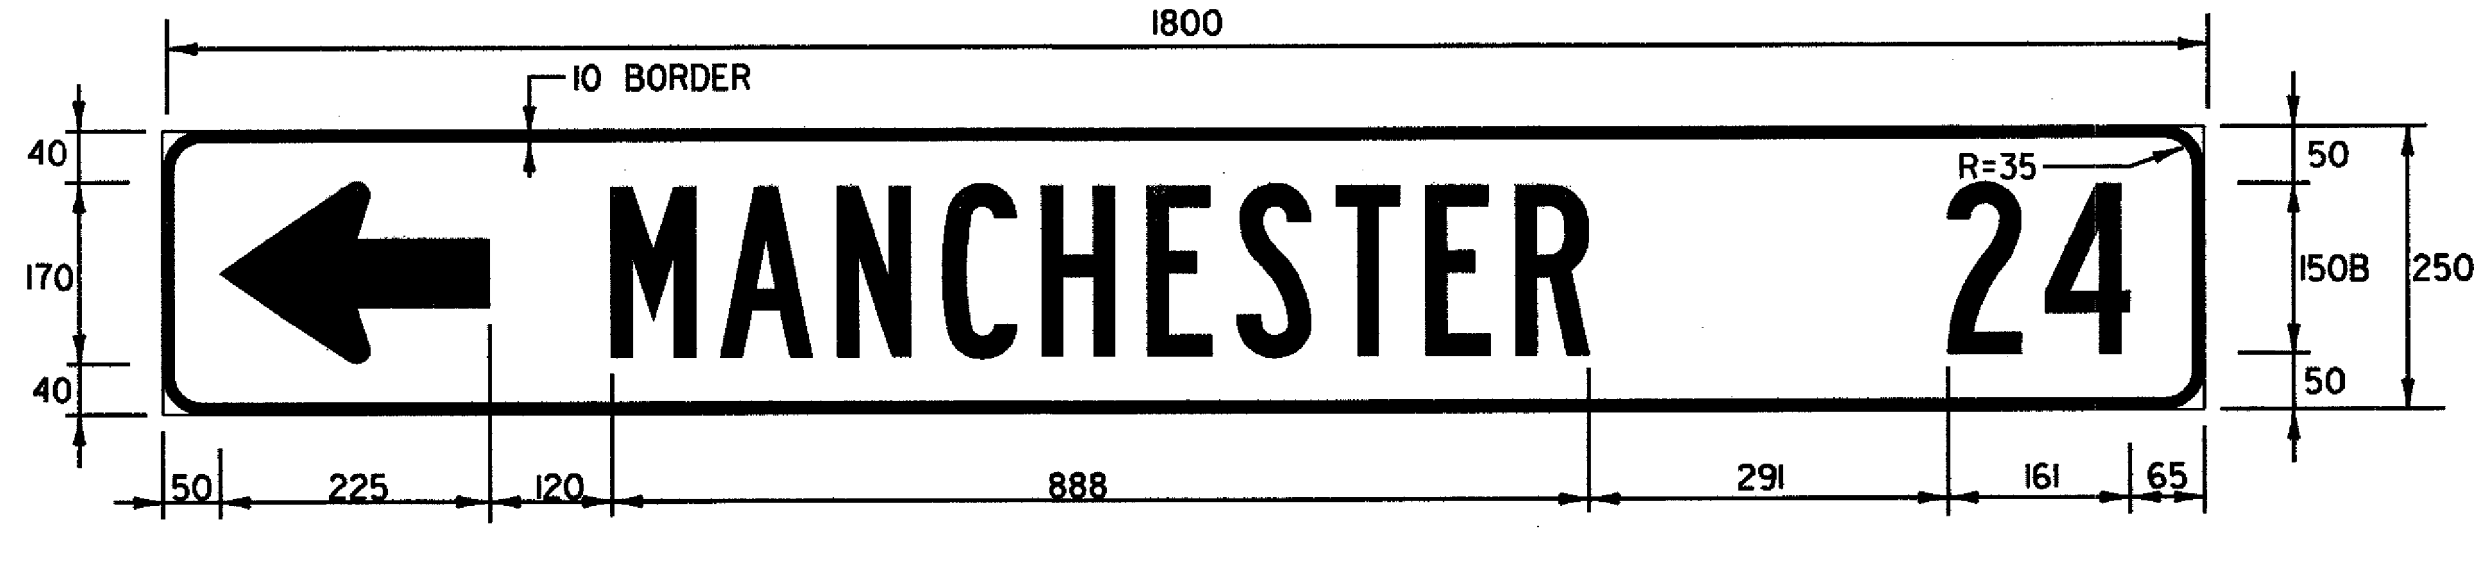


COLOR: WHITE BORDER & TEXT (REFLECTORIZED)
GREEN BACKGROUND (REFLECTORIZED)

MATERIAL: PER VAOT STANDARD E-123M
SIGN - VT. ROUTE 67A
STA. 60+670.0, RT

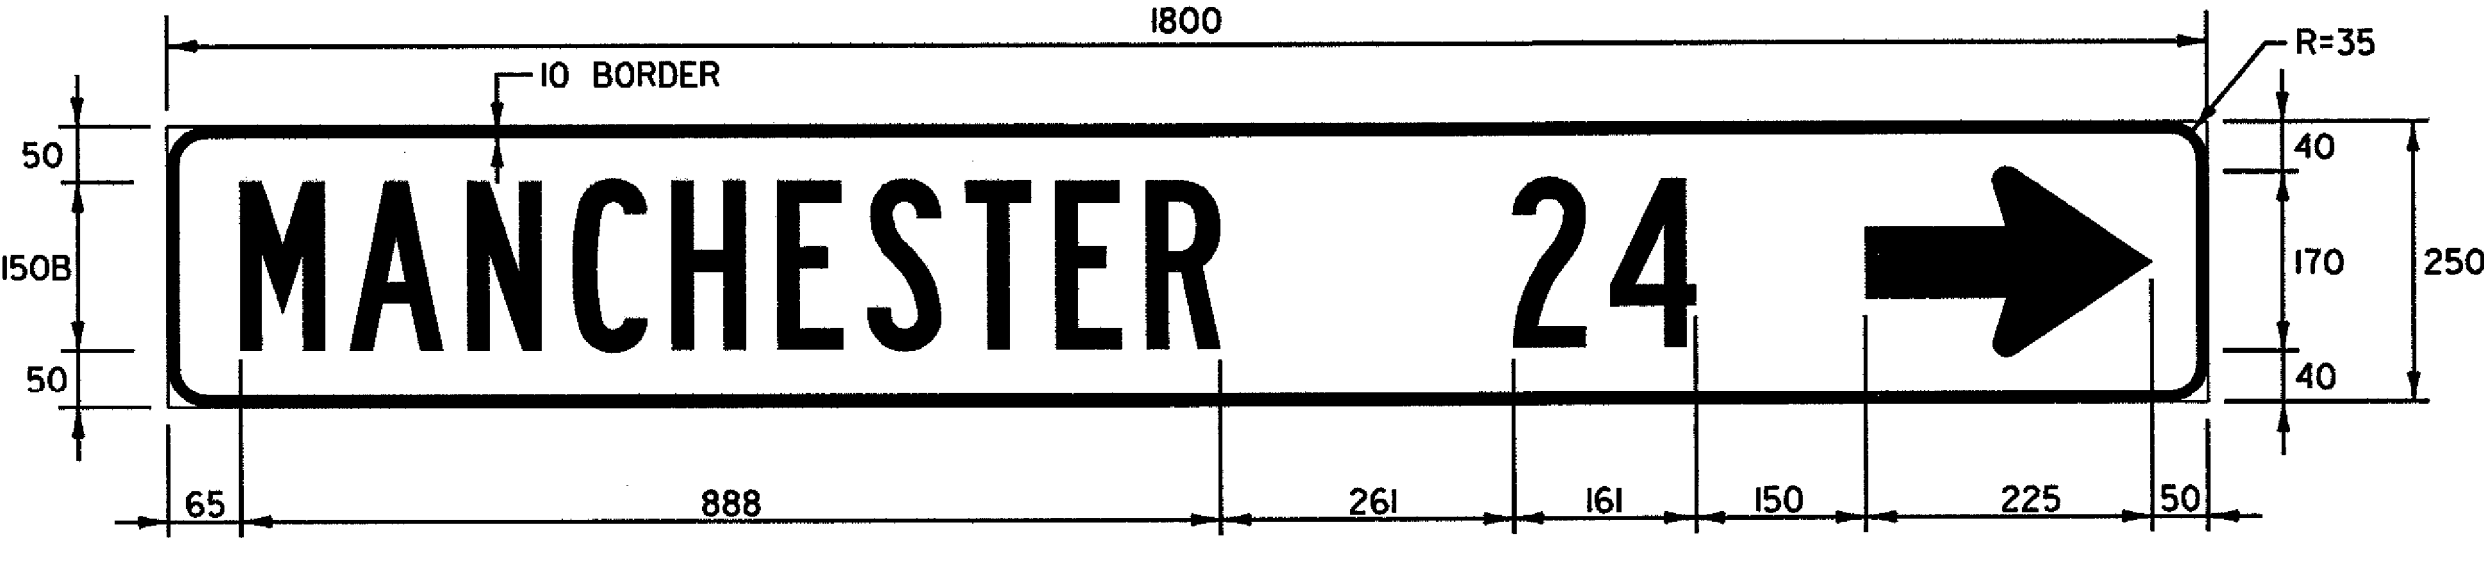


COLOR: WHITE BORDER & TEXT (REFLECTORIZED)
GREEN BACKGROUND (REFLECTORIZED)

MATERIAL: PER VAOT STANDARD E-123M
SIGN - VT. ROUTE 67A
STA. 60+910.0, LT

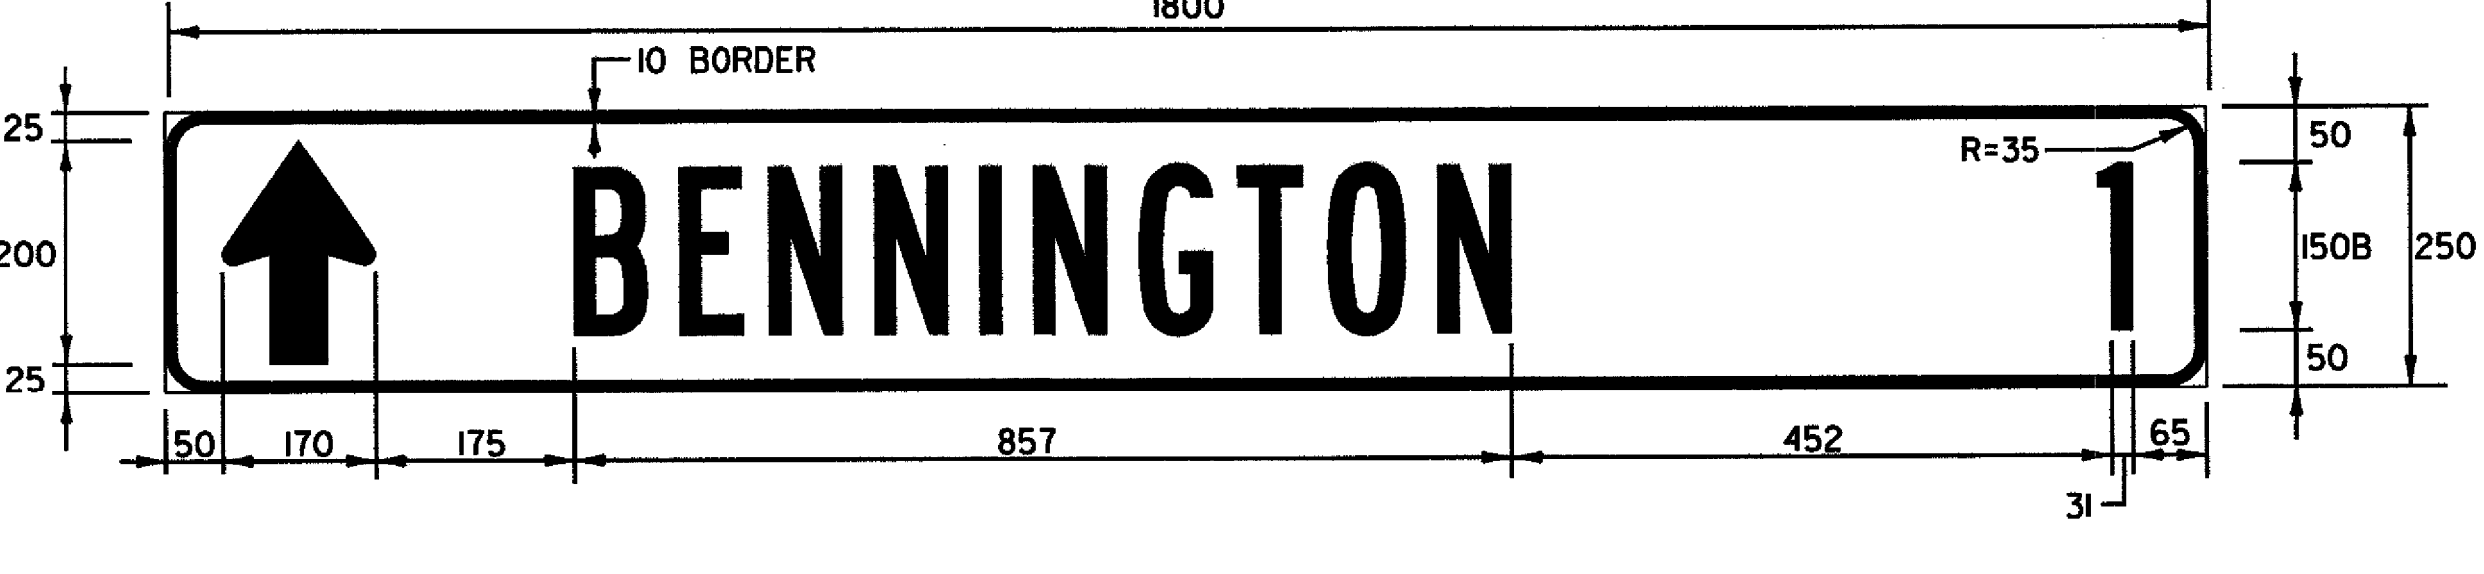


COLOR: WHITE BORDER & TEXT (REFLECTORIZED)
GREEN BACKGROUND (REFLECTORIZED)

MATERIAL: PER VAOT STANDARD E-123M
SIGN - VT. ROUTE 67A
STA. 60+910.0, LT

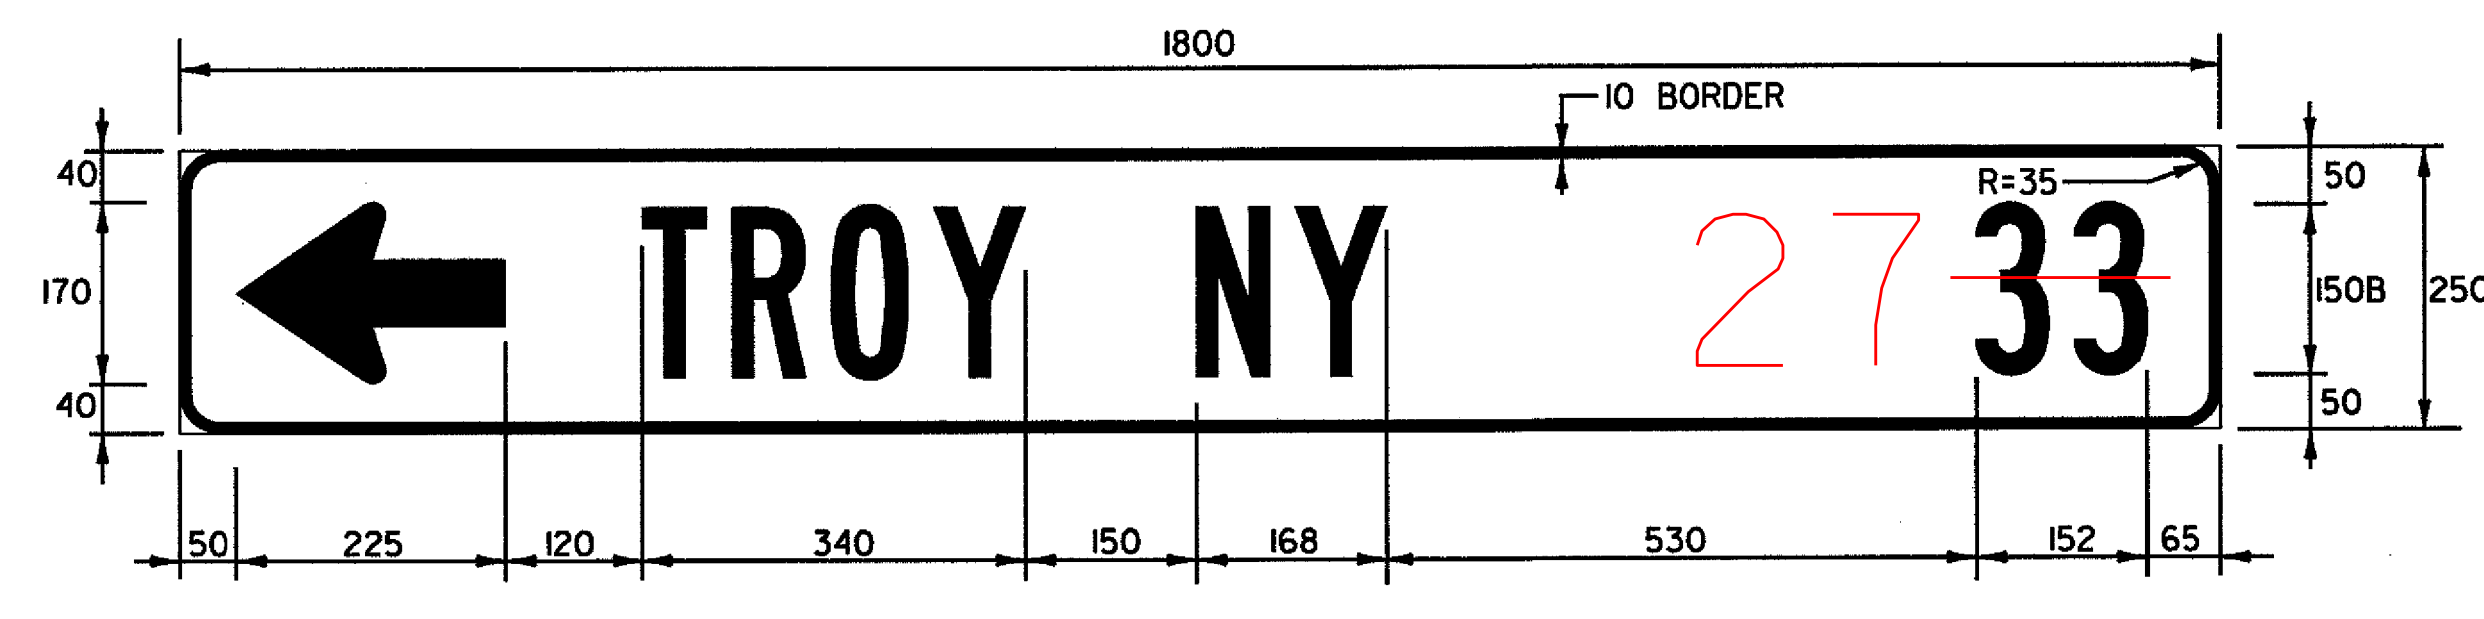

COLOR: WHITE BORDER & TEXT (REFLECTORIZED)
GREEN BACKGROUND (REFLECTORIZED)

MATERIAL: PER VAOT STANDARD E-123M
SIGN - VT. ROUTE 67A
STA. 60+900.0, RT

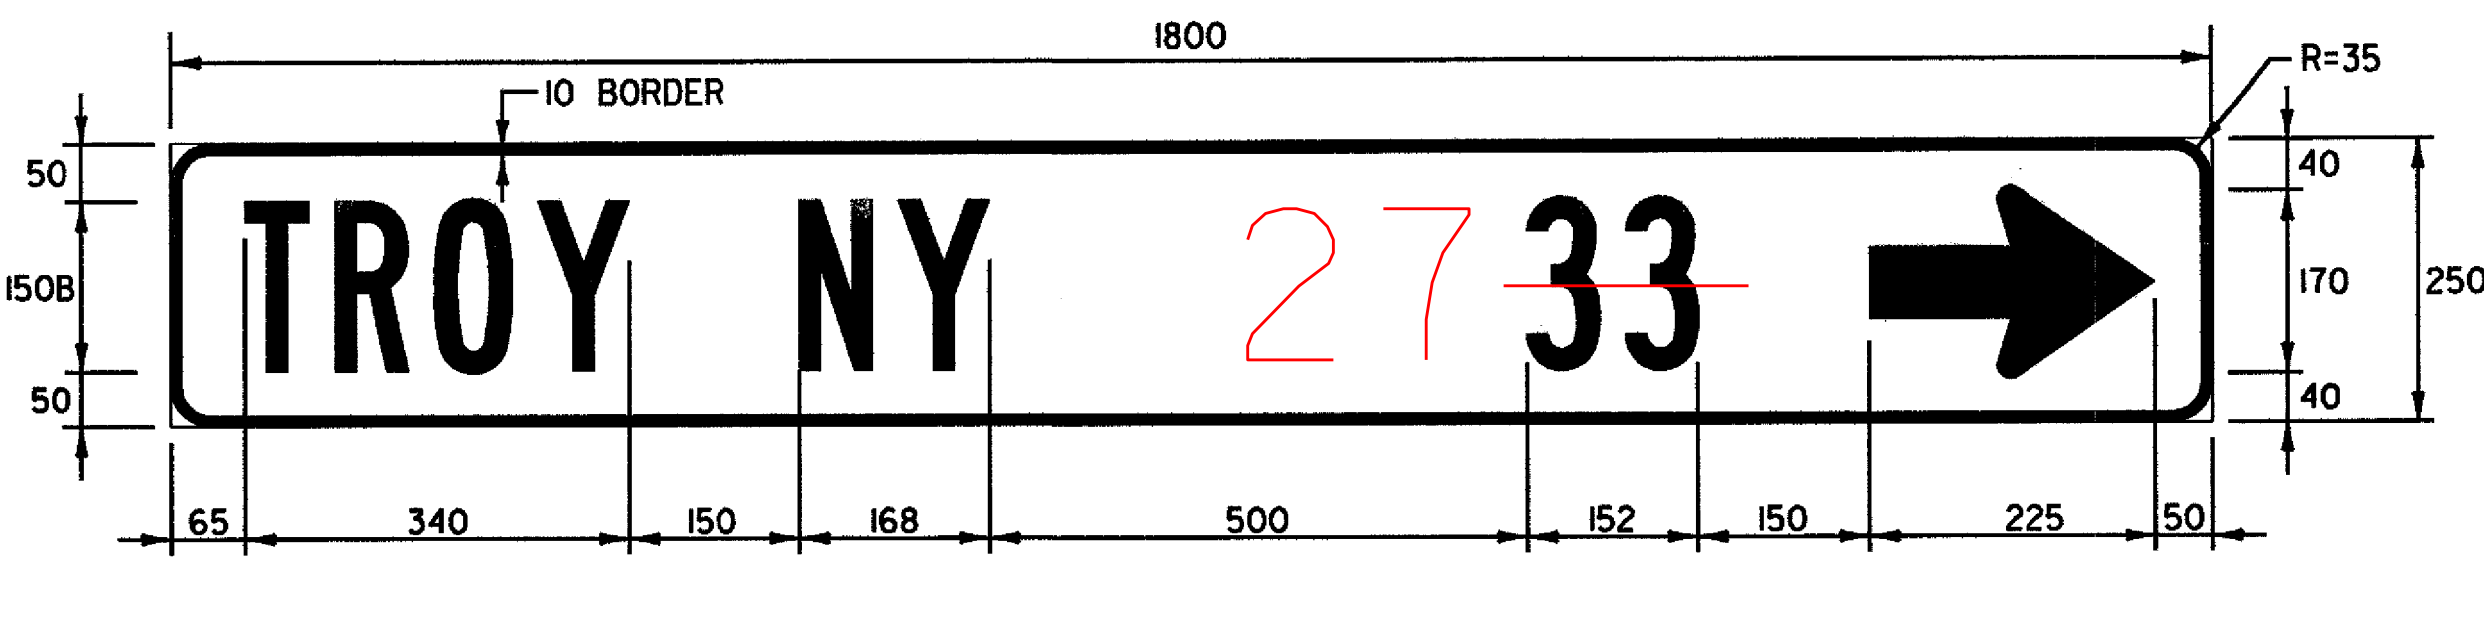

COLOR: WHITE BORDER & TEXT (REFLECTORIZED)
GREEN BACKGROUND (REFLECTORIZED)

MATERIAL: PER VAOT STANDARD E-123M
SIGN - VT. ROUTE 67A
STA. 61+245.0, LT

ALL DIMENSIONS IN MILLIMETERS UNLESS OTHERWISE NOTED.

SURVEYED BY C.H.A. & V.S.E. DATE 12/93
DESIGNED BY D.E.G. DATE 9/00
DRAWN BY K.H.D. DATE 9/00
CHECKED BY T.P.K. DATE 9/00

**TRAFFIC SIGN
DETAIL
SHEET 3**

DESIGN FILE NO. /5116/5116SIGN.DGN
PROJ. NAME BENNINGTON - HOOSICK
D.P.J. 0146(i) C/4
PROJ. NO. P.I.N. 1306.60
DWG NO. TSD-3 SHEET 158 OF 385

TEXT LAYOUT DIMENSIONS ARE BASED ON THE "LETTER & NUMERAL WIDTHS AND SPACE" TABLES FOUND IN THE "STANDARD HIGHWAY SIGNS" BOOKLET. MINOR VARIATIONS IN TEXT DIMENSIONS ARE ACCEPTABLE BASED ON INDIVIDUAL MANUFACTURER'S LETTER FABRICATION. SIGNIFICANT CHANGES WHICH AFFECT SIGN APPEARANCE SHALL BE BROUGHT TO THE ATTENTION OF THE VAOT'S TRAFFIC & SAFETY DIVISION BEFORE FABRICATION.

FILE NAME: us\5116\veot\contract4\5116sign.dgn
DATE/TIME: 07 SEP 2000
USER: 1459

DATUM	
VERTICAL	NAVD 88
HORIZONTAL	NAD 83 (1992)