

676.10 DELINEATORS W/ STEEL POSTS
AS SHOWN - 67

TYPE II, DOUBLE WHITE	TYPE I, WHITE	TYPE I, AMBER
STA. AIO+132.6 RT	STA. ABIO+125.3 RT	STA. BIO+220.0 LT
STA. BIO+160.0 RT	STA. ABIO+137.3 RT	STA. BIO+230.0 LT
STA. BIO+190.0 RT	STA. ABIO+149.3 RT	STA. BIO+240.0 LT
STA. CIO+061.9 RT	STA. ABIO+161.3 RT	STA. BIO+250.0 LT
	STA. ABIO+173.3 RT	STA. BIO+260.0 LT
	STA. ABIO+185.3 RT	STA. BIO+270.0 LT
	STA. AIO+000.7 RT	STA. BIO+280.0 LT
	STA. AIO+025.0 RT	STA. BIO+290.0 LT
	STA. AIO+005.8 RT	STA. BIO+300.0 LT
	STA. AIO+028.3 RT	STA. BIO+310.0 LT
	STA. AIO+050.0 RT	STA. BIO+320.0 LT
	STA. XIO+102.0 RT	STA. ABIO+192.8 C
	STA. XIO+132.0 RT	STA. ABIO+182.8 C
	STA. XIO+162.0 RT	STA. ABIO+172.8 C
	STA. XIO+192.0 RT	STA. ABIO+162.8 C
	STA. XIO+222.0 RT	STA. ABIO+152.8 C
	STA. XIO+252.0 RT	STA. ABIO+142.8 C
	STA. YIO+080.0 LT	STA. ABIO+132.8 C
	STA. YIO+110.0 LT	STA. ABIO+122.8 C
	STA. YIO+140.0 LT	
	STA. YIO+170.0 LT	

676.10 DELINEATORS W/ STEEL POSTS (MOD.)
AS SHOWN - 4


TYPE II, DOUBLE WHITE
STA. I6+970.0 LT
STA. AIO+162.6 RT
STA. CIO+001.9 RT
STA. CIO+031.9 RT

DELINEATOR LEGEND

○	TYPE I, WHITE
●	TYPE I, AMBER
⊖	TYPE II, DOUBLE WHITE
⊕	TYPE III, WHITE W/ RED ON BACK
⊗	TYPE III, AMBER W/ RED ON BACK

DATUM

VERTICAL	NAVD 88
HORIZONTAL	NAD 83 (1992)

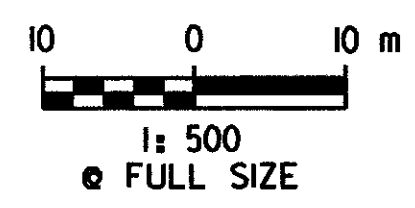

DELINEATOR SHEET 2

SURVEYED BY	C.H.A. & V.S.E.	DATE	12/93
DESIGNED BY	D.E.G.	DATE	9/00
DRAWN BY	K.H.D.	DATE	9/00
CHECKED BY	T.P.K.	DATE	9/00
DESIGN FILE NO.	/5116/SPP2L.DGN		
PROJ. NAME	BENNINGTON - HOOSICK D.P.J. 0146(1) C/4		
PROJ. NO.	P.I.N. 1306.60		
DWG NO. DDS-2	SHEET 160 OF 385		

FILE NAME = \\5116\user\contract4\vtssp2l.dgn
 DATE/TIME = 08 SEP 2000
 USER = 1459