
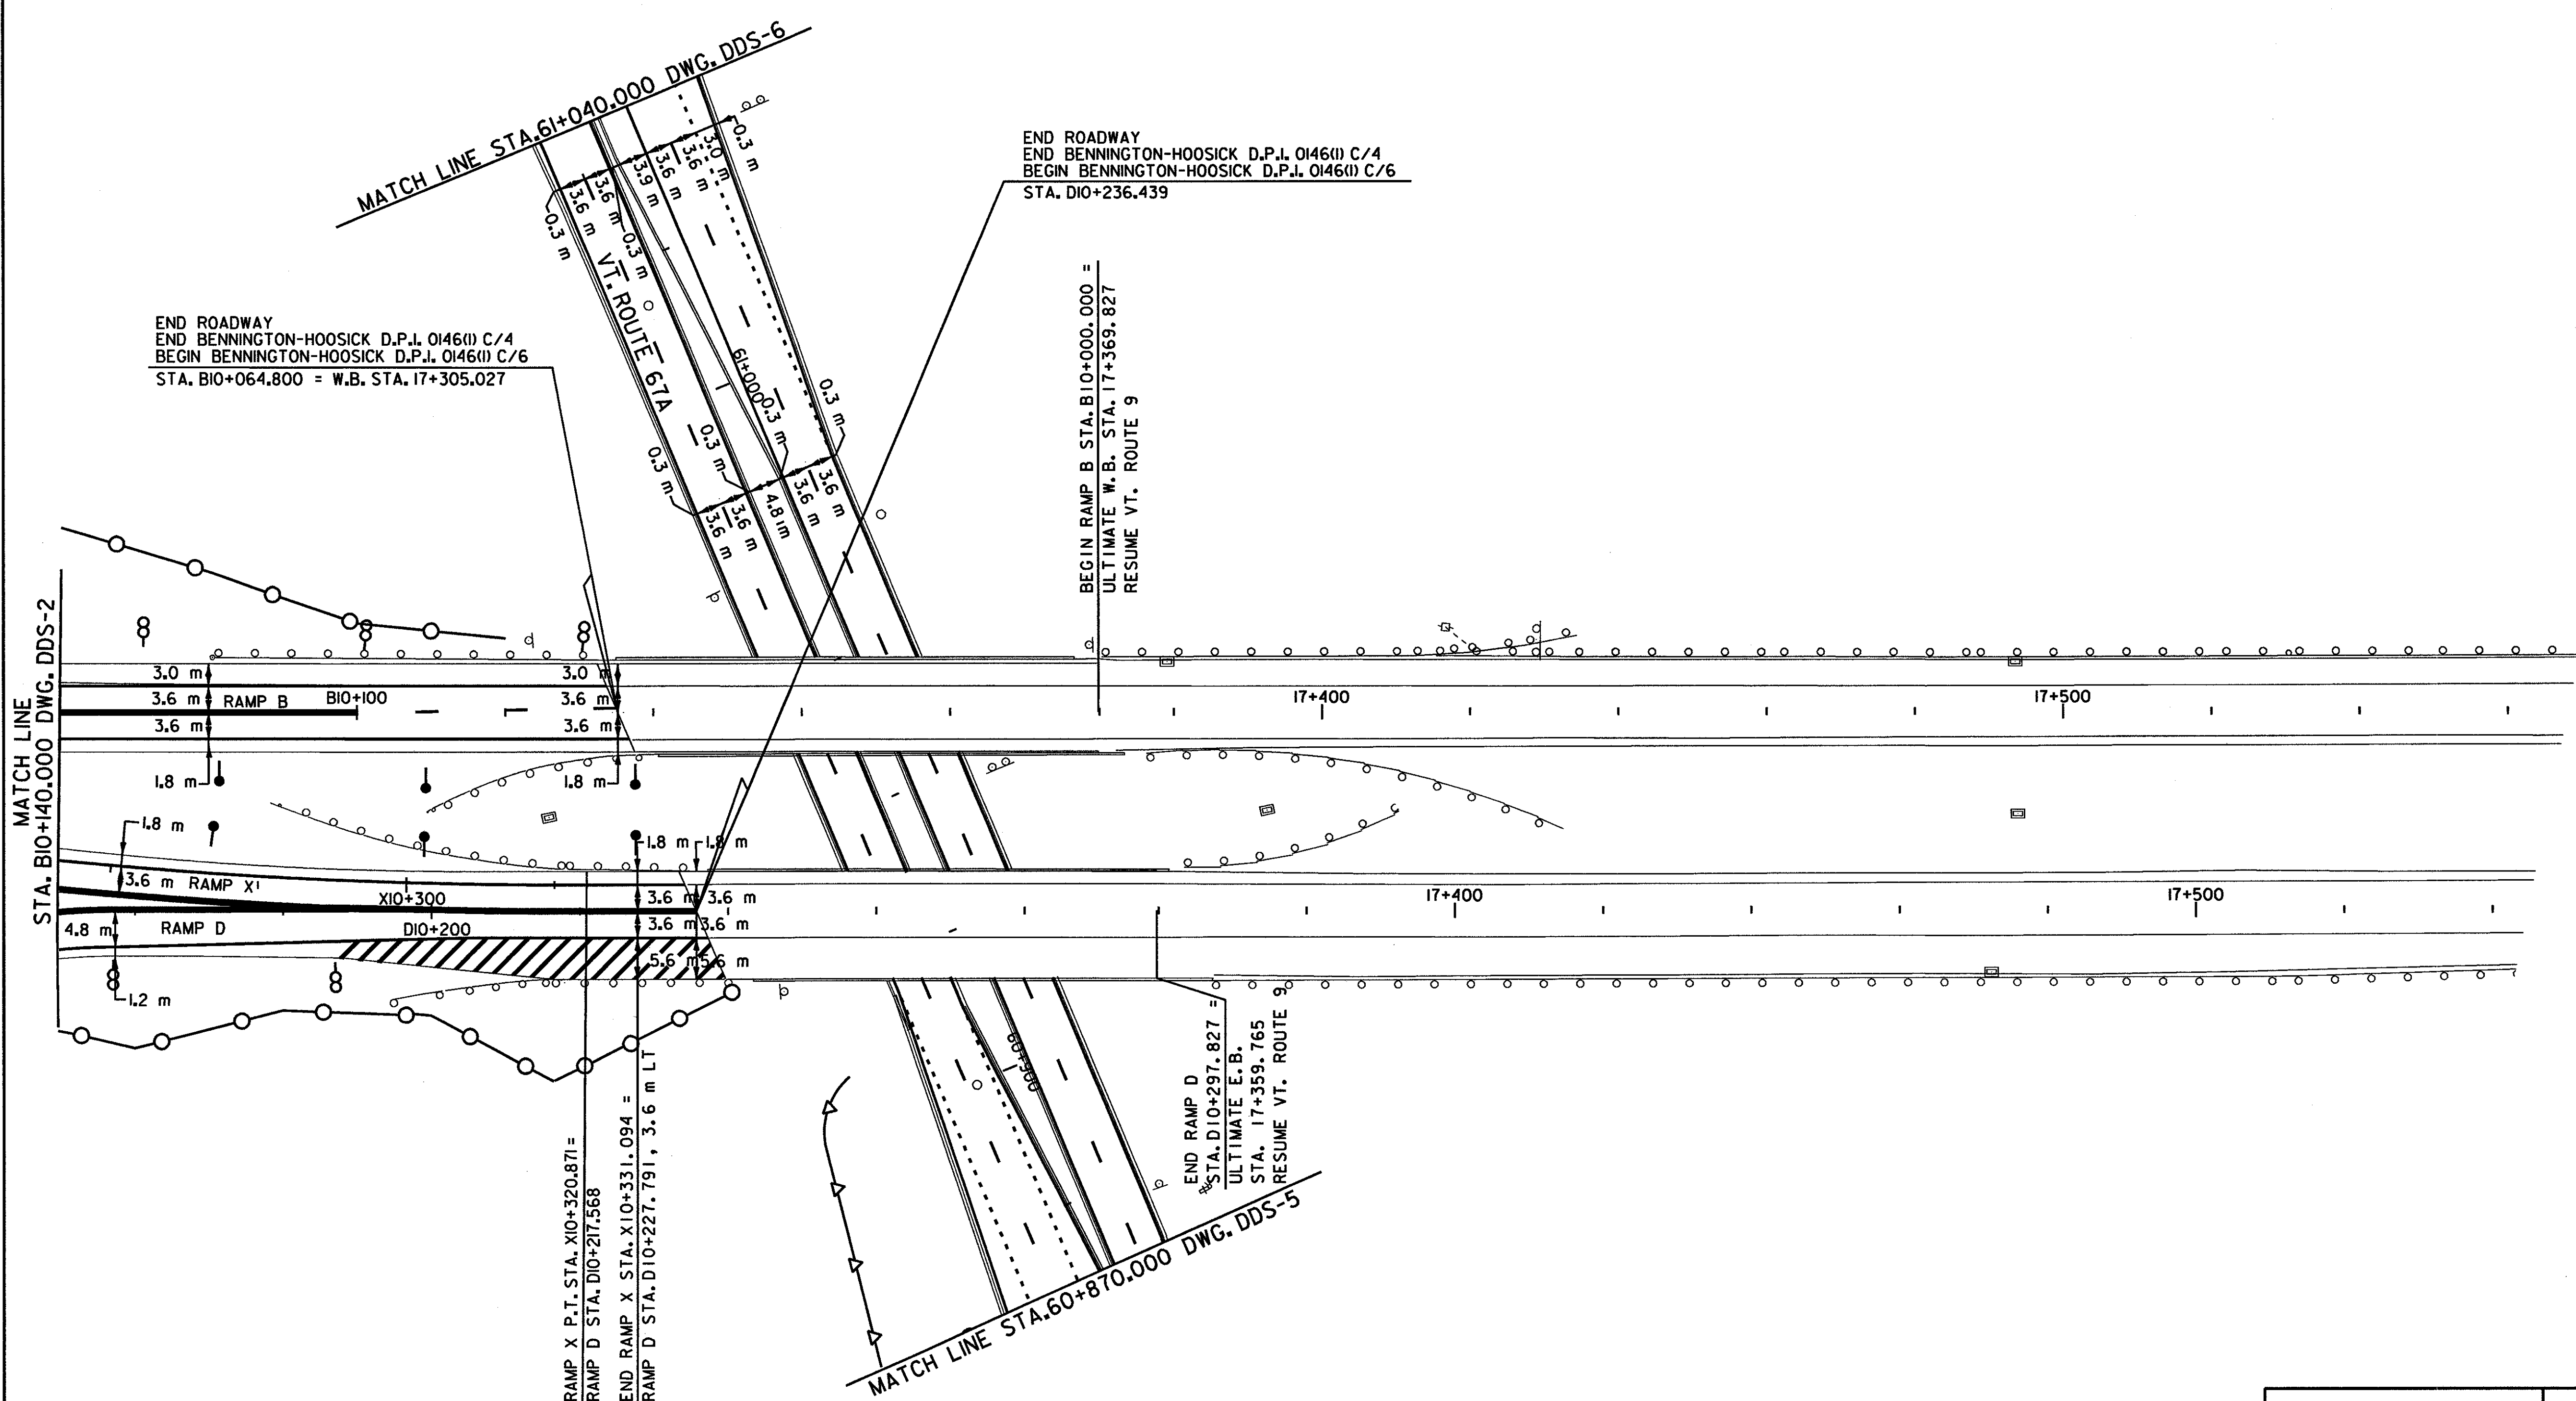



676.10 DELINEATORS W/ STEEL POSTS
AS SHOWN - II

- | | |
|---|---|
| <p>8 TYPE II, DOUBLE WHITE</p> <p>STA. BIO+070.0 RT
STA. BIO+100.0 RT
STA. BIO+130.0 RT
STA. DIO+157.0 RT
STA. DIO+187.0 RT</p> | <p>1 TYPE I, AMBER</p> <p>STA. BIO+063.0 LT
STA. BIO+093.0 LT
STA. BIO+123.0 LT
STA. XIO+331.0 LT
STA. XIO+301.0 LT
STA. XIO+271.0 LT</p> |
|---|---|

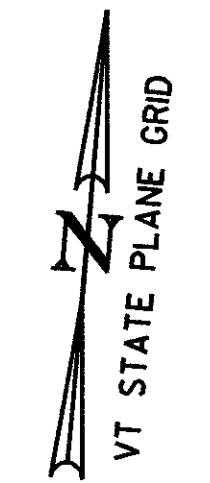

DATUM	
VERTICAL	NAVD 88
HORIZONTAL	NAD 83 (1992)

- DELINEATOR LEGEND**
- TYPE I, WHITE
 - TYPE I, AMBER
 - ⊖ TYPE II, DOUBLE WHITE
 - ⊕ TYPE III, WHITE W/ RED ON BACK
 - ⊗ TYPE III, AMBER W/ RED ON BACK

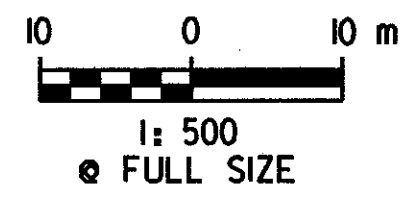

<h3>DELINEATOR DETAIL SHEET 3</h3>	SURVEYED BY <u>C.H.A. & V.S.E.</u> DATE <u>12/93</u> DESIGNED BY <u>D.E.G.</u> DATE <u>9/00</u> DRAWN BY <u>J.S.L.</u> DATE <u>9/00</u> CHECKED BY <u>T.P.K.</u> DATE <u>9/00</u>
	DESIGN FILE NO. <u>/5116/SSP22.DGN</u>
	PROJ. NAME <u>BENNINGTON - HOOSICK</u> D.P.I. <u>0146(1) C/4</u>
	PROJ. NO. <u>P.I.N. 1306.60</u>
	DWG NO. <u>DDS-3</u> SHEET <u>161 OF 385</u>

FILE NAME = \\E116\...Contract4\vtssp22.dgn
 DATE / TIME = 09 SEP 2000
 USER = JLS