


FRAMING PLAN - SPAN 3

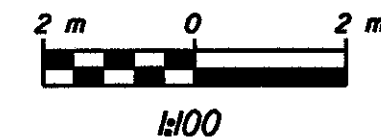

DIAPHRAGM SPACING TABLE	
GIRDER NO.	DIAPHRAGM SPACING (m)
1	9 EQ.SP. = 46.696
2	10 EQ.SP. = 51.987
3	10 EQ.SP. = 52.093
4	10 EQ.SP. = 52.196
5	9 EQ.SP. = 47.071
6	9 EQ.SP. = 47.166
7	9 EQ.SP. = 47.260
8	9 EQ.SP. = 47.354

**STATE OF VERMONT
AGENCY OF TRANSPORTATION**

Town of BENNINGTON	Bridge No. BR700
Highway No. VT. RTE. 9	Log Sta. 16+800
VT. RTE. 9 OVER SILK ROAD AND WALLOOMSAC RIVER	
FRAMING PLAN - SPAN 3	
Designed By D. VIENI	Drawn by B. WEATHERBY
Checked By M. SCARDINO 6/00	Bridge Design Supervisor M.W. OLSTAD Date 9/00
PROJECT BENNINGTON-HOOSICK	PROJECT NO. D.P.J. 0146(1) C/4
I.C.C. Info.	
Bridge Sheet No. BR721	Sheet 204 OF 385