

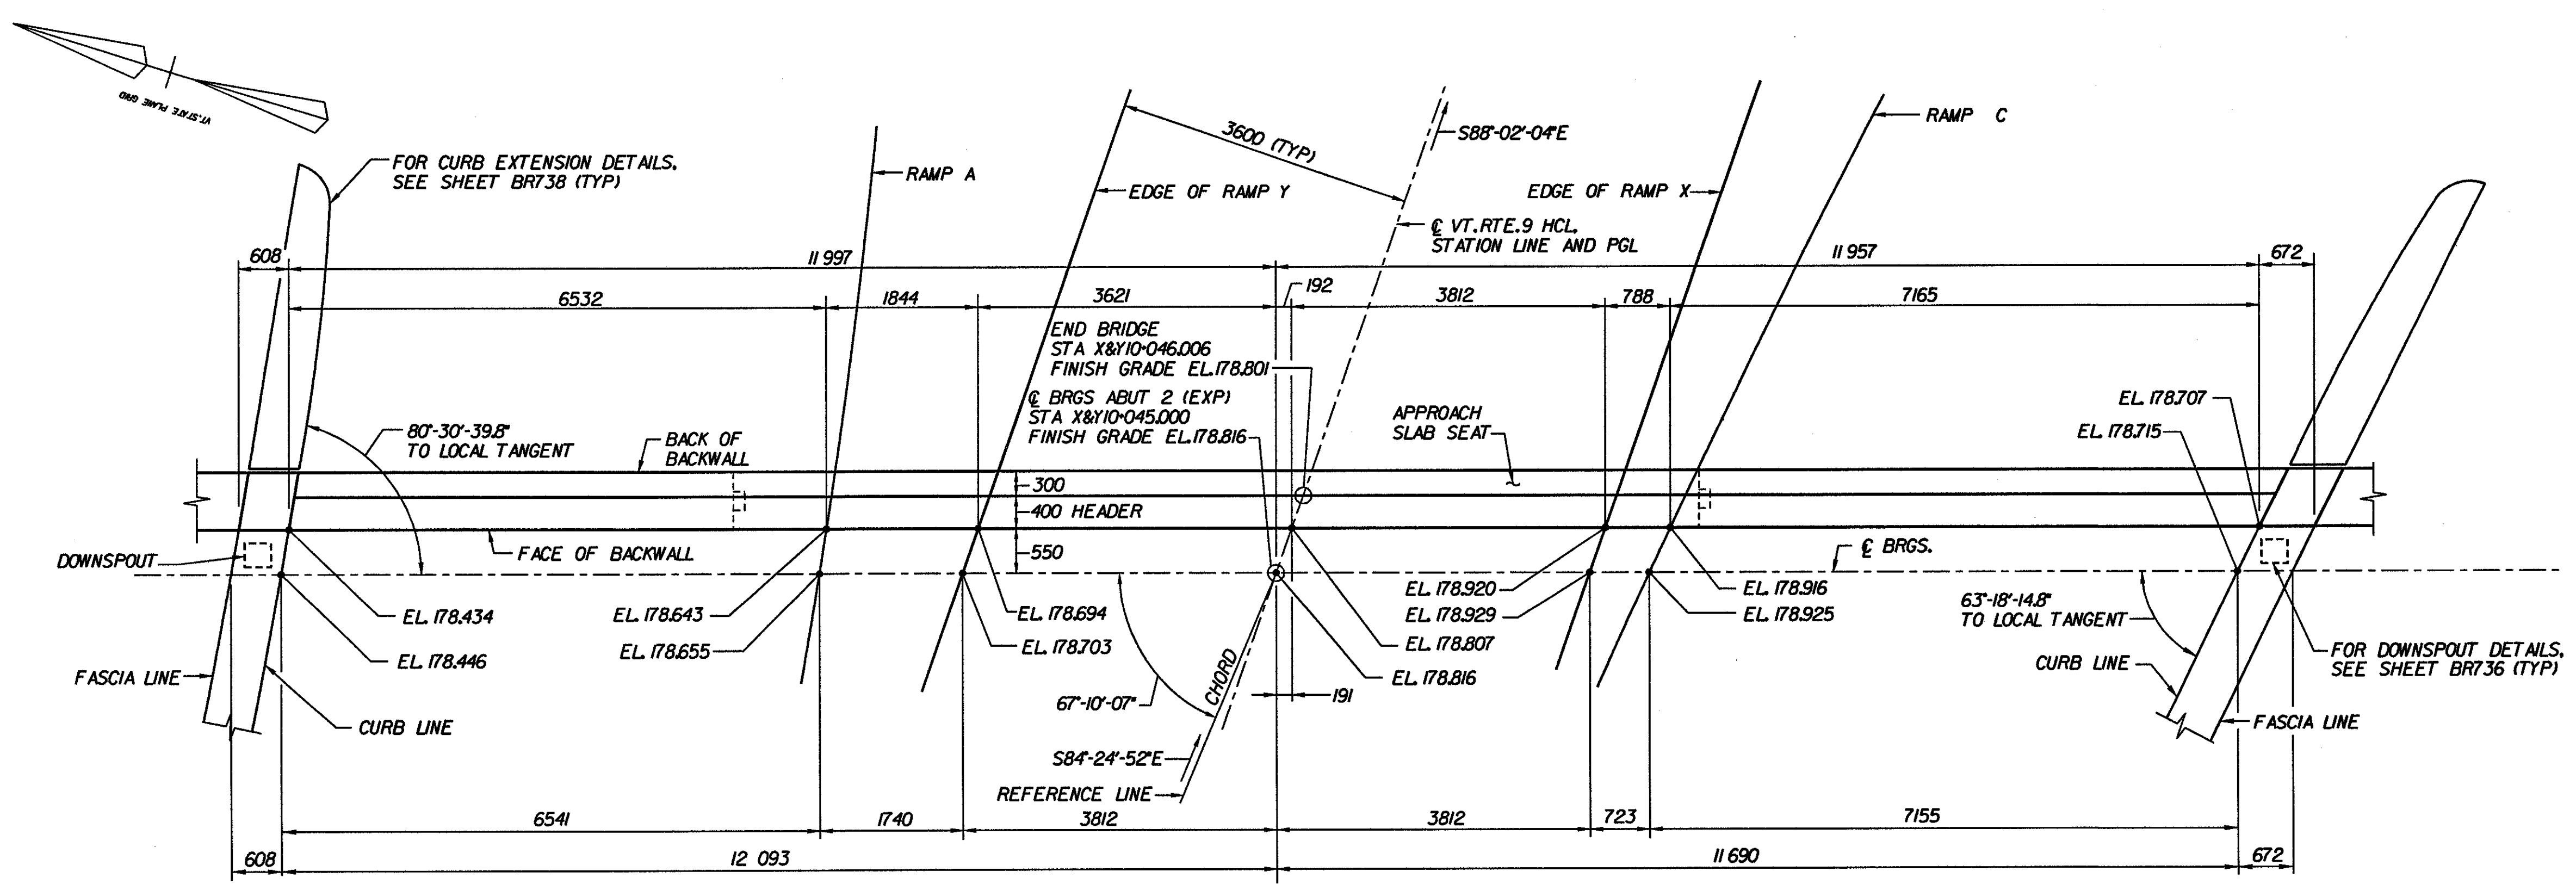


EXPANSION JOINT LAYOUT - ABUTMENT 1

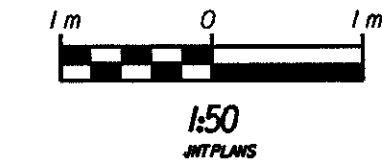

EXPANSION JOINT LAYOUT - ABUTMENT 2

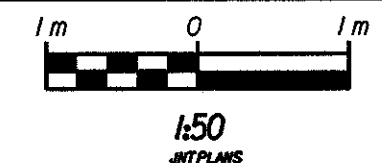

**STATE OF VERMONT
AGENCY OF TRANSPORTATION**

Town Of	BENNINGTON	Bridge No.	BR700
Highway No.	VT. RTE. 9	Log Sta.	
VT. RTE. 9 OVER SILK ROAD AND WALLOOMSAC RIVER		Surv. Sta.	16+800
BRIDGE EXPANSION JOINT DETAILS - I			
Designed By	M. GOGUEN	Drawn by	D. ADDARIO/B. WEATHERBY
Checked By	R. SIPZNER	Date	6/00
PROJECT		PROJECT NO.	
BENNINGTON-HOOSICK		D.P.L. 0146(1) C/4	
L.G.C. Info.			
Bridge Sheet No. BR732		Sheet 215 OF 385	