


FOOTING REINFORCEMENT PLAN



PILE PLAN

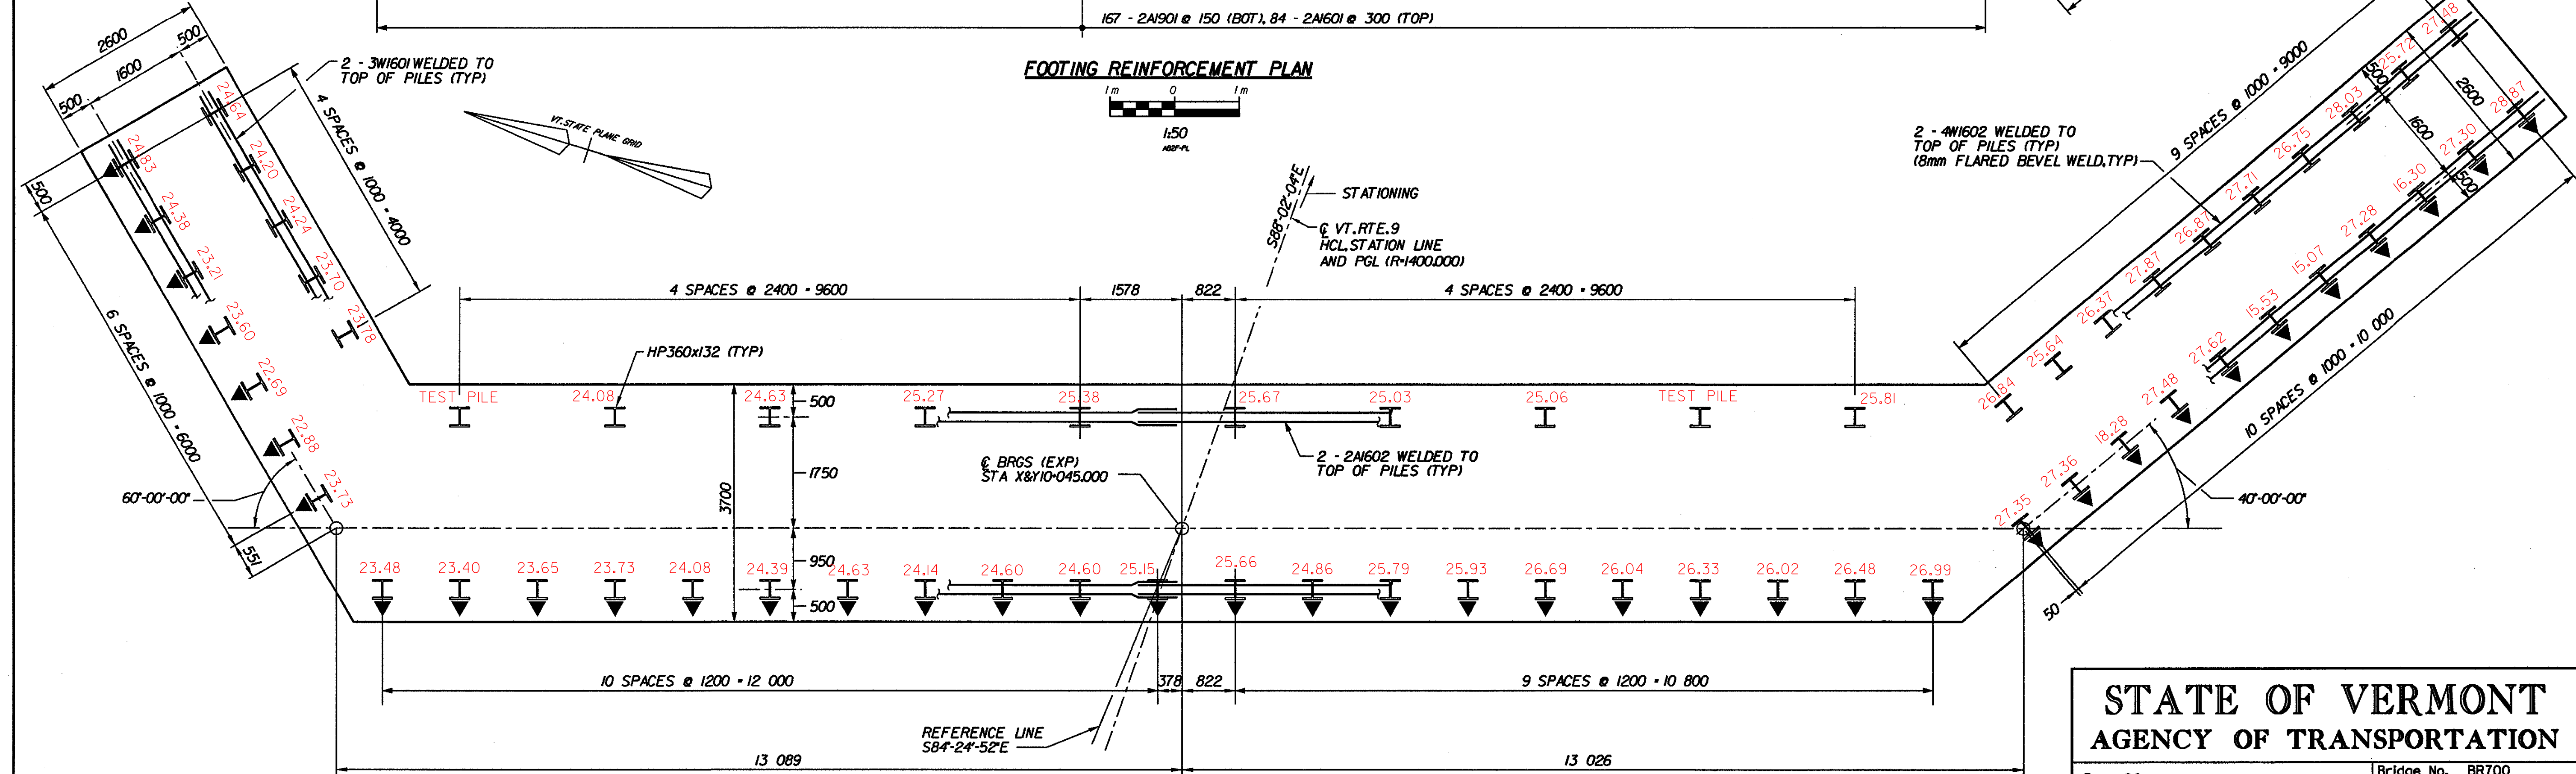

- NOTES:**
1. ESTIMATED PILE LENGTH - 27.0 m.
 2. ALL PILES ARE HP360x132.
 3. INDICATES DIRECTION OF 1 ON 4 BATTER
 4. SEE PILE DRIVING AND LOAD TEST NOTES ON SHEET BR755.

**STATE OF VERMONT
AGENCY OF TRANSPORTATION**

Town Of	BENNINGTON	Bridge No.	BR700
Highway No.	VT. RTE. 9	Log Sta.	
VT. RTE. 9 OVER SILK ROAD AND WALLOOMSAC RIVER		Surv. Sta.	16+800
ABUTMENT 2 REINFORCEMENT DETAILS - 1			
Designed By	C. TUTUNJIAN	Drawn by	J. HOTALING/B. WEATHERBY
Checked By	L. AVERY	Date	6/00
		Bridge Design Supervisor	M. OLSTAD
		Date	9/00
PROJECT	BENNINGTON-HOOSICK	PROJECT NO.	D.P.I. 0146(1) C/4
I.G.C. Info.			
Bridge Sheet No.	BR747	Sheet	230 OF 385