

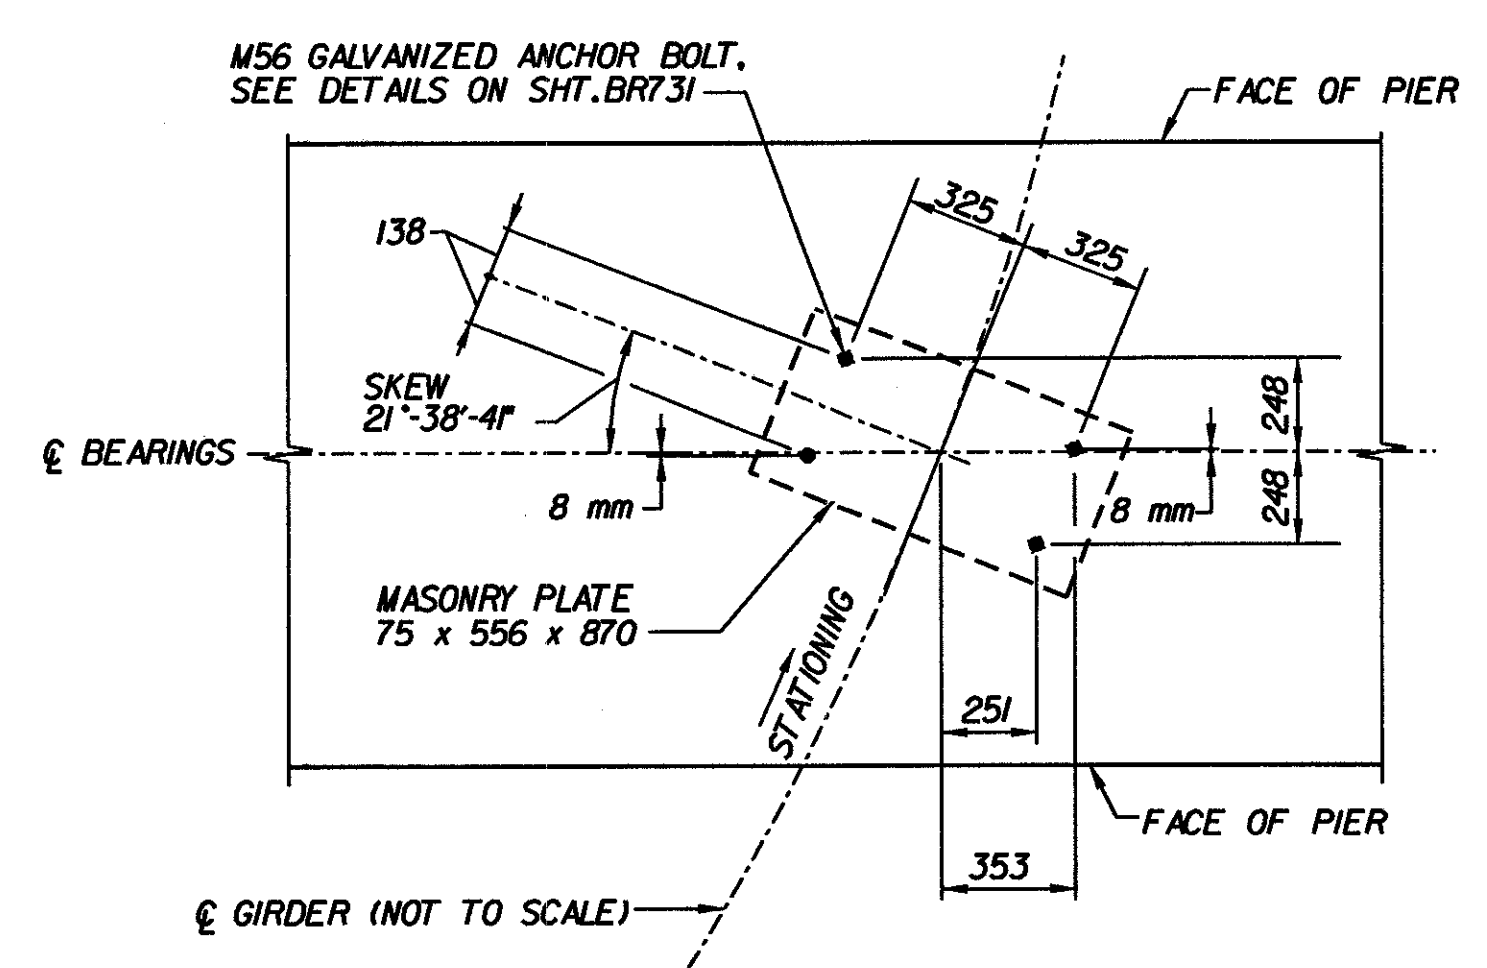



PIER 3 PLAN
1 m 0 1 m
1:50

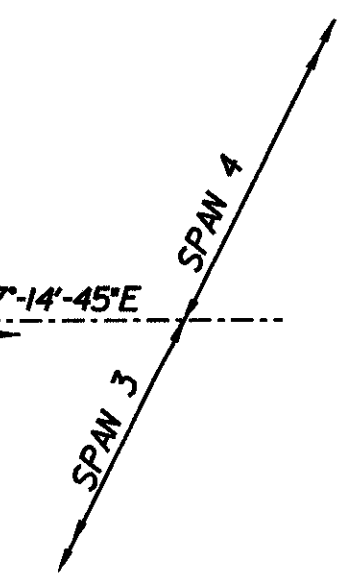

PLAN-ANCHOR BOLT LAYOUT (PIER 3)
4 m 0 4 m
1:20

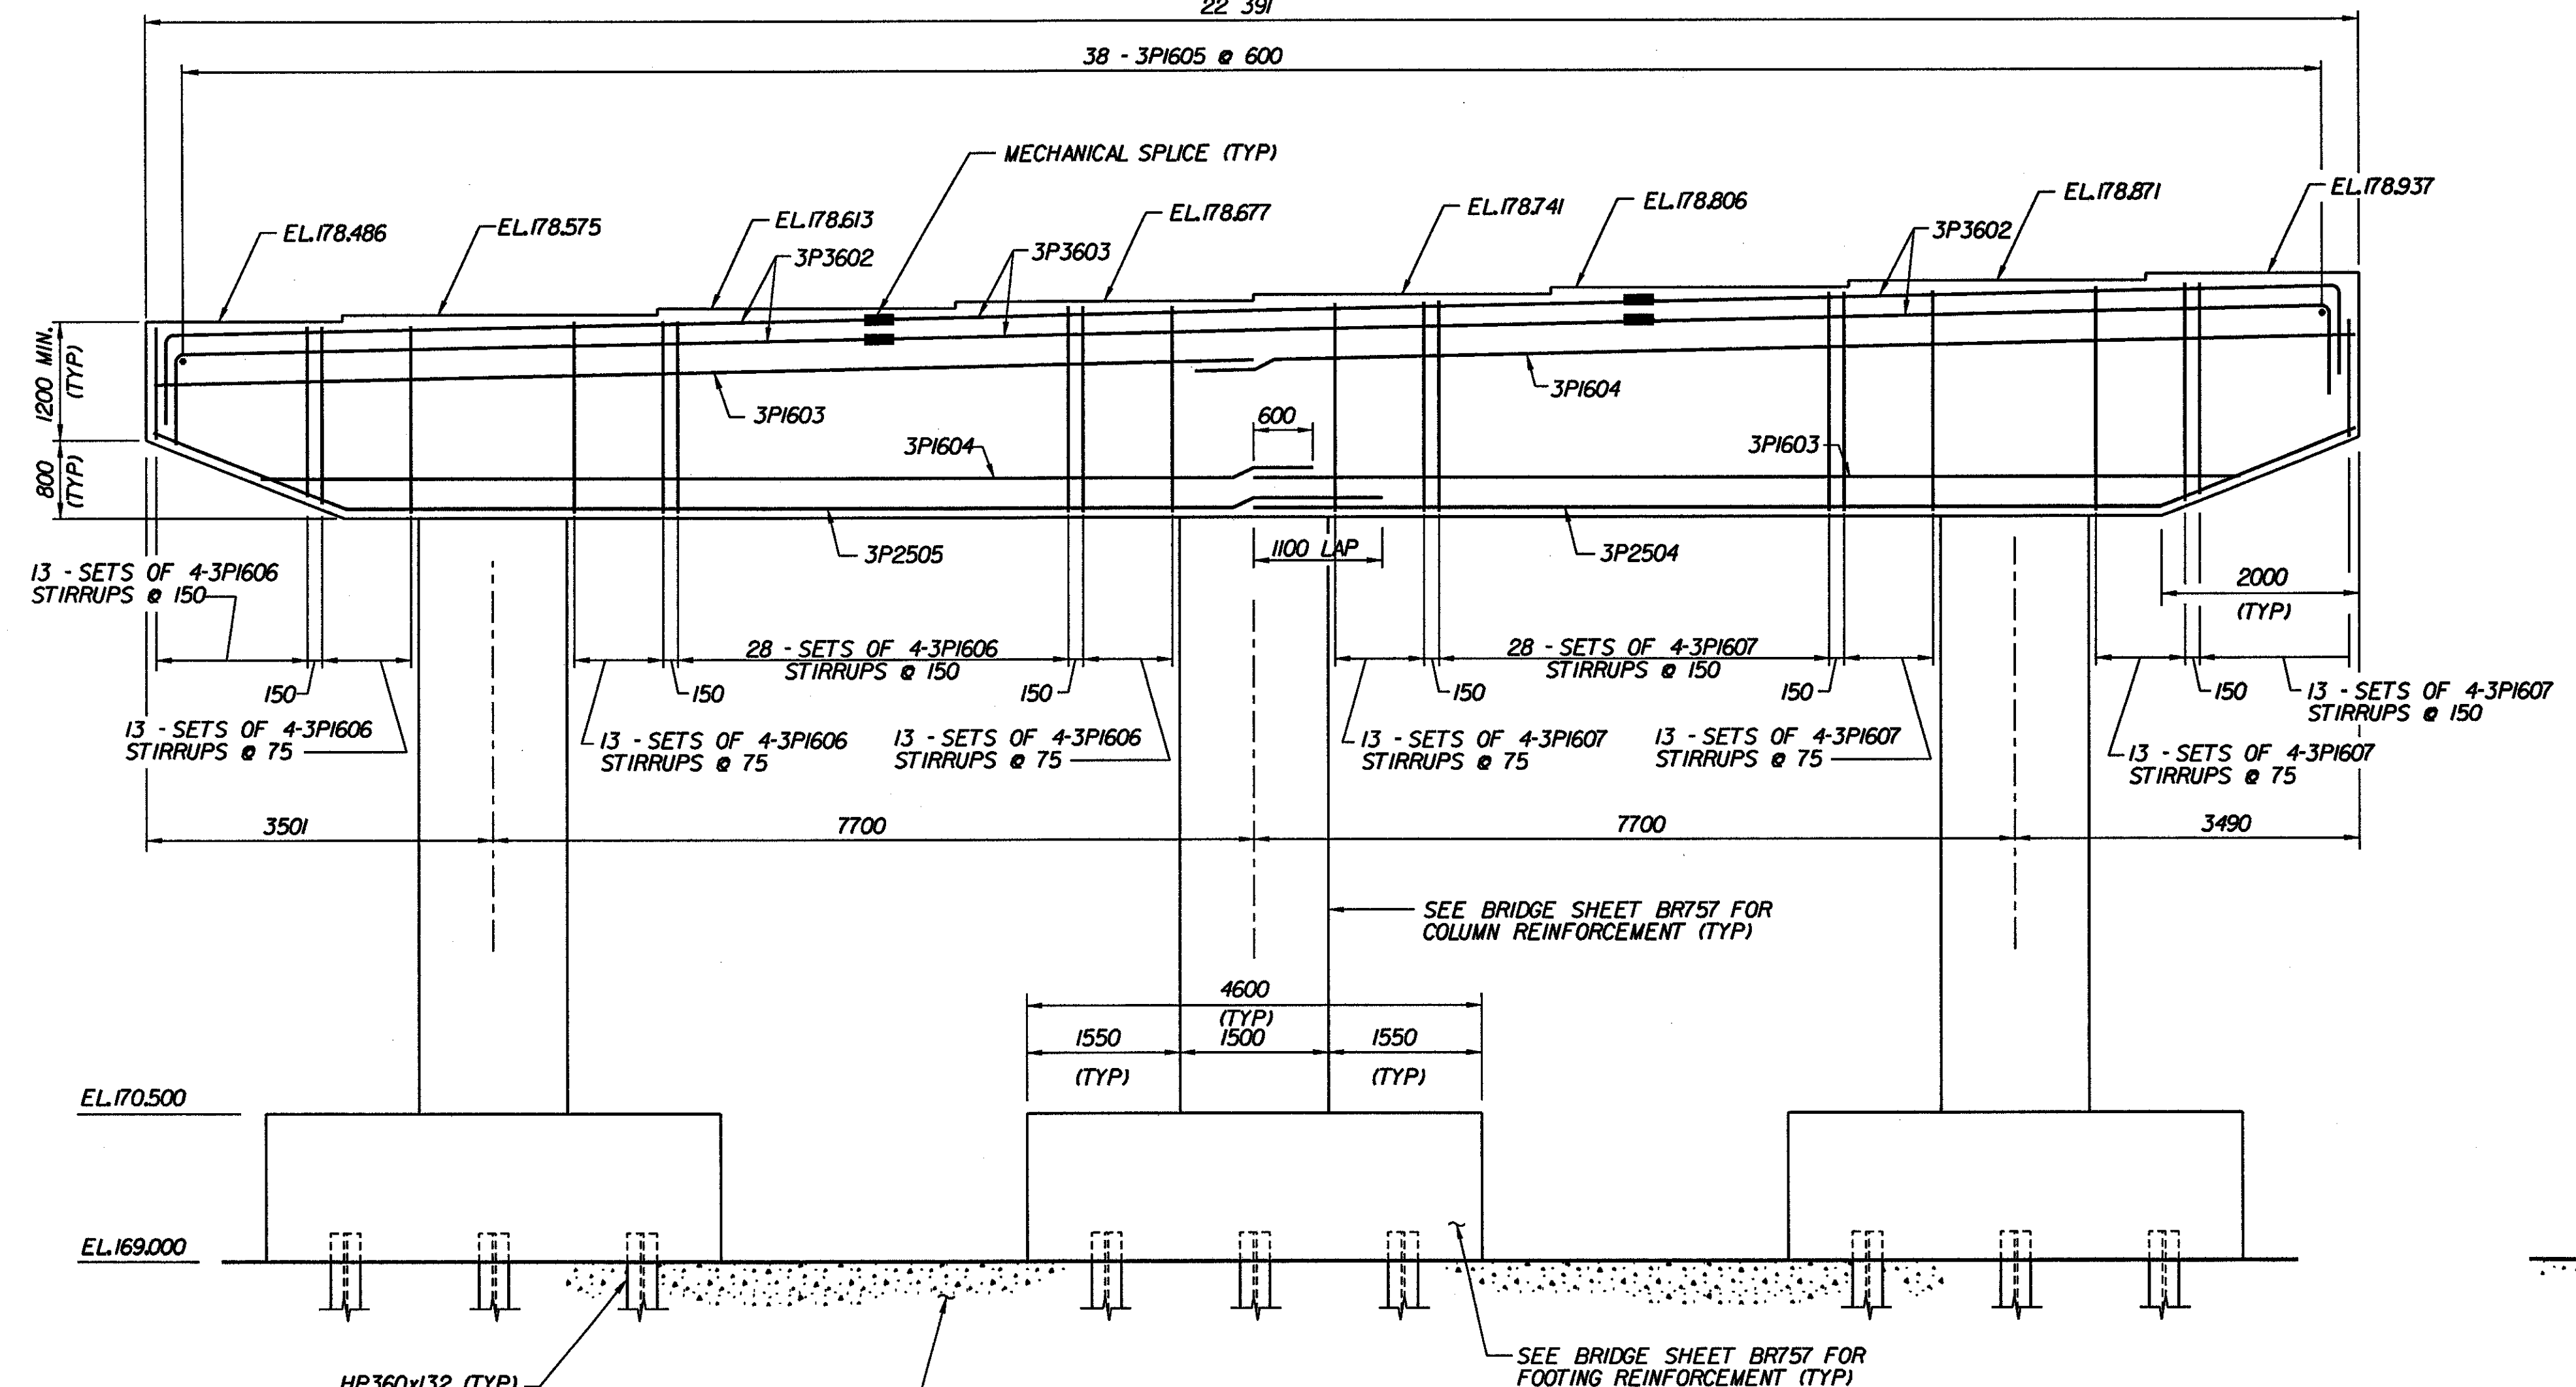

PIER 3 ELEVATION
1 m 0 1 m
1:50

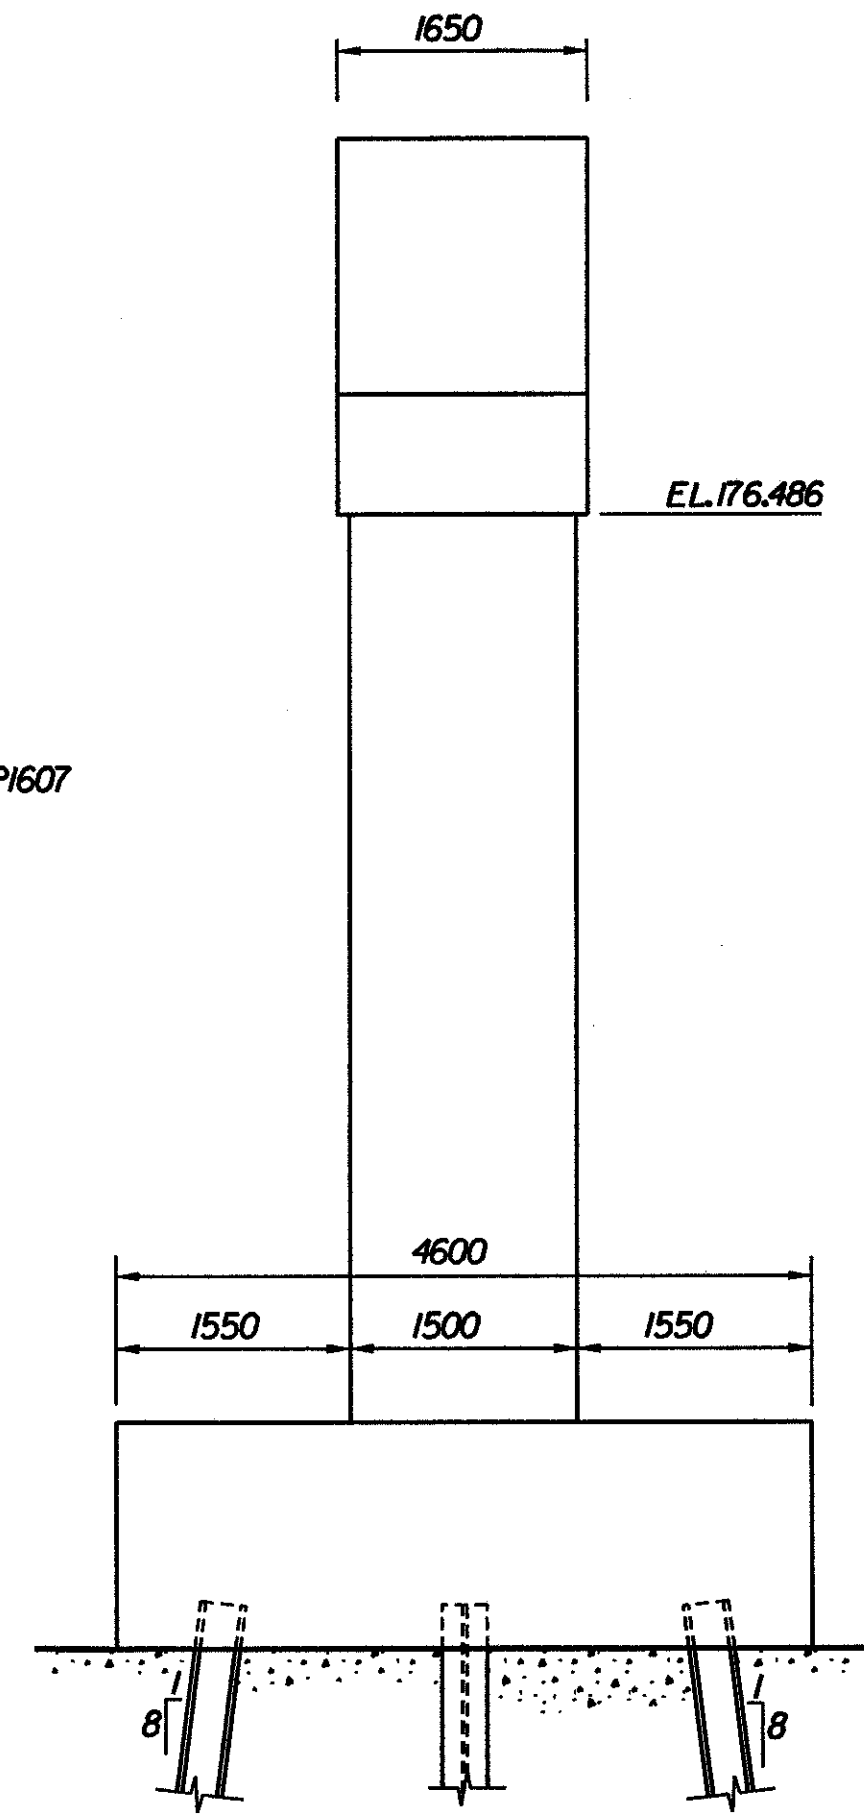

END ELEVATION
1 m 0 1 m
1:50

- NOTES:**
- ANCHOR BOLTS SHALL CLEAR ALL REINFORCING STEEL IN THE PIER CAP.
 - MECHANICAL SPLICES ARE SUBSIDIARY TO ITEM 507J5 AND SHALL CONFORM TO SECTION 713.02 OF THE STANDARD SPECIFICATIONS.

**STATE OF VERMONT
AGENCY OF TRANSPORTATION**

Town Of	BENNINGTON	Bridge No.	BR700
Highway No.	VT. RTE. 9	Log Sta.	
VT. RTE. 9 OVER SILK ROAD AND WALLOOMSAC RIVER		Surv. Sta.	16+800
PIER 3 PLAN AND ELEVATION			
Designed By	C. TUTUNJIAN	Drawn by	J. HOTALING/B. WEATHERBY
Checked By	D. VIENI	Date	6/00
		Bridge Design Supervisor	M.W. OLSTAD
		Date	9/00
PROJECT	BENNINGTON-HOOSICK	PROJECT NO.	D.P.L. 0146(1) C/4
I.G.C. Info.			
Bridge Sheet No.	BR756	Sheet	239 OF 385

16/25/01/05/BR700/P.3.SHT/05.2800.BW.150