


NOTE:  
TYPE I STONE TO BE  
INSTALLED BY HAND, NOT  
MACHINE PLACED.


SECTION A-A

DETENTION POND  
OUTLET STRUCTURE

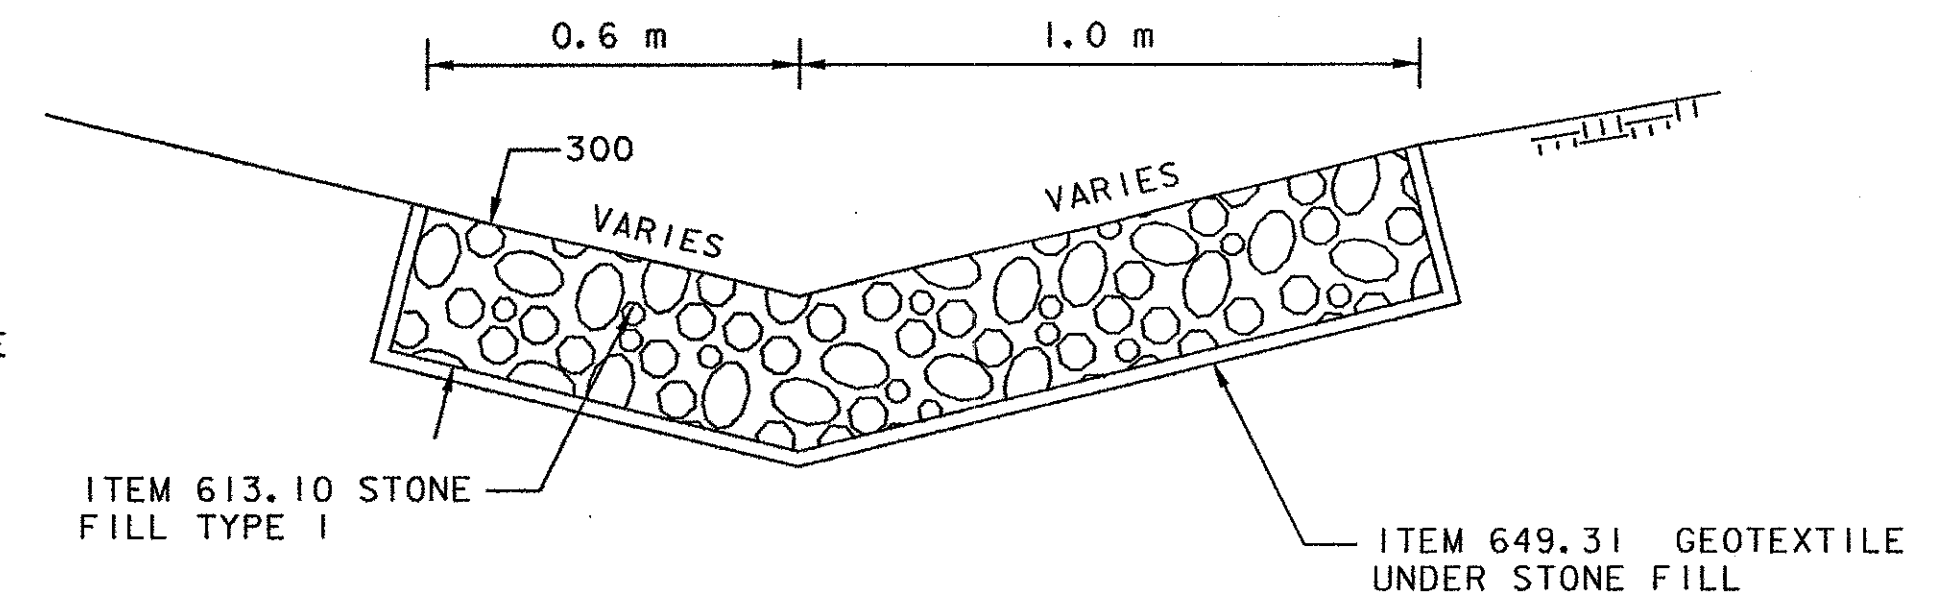


DITCH PROTECTION

STA. HR 1+020 TO HR 1+156  
STA. HR 1+230 TO HR 1+315  
NOT TO SCALE

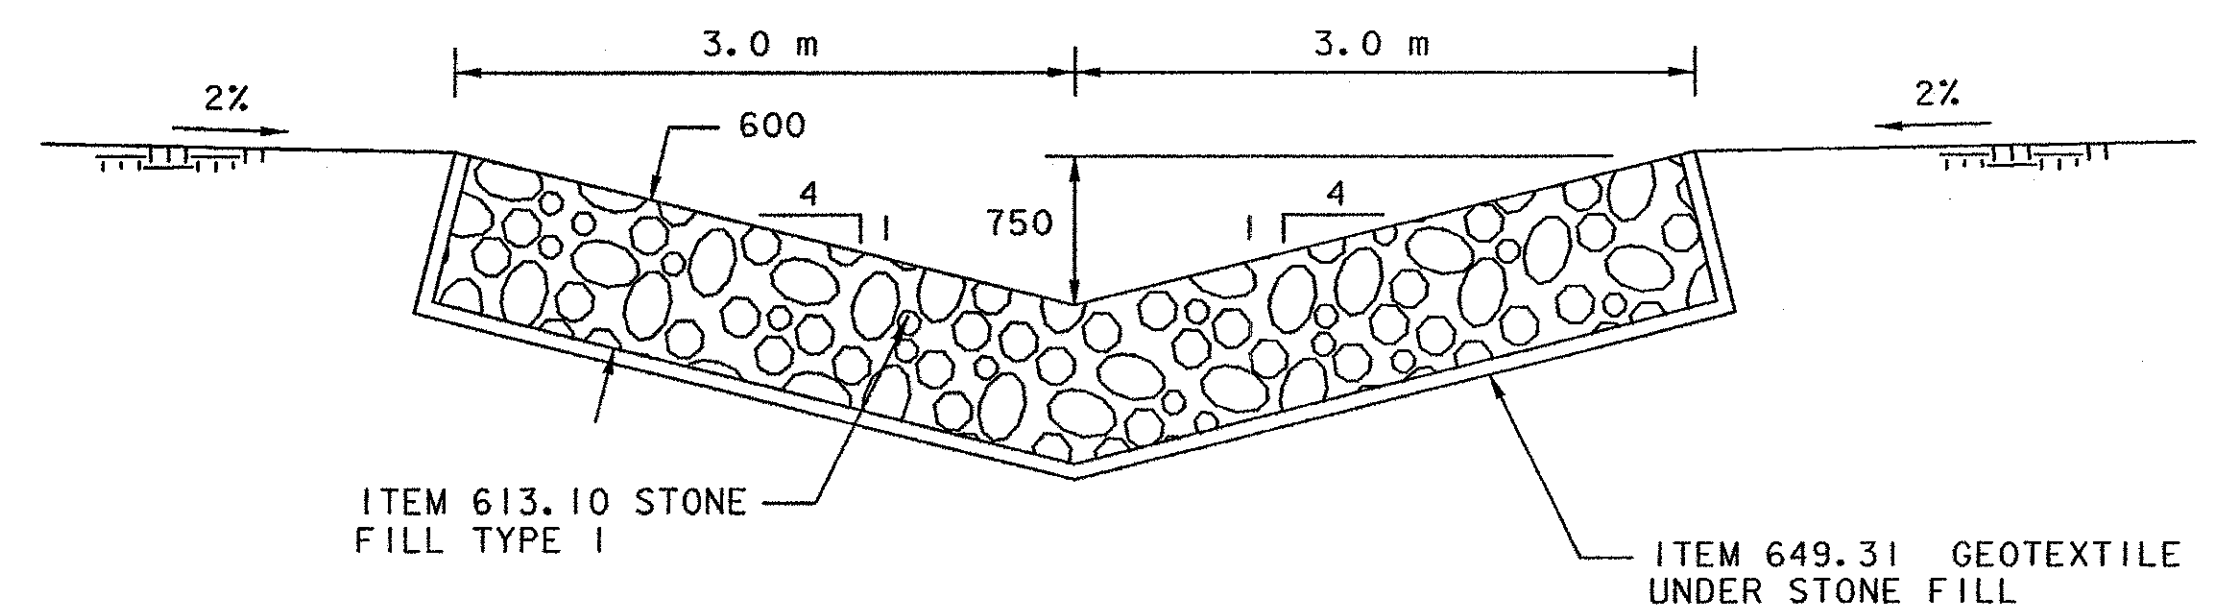

DITCH PROTECTION

STA. B 1+460 TO B 1+520  
NOT TO SCALE

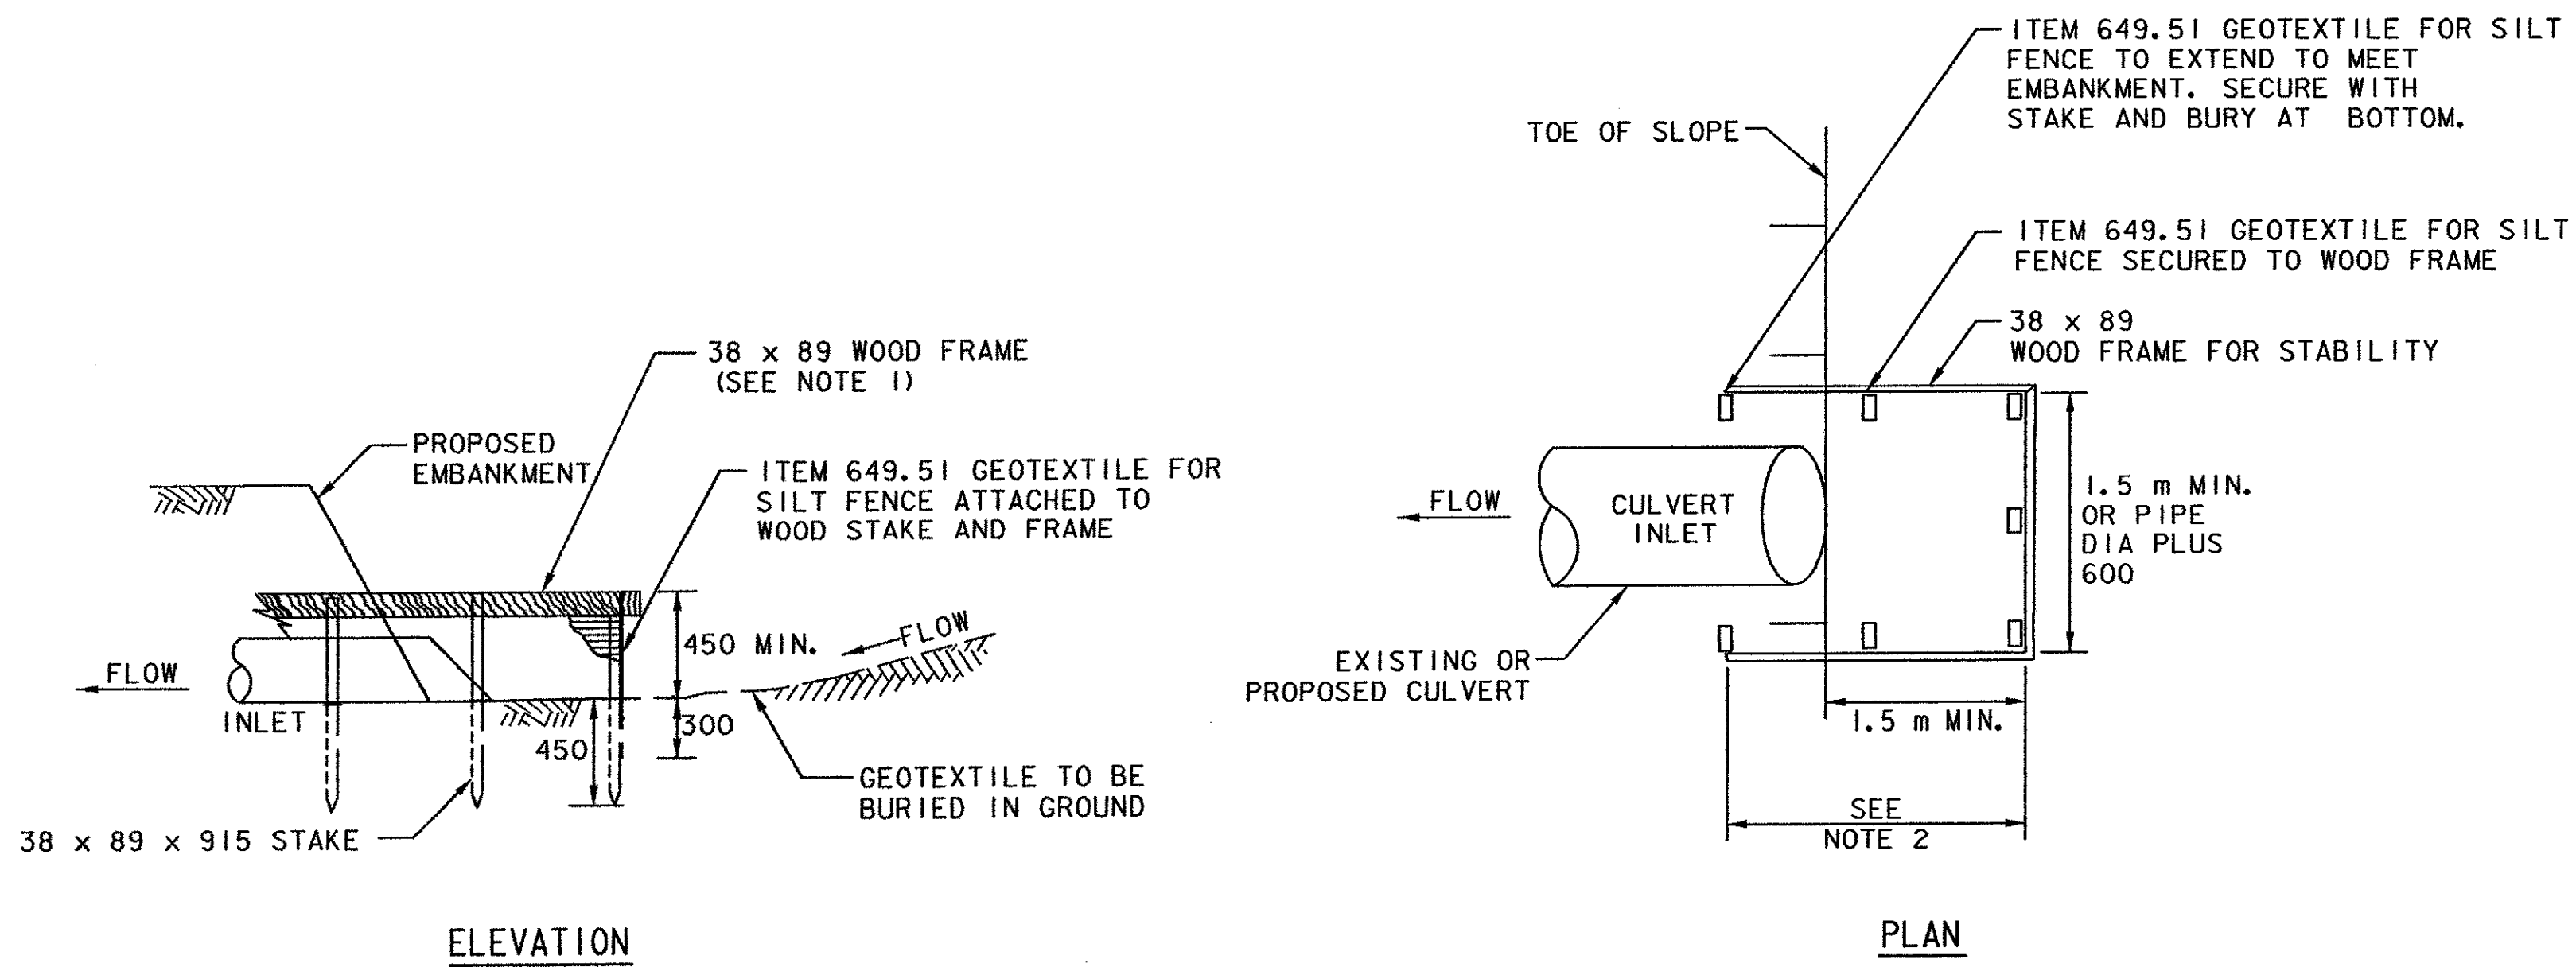

SILT FENCE FOR TEMPORARY  
EROSION CONTROL AT CULVERT INLETS

NOT TO SCALE

STANDARD SYMBOL:

NOTES:

1. A 38 mm x 89 mm WOOD FRAME SHALL BE CONSTRUCTED AROUND THE TOP OF THE STAKES OVER THE ATTACHED FABRIC FOR OVERFLOW STABILITY.
2. SPACE STAKES EVENLY AROUND INLET TO A MAXIMUM OF 900 mm APART AND DRIVE A MINIMUM 450 mm DEEP. SPANS GREATER THAN 900 mm MAY BE BRIDGED WITH THE USE OF WIRE MESH BEHIND THE FILTER FABRIC FOR SUPPORT.

ALL DIMENSIONS IN MILLIMETERS EXCEPT WHERE OTHERWISE INDICATED.

BORING LOCATION TABLE				
BORING #	BORROW STA.	OFFSET	MAINLINE STA.	OFFSET
376	B 1+061.17	14.0 m LT	8+750.00	14.0 m LT
384	B 1+211.17	14.0 m LT	8+900.00	14.0 m LT
xxx	B 1+210.55	4.0 m RT	8+900.00	4.0 m RT
xxx	B 1+260.58	4.0 m RT	8+950.00	4.0 m RT
393	B 1+261.17	15.0 m RT	8+950.00	15.0 m RT
396	B 1+261.17	35.0 m RT	8+950.00	35.0 m RT
401	B 1+311.17	14.0 m LT	9+000.00	14.0 m LT
xxx	B 1+310.74	4.0 m RT	9+000.00	4.0 m RT
xxx	B 1+360.82	4.0 m RT	9+050.00	4.0 m RT
416	B 1+411.17	14.0 m LT	9+100.00	14.0 m LT
xxx	B 1+410.76	4.0 m RT	9+100.00	4.0 m RT
xxx	B 1+460.87	4.0 m RT	9+150.00	4.0 m RT
428	B 1+510.64	14.0 m LT	9+200.00	14.0 m LT
xxx	B 1+510.64	4.0 m RT	9+200.00	4.0 m RT
453	B 1+706.17	14.0 m LT	9+395.00	14.0 m LT
454	B 1+706.17	11.5 m LT	9+395.00	11.5 m LT



PROJECT NAME: BENNINGTON - HOOSICK

PROJECT NUMBER: DPI0146 (I) C/4

FILE NAME: borrow detail.dgn

PROJECT LEADER: GAE

DESIGNED BY: BJM

**BORROW AREA DETAILS**

PLOT DATE: 08/29/2000

DRAWN BY: MBL

CHECKED BY: GAS

SHEET 261 OF 385