


H 1:500 SCALE  
V 1:100 SCALE  
& FULL SIZE

ALL DIMENSIONS IN MILLIMETERS EXCEPT WHERE OTHERWISE INDICATED.

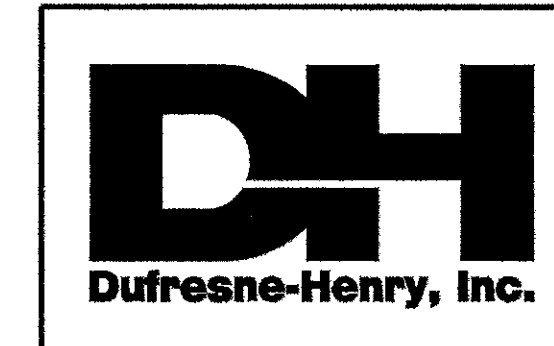

PROJECT NAME:	BENNINGTON - HOOSICK	
PROJECT NUMBER:	DPI0146 (I) C/4	
FILE NAME:	HaulRoad prof.dgn	PLOT DATE: 08/29/2000
PROJECT LEADER:	GAE	DRAWN BY: MBL
DESIGNED BY:	BJM	CHECKED BY: GAS
<b>HAUL ROAD PROFILE</b>		SHEET 268 OF 385