

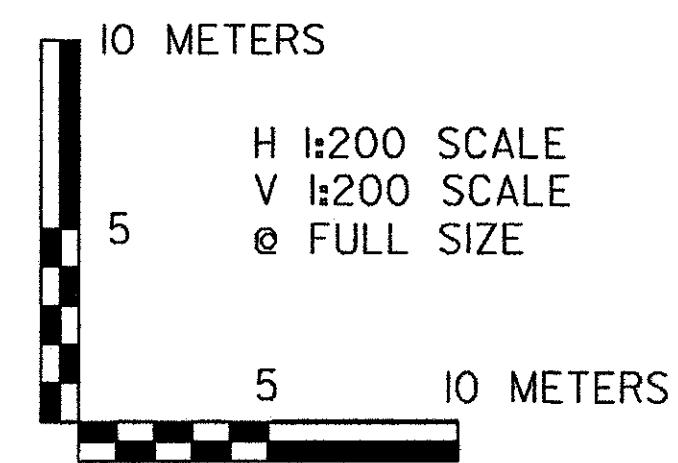


BEGIN CONSTRUCTION
STA B 1+443.00

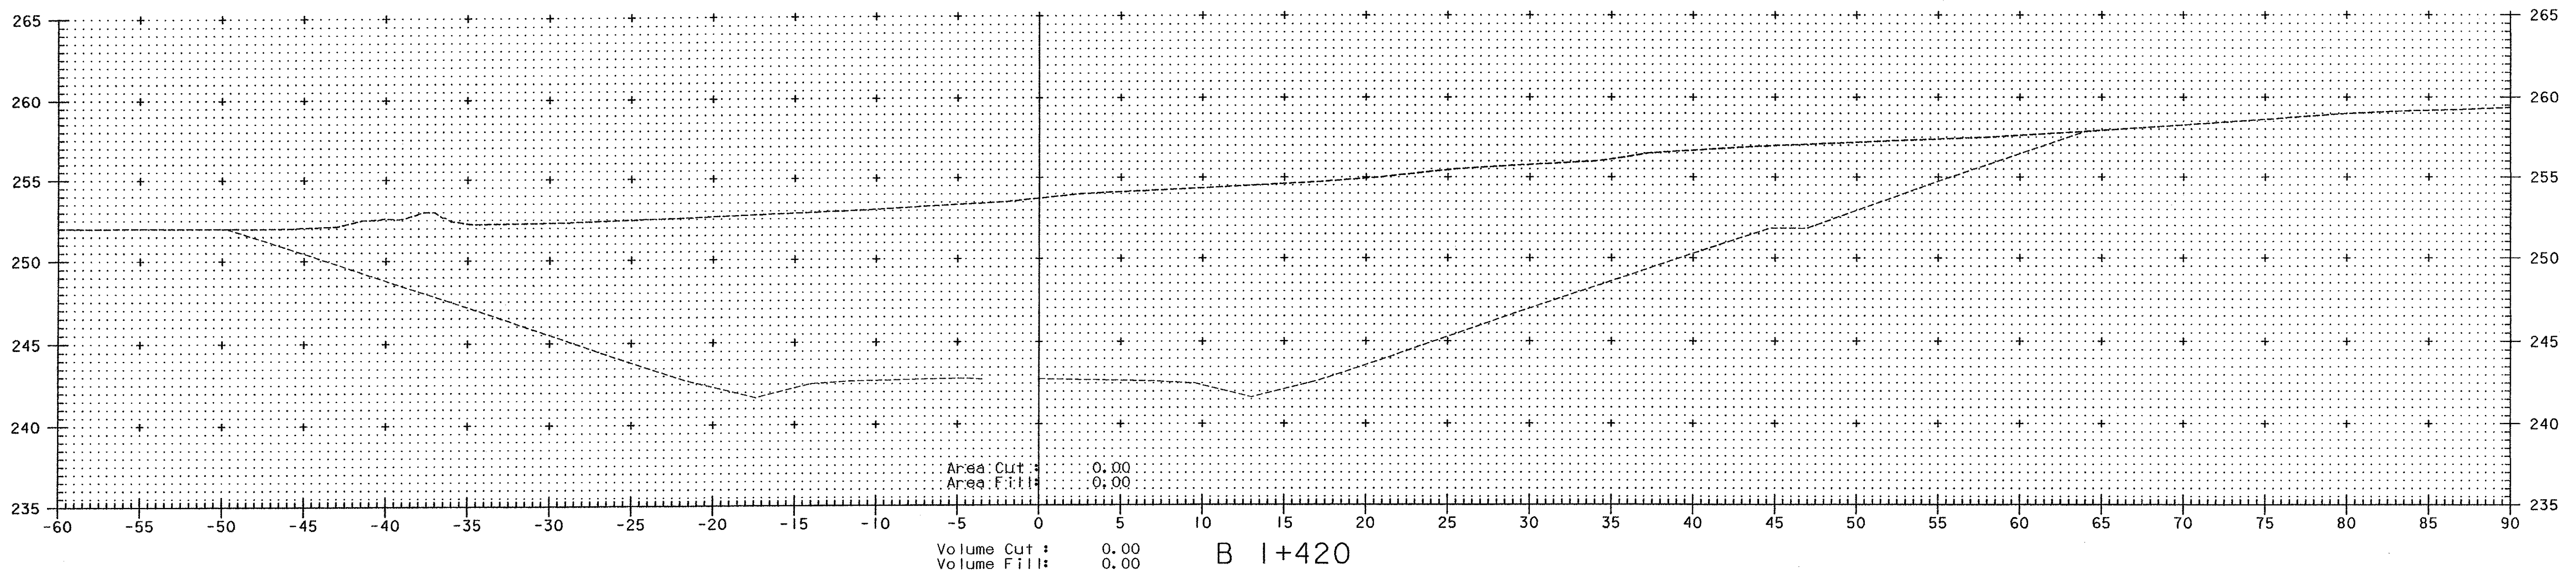

H 1:200 SCALE
V 1:200 SCALE
@ FULL SIZE

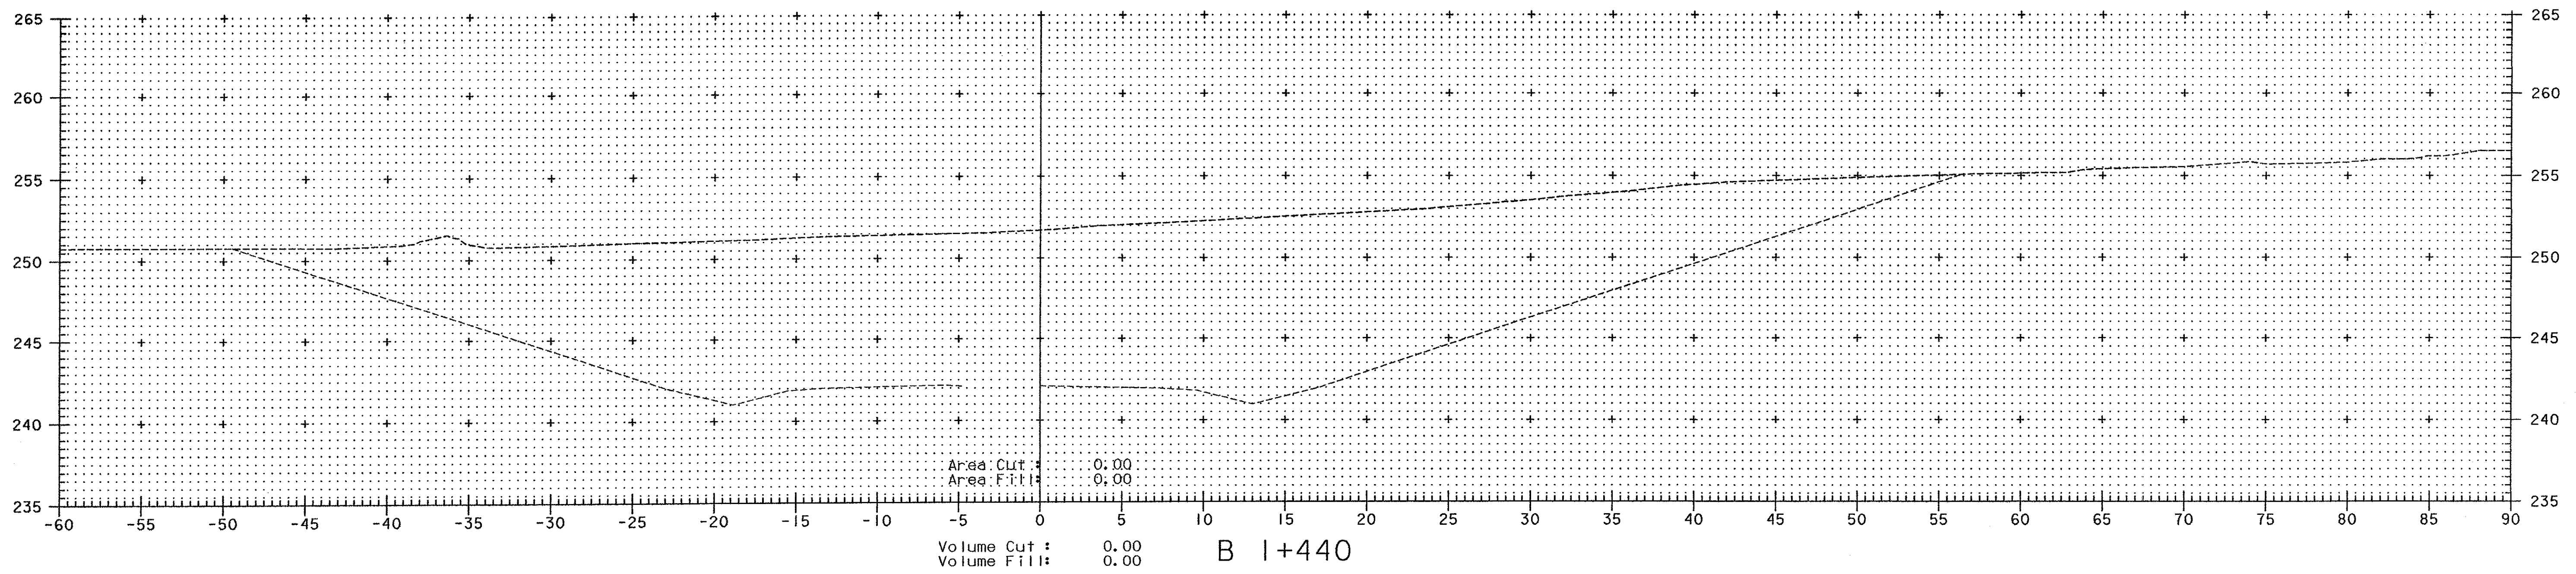

ALL DIMENSIONS IN MILLIMETERS EXCEPT WHERE OTHERWISE INDICATED.

PROJECT NAME: BENNINGTON - HOOSICK
PROJECT NUMBER: DPI0146 (I) C/4

FILE NAME: c4 xs.dgn
PROJECT LEADER: GAE
DESIGNED BY: BJM

PLOT DATE: 08/29/2000
DRAWN BY: MBL
CHECKED BY: GAS
SHEET 269 OF 385

BORROW AREA CROSS SECTIONS