



BEGIN CONSTRUCTION
STA HR 1+005

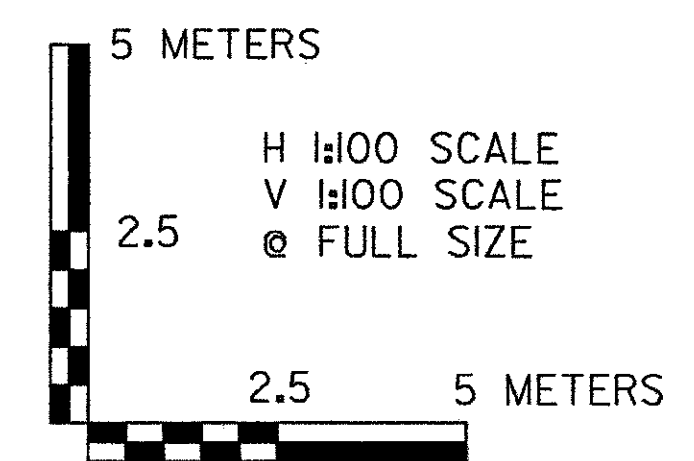

H 1:100 SCALE
V 1:100 SCALE
@ FULL SIZE

ALL DIMENSIONS IN MILLIMETERS EXCEPT WHERE OTHERWISE INDICATED.

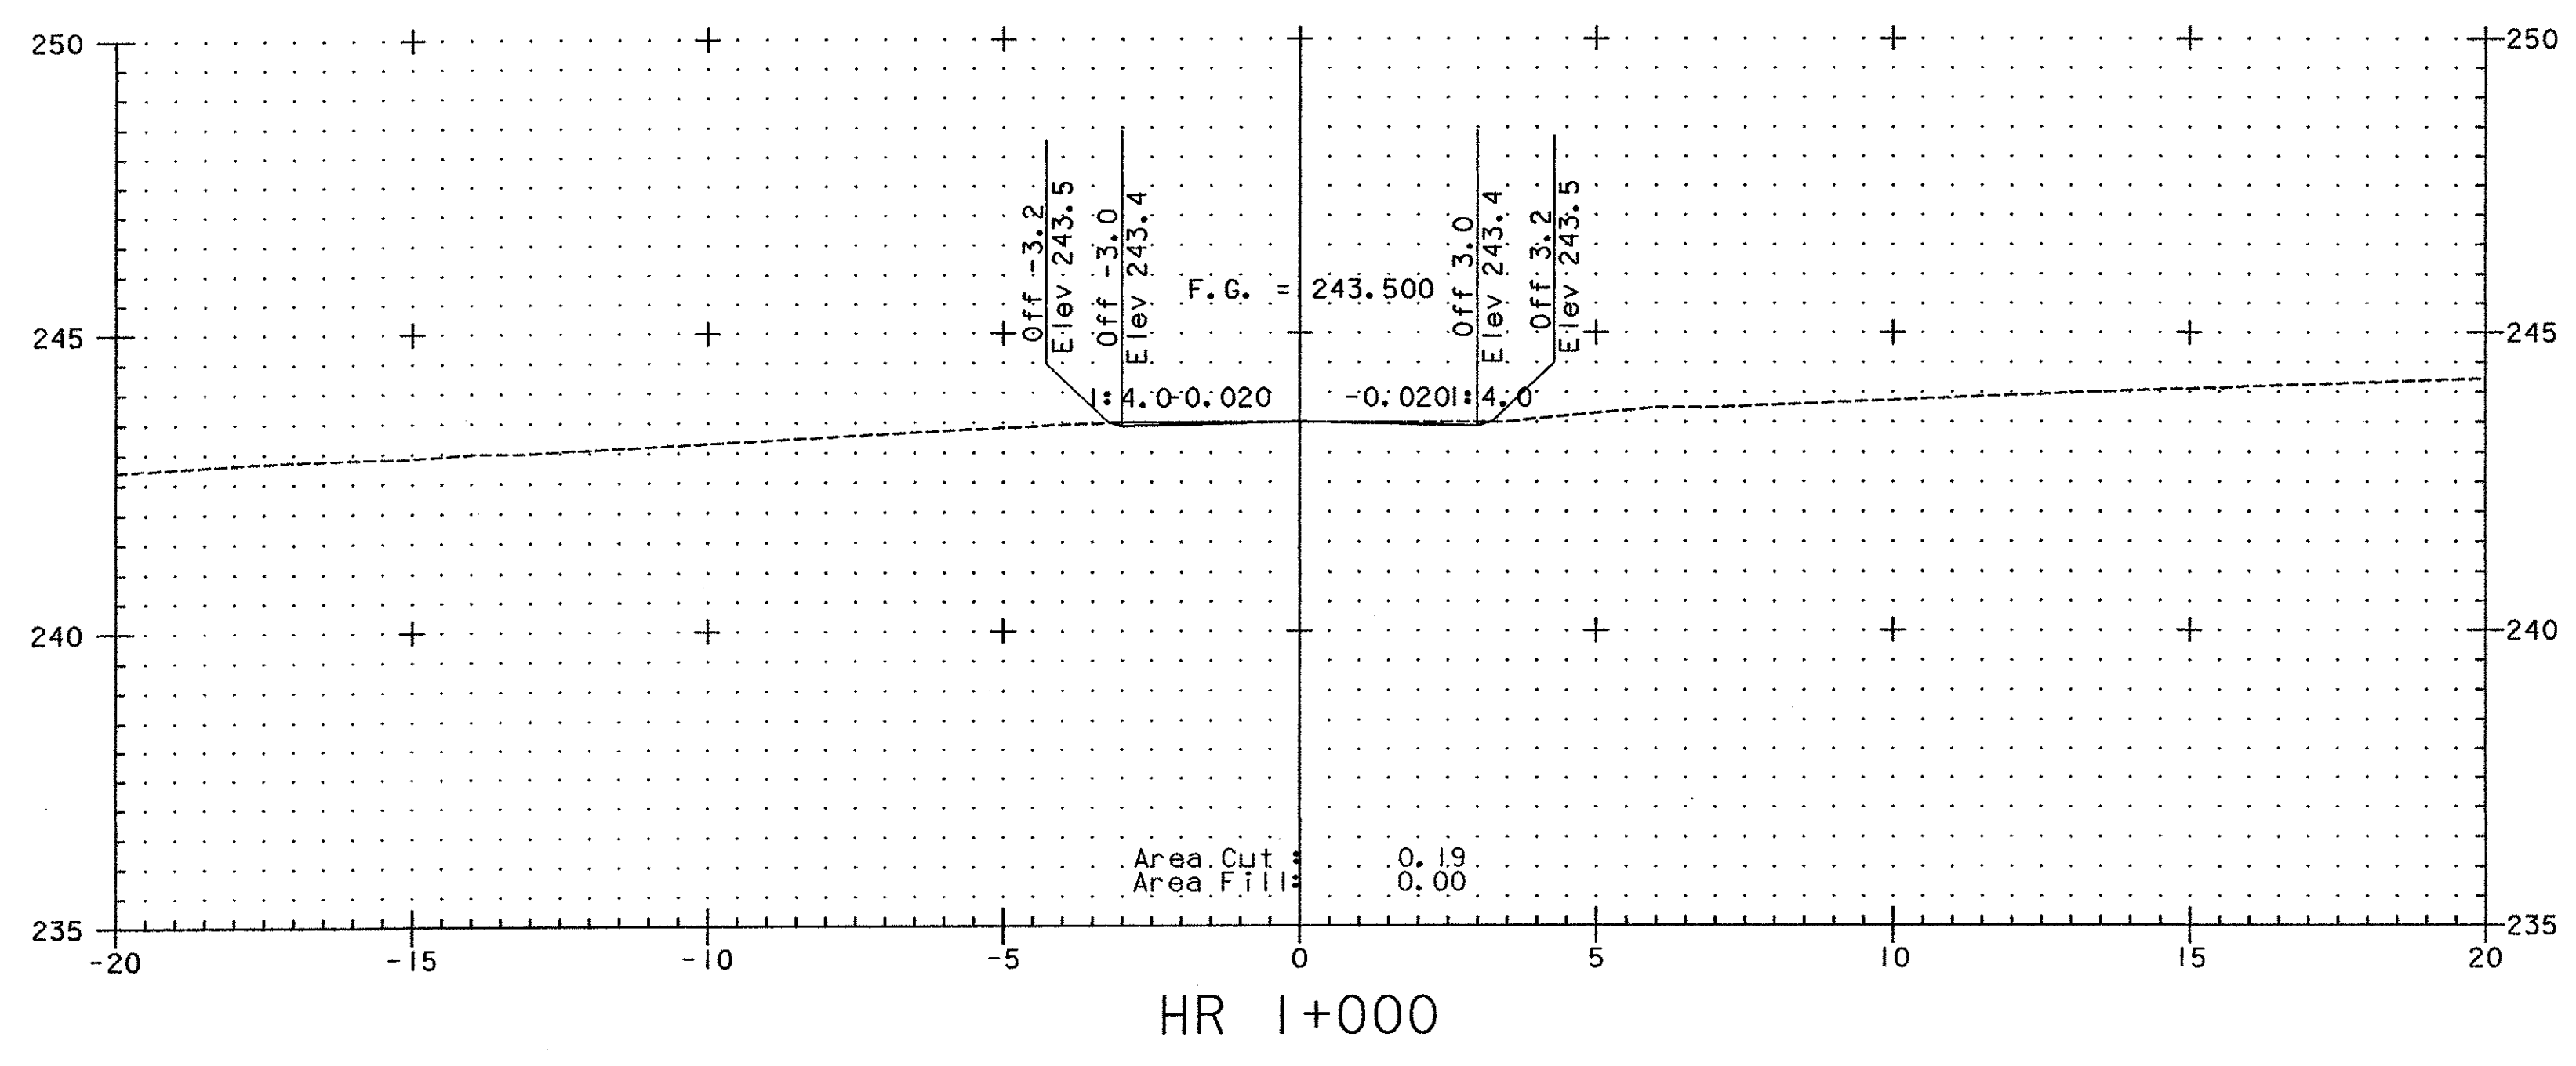

PROJECT NAME: BENNINGTON - HOOSICK	PLOT DATE: 08/29/2000
PROJECT NUMBER: DPI 0146 (1) C/4	DRAWN BY: MBL
FILE NAME: haulroad xs.dgn	CHECKED BY: GAS
DESIGNED BY: BJM	SHEET 274 OF 385
HAUL ROAD CROSS SECTIONS	