



HR 1+060

Volume Cut : 0.57
Volume Fill : 56.37

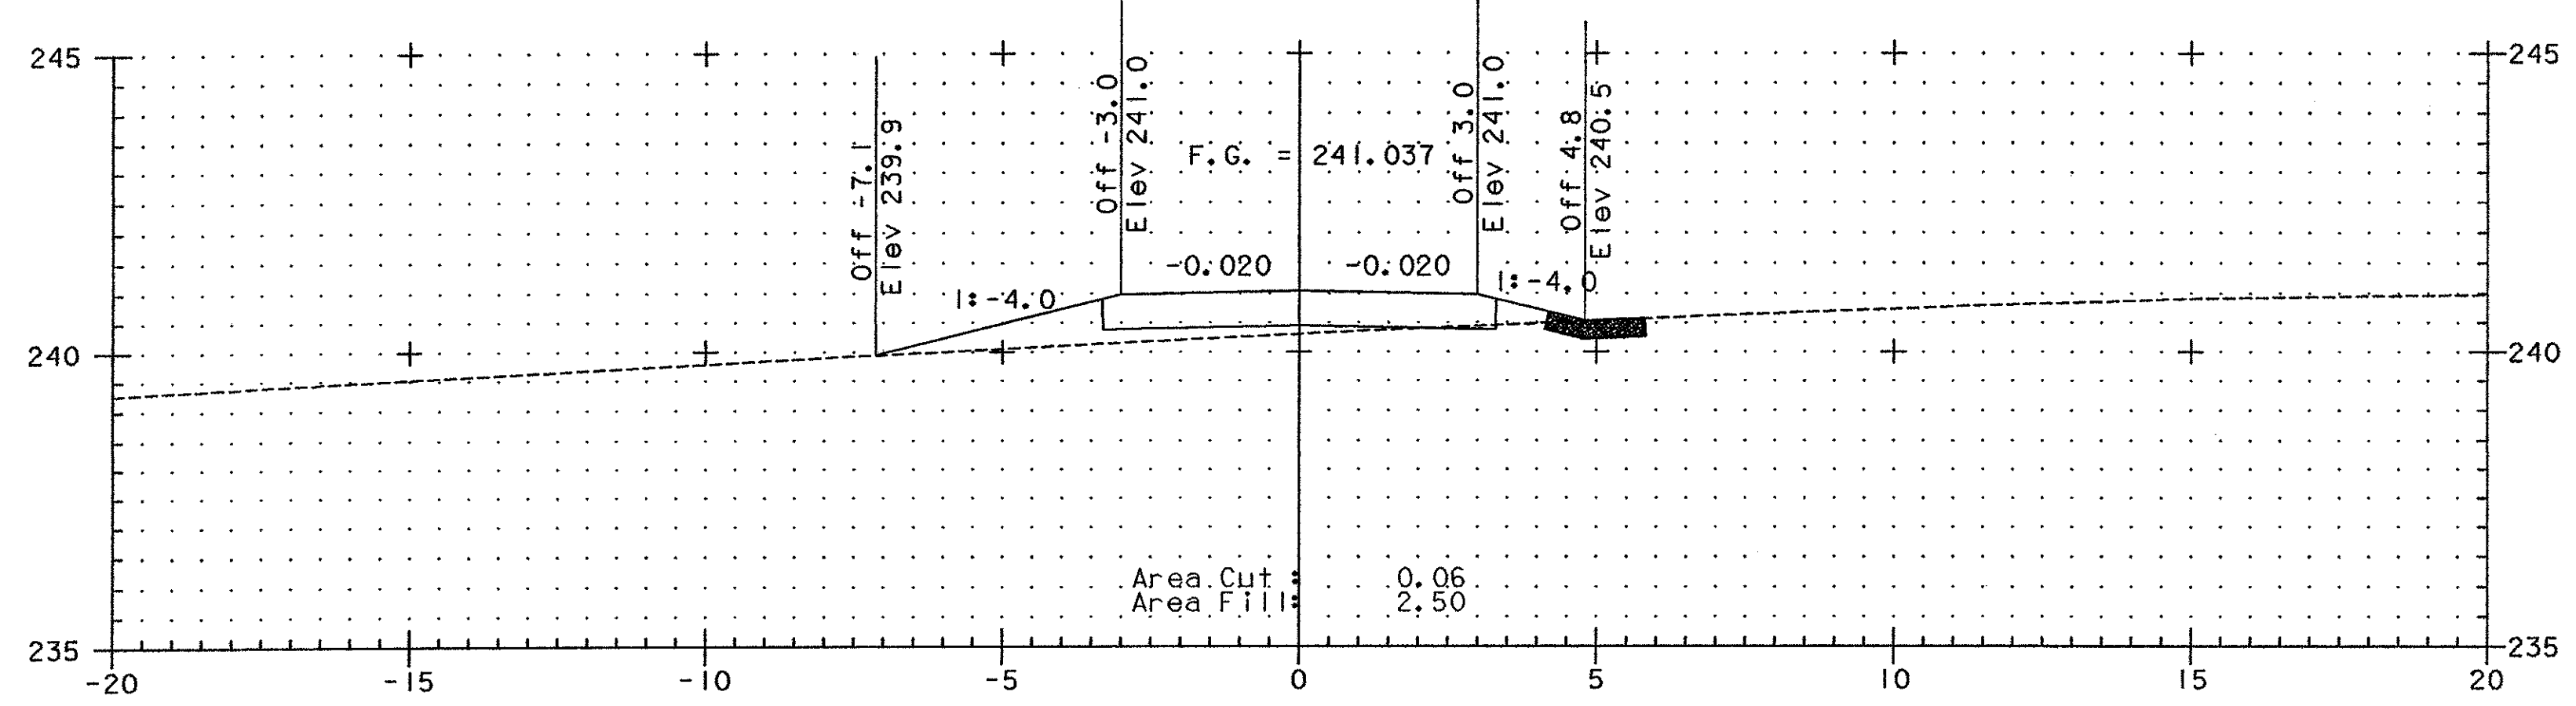

HR 1+040

Volume Cut : 4.28
Volume Fill : 35.63

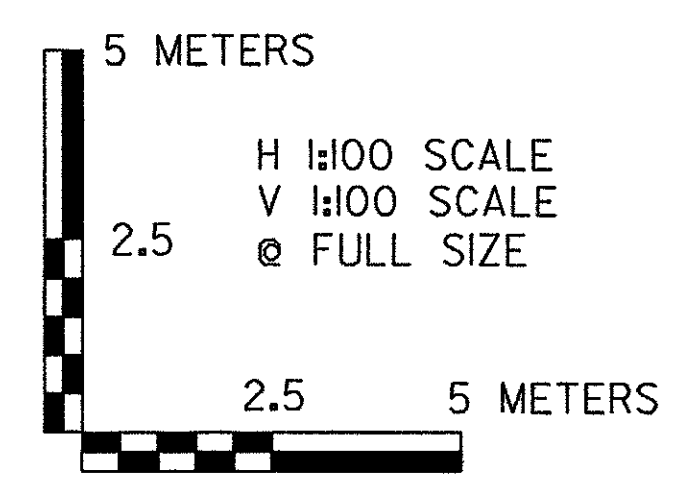

ALL DIMENSIONS IN MILLIMETERS EXCEPT WHERE OTHERWISE INDICATED.



PROJECT NAME:	BENNINGTON - HOOSICK	
PROJECT NUMBER:	DPI 0146 (1) C/4	
FILE NAME:	haulroad xs.dgn	PLOT DATE: 08/29/2000
PROJECT LEADER:	GAE	DRAWN BY: MBL
DESIGNED BY:	BJM	CHECKED BY: GAS
HAUL ROAD CROSS SECTIONS		SHEET 275 OF 385