



Volume Cut : 0.00
Volume Fill : 68.17

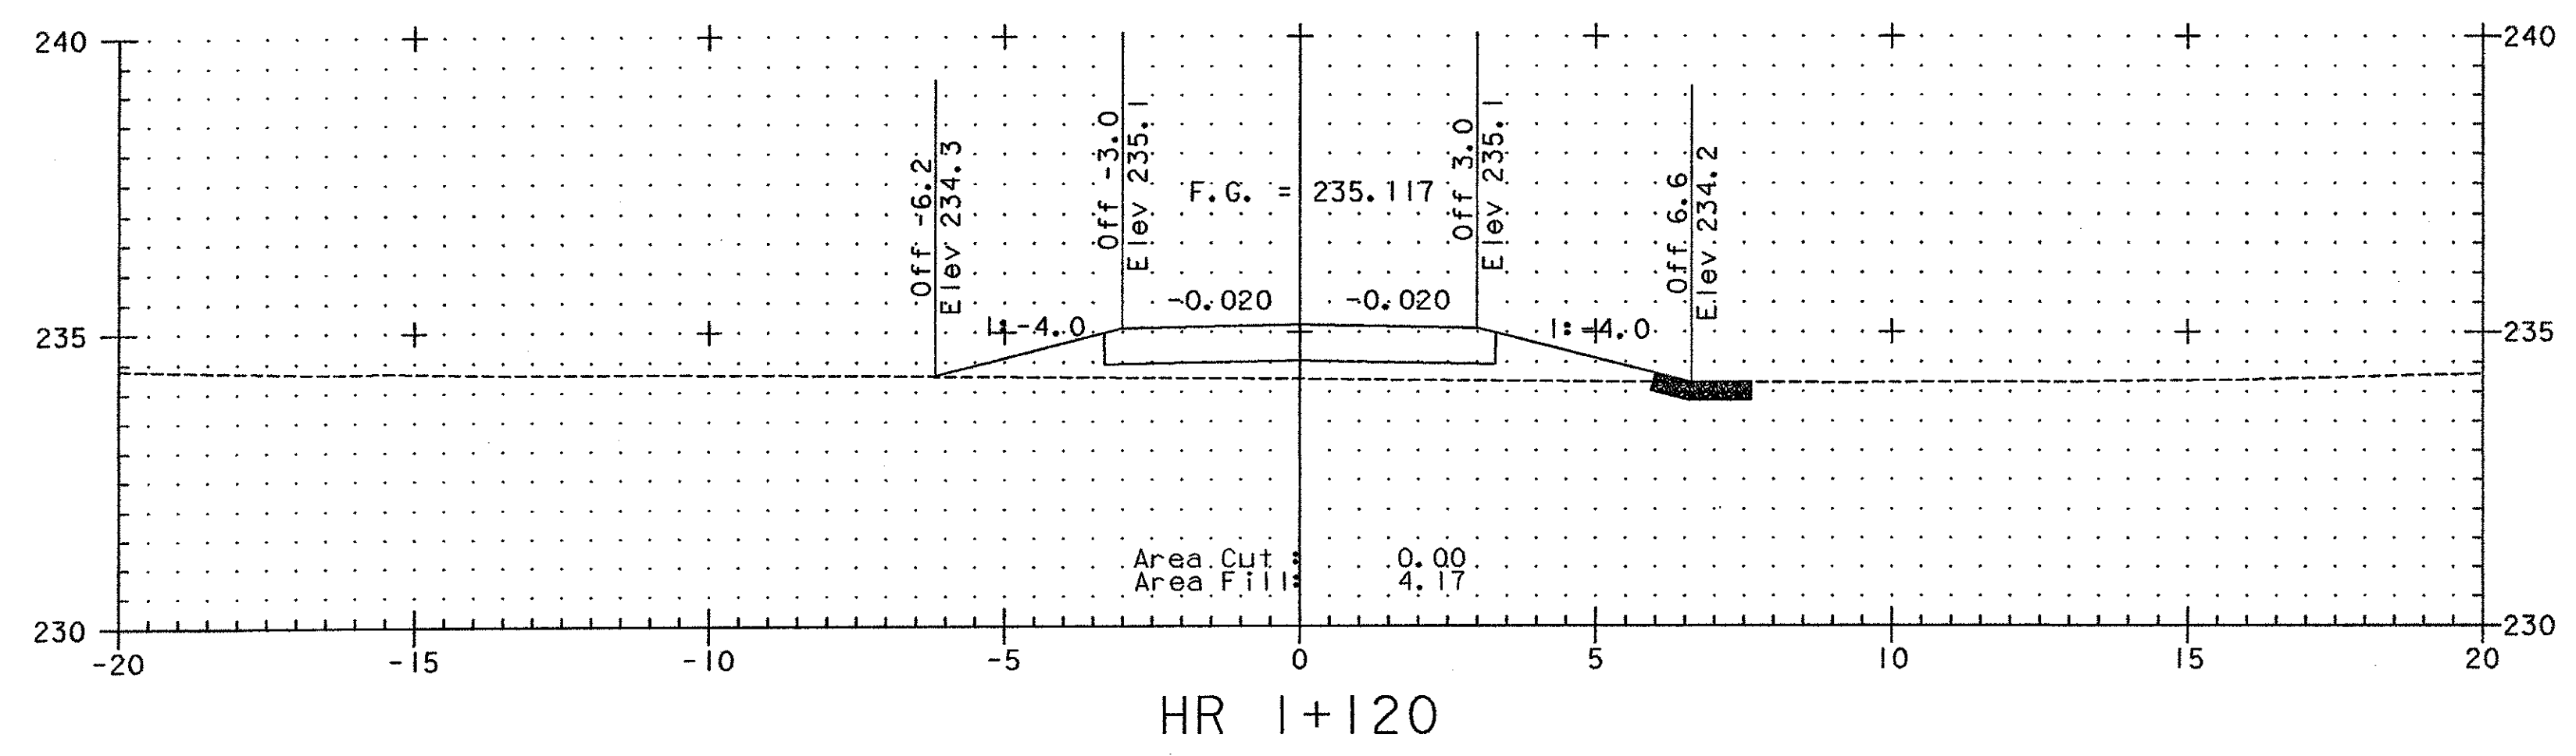

Volume Cut : 0.00
Volume Fill : 93.65

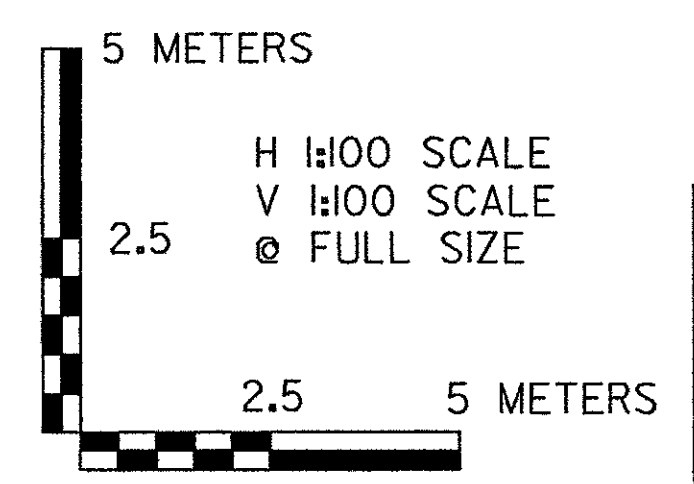

ALL DIMENSIONS IN MILLIMETERS EXCEPT WHERE OTHERWISE INDICATED.



PROJECT NAME:	BENNINGTON - HOOSICK	
PROJECT NUMBER:	DPI0146 (I) C/4	
FILE NAME:	haulroad xs.dgn	PLOT DATE: 08/29/2000
PROJECT LEADER:	GAE	DRAWN BY: MBL
DESIGNED BY:	BJM	CHECKED BY: GAS
HAUL ROAD CROSS SECTIONS		SHEET 277 OF 385