


HR 1+357

Volume Cut : 0.00
Volume Fill : 0.00



ALL DIMENSIONS IN MILLIMETERS EXCEPT WHERE OTHERWISE INDICATED.

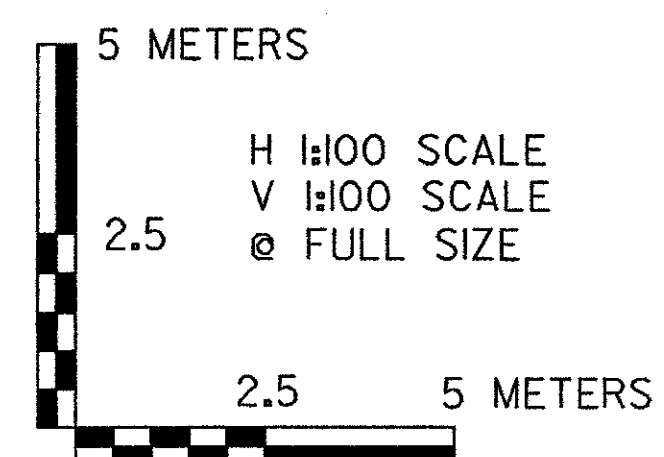

PROJECT NAME:	BENNINGTON - HOOSICK	PLOT DATE:	08/29/2000
PROJECT NUMBER:	DPI 0146 (I) C/4	DRAWN BY:	MBL
FILE NAME:	haulroad xs.dgn	CHECKED BY:	GAS
PROJECT LEADER:	GAE		
DESIGNED BY:	BJM		
HAUL ROAD CROSS SECTIONS		SHEET 283 OF 385	