


C=0
F=0

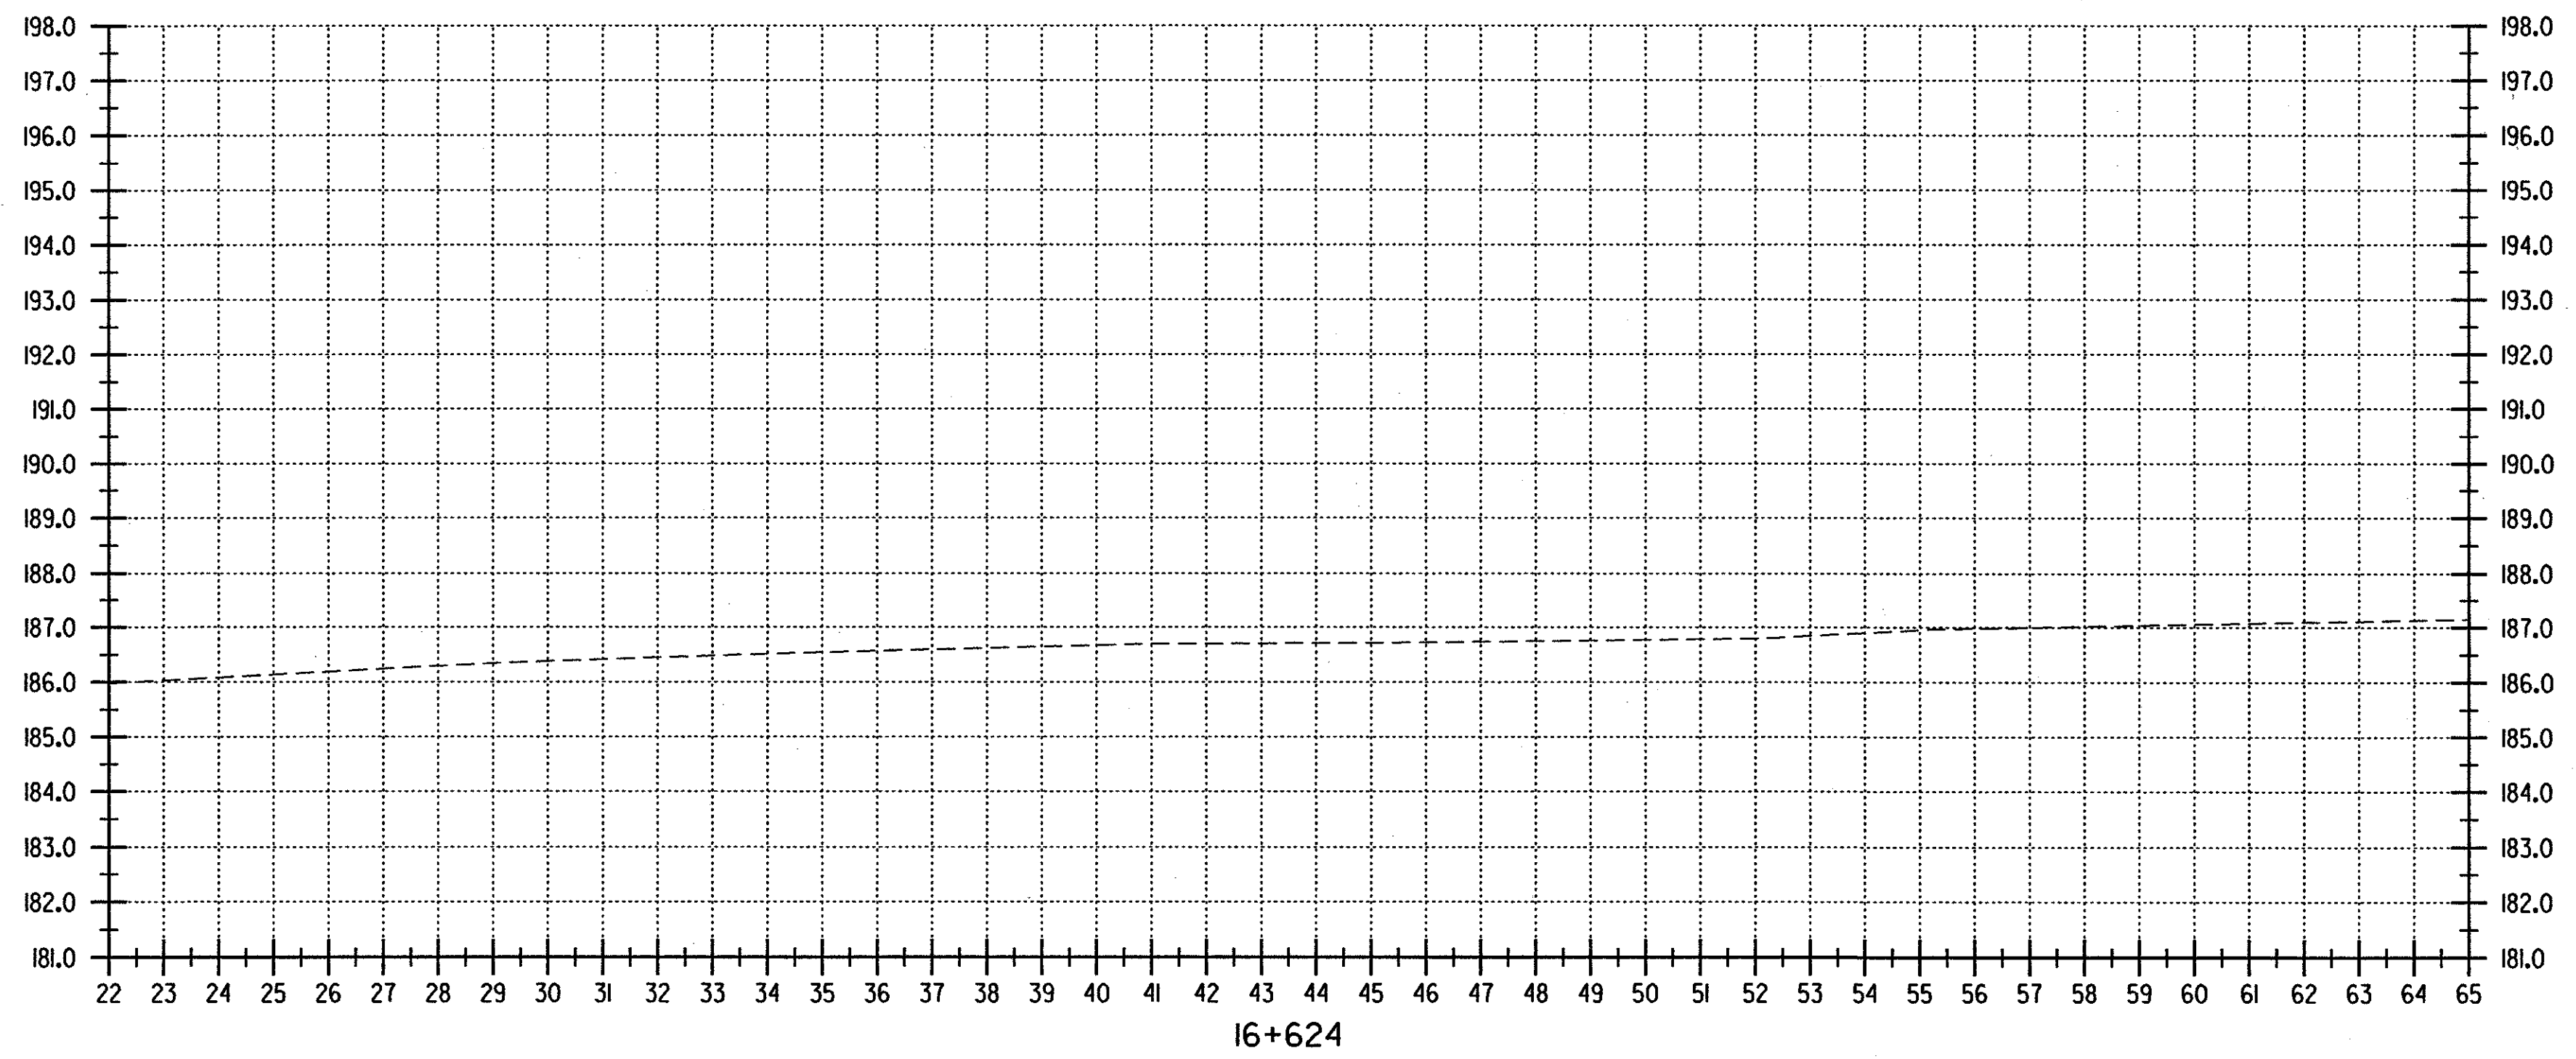

DATUM
 VERTICAL NAVD 1988
 HORIZONTAL N/A

SURVEYED BY C.H.A. & V.S.E. DATE _____
 DRAWN BY J.S.L. DATE _____
 SQUAD LEADER T.P.K.
 DESIGN FILE NO. N/A
 IPARM _____ DATE _____
 FILE _____ PLOTTED _____
 PROJ. NAME BENNINGTON - HOOSICK
D.P.I. 0146(1) C/4
 PROJ. NO. P.I.N. 1306.60.201
 SHEET 286 OF 385 SHEETS