
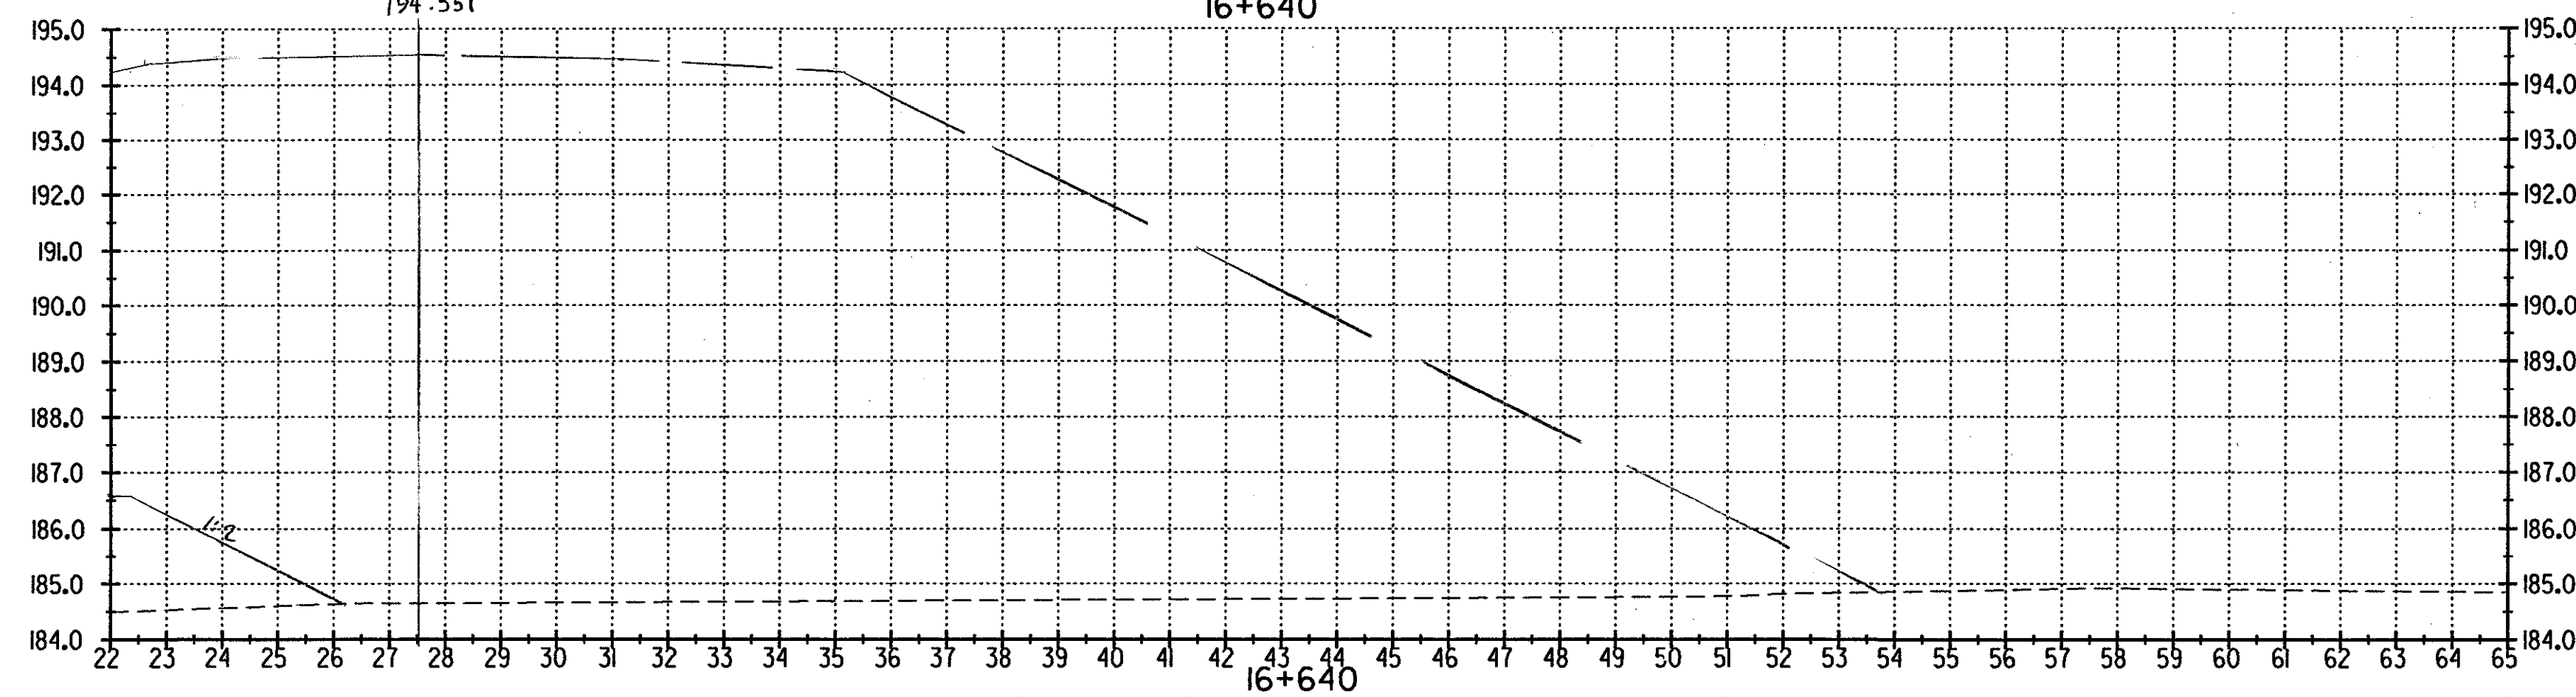


C=0
F=328

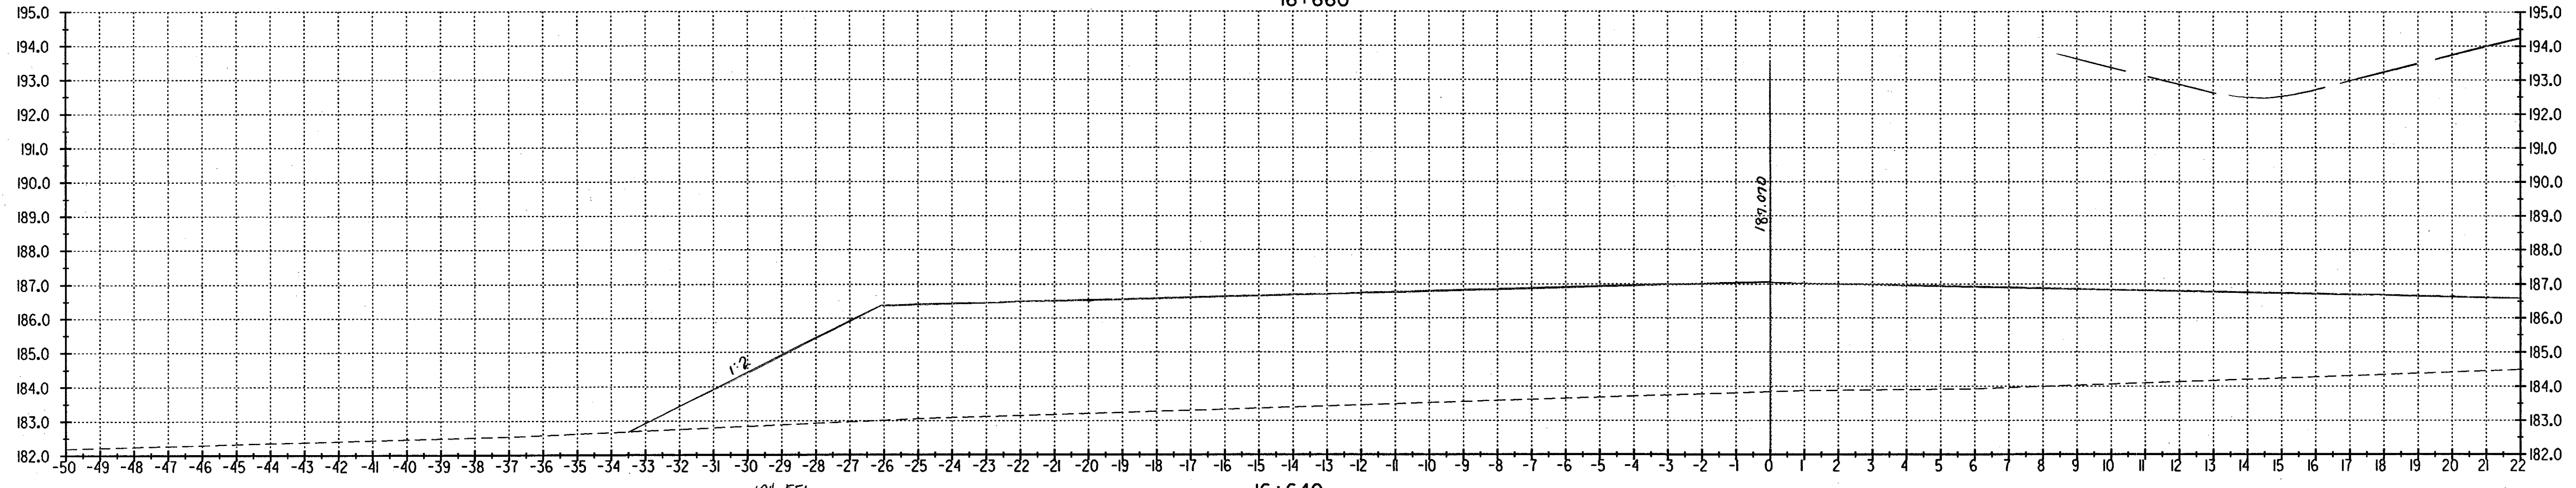

C=0
F=146

DATUM
VERTICAL NAVD 1988
HORIZONTAL N/A

SURVEYED BY C.H.A. & V.S.E. DATE _____
DRAWN BY J.S.L. DATE _____
SQUAD LEADER T.P.K.
DESIGN FILE NO. N/A
IPARM _____ DATE _____
FILE _____ PLOTTED _____
PROJ. NAME BENNINGTON - HOOSICK
D.P.L. 0146(1) C/4
PROJ. NO. P.I.N. 1306.60.201
SHEET 287 OF 385 SHEETS