


N=2 VISA-2-AGR 3/5A  
 N=7 M.BRN W/LOOSE-LOOSE  
 N=10  
 N=19 VISA-4 GRSAS1  
 N=26 MTW BRN-GRY STIFF-V, HARD  
 N=62  
 3.66m BOB  
 B-6/0  
 STA. 16+705.0

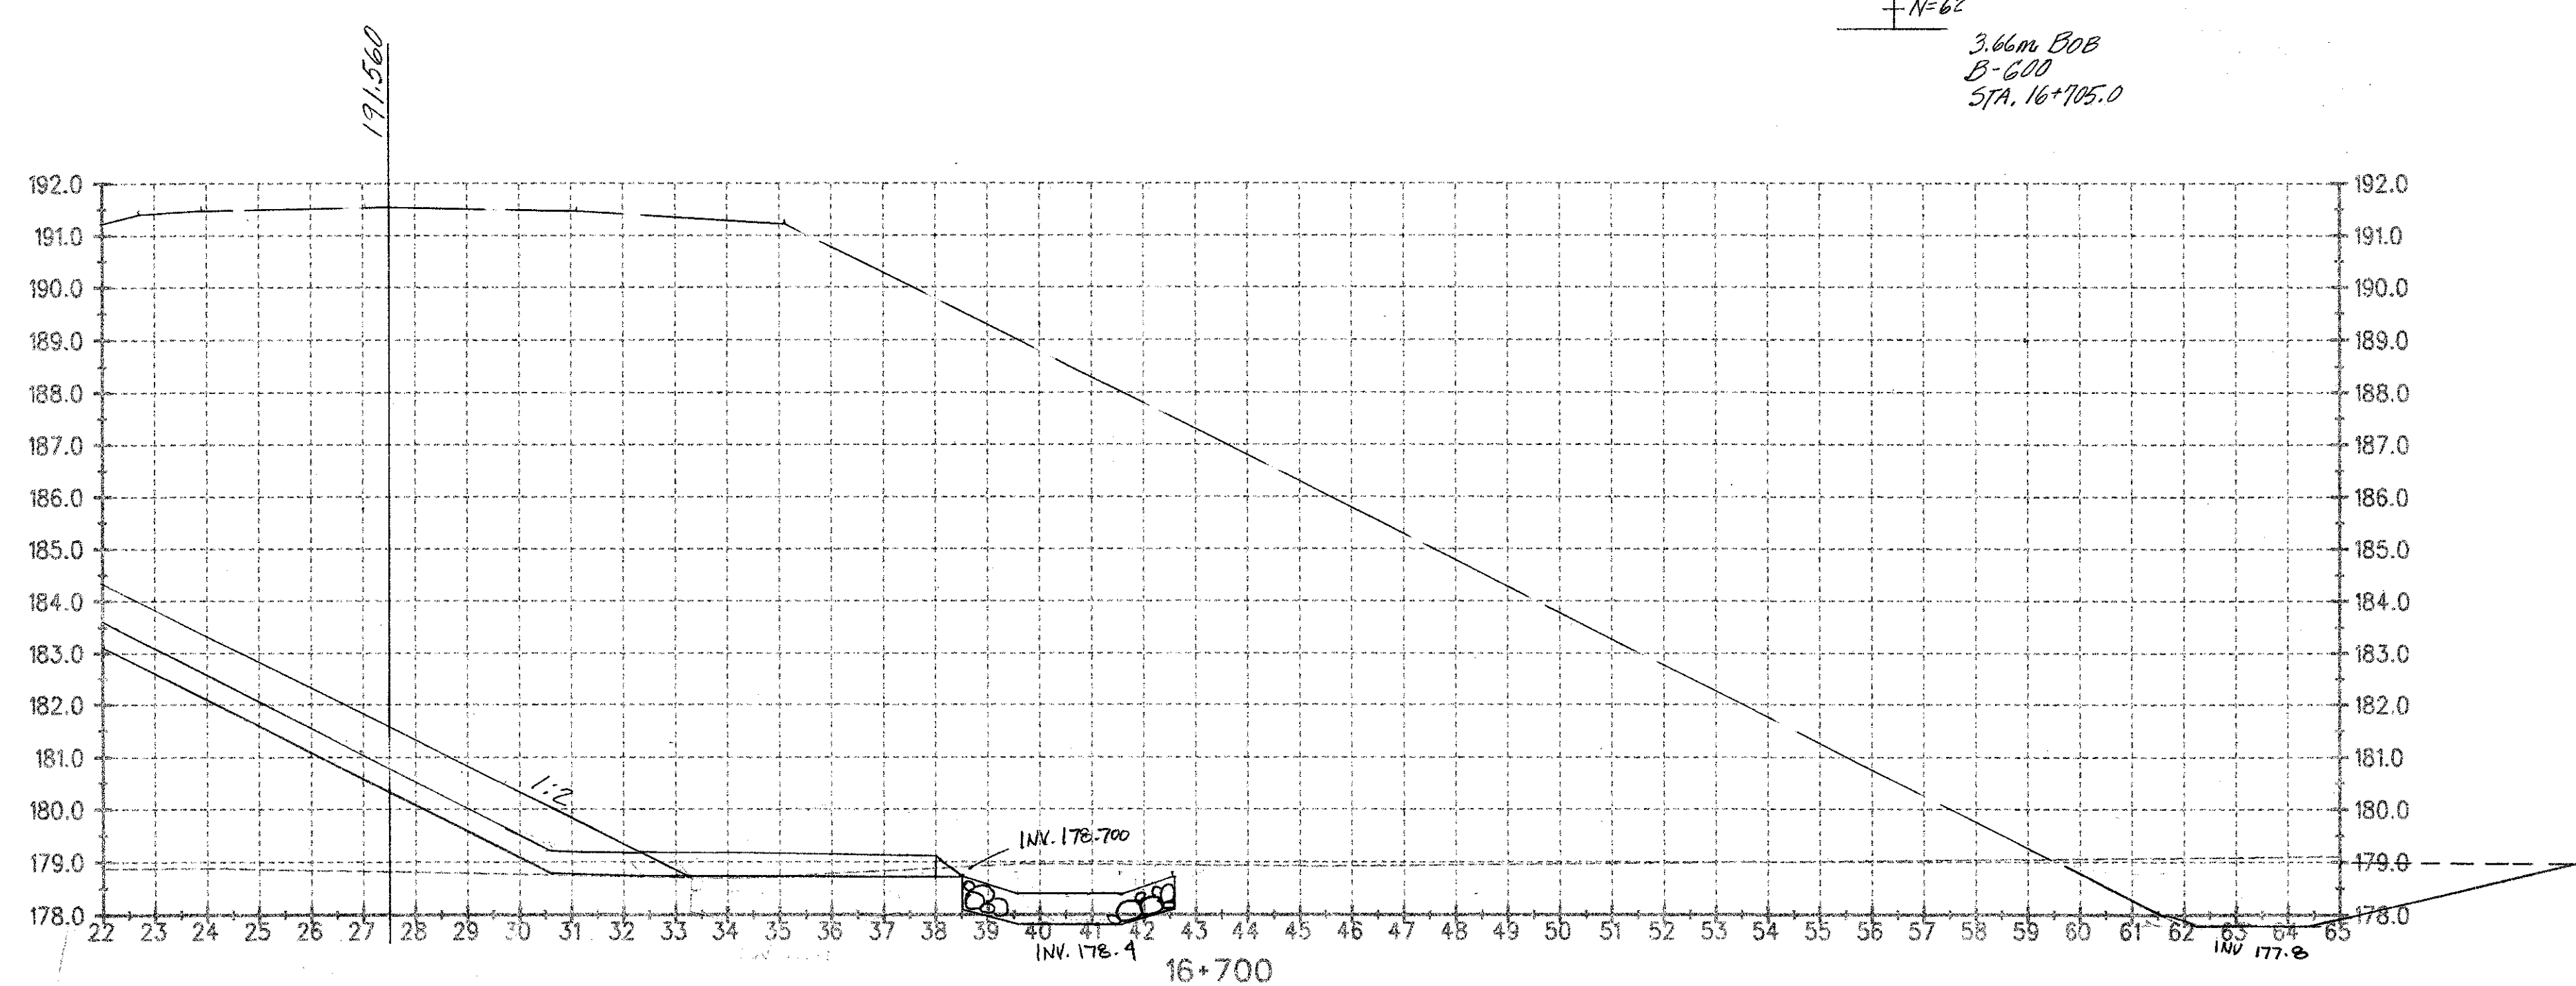

C=0  
 F=530

DATUM  
 VERTICAL NAVD 1988  
 HORIZONTAL N/A

ALL DIMENSIONS IN MILLIMETERS  
 EXCEPT AS INDICATED  
 H 1:100  
 V 1:100

SURVEYED BY C.H.A. & V.S.E. DATE  
 DRAWN BY J.S.L. DATE  
 SQUAD LEADER T.P.K.  
 DESIGN FILE NO. N/A  
 IPARM FILE DATE PLOTTED  
 PROJ. NAME BENNINGTON - HOOSICK  
 D.P.I. 0146(1) c/4  
 PROJ. NO. P.J.N. 1306.60.201  
 SHEET 289 OF 385 SHEETS