
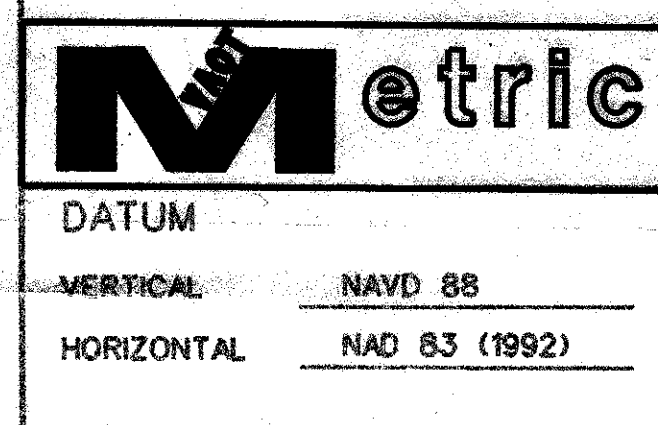
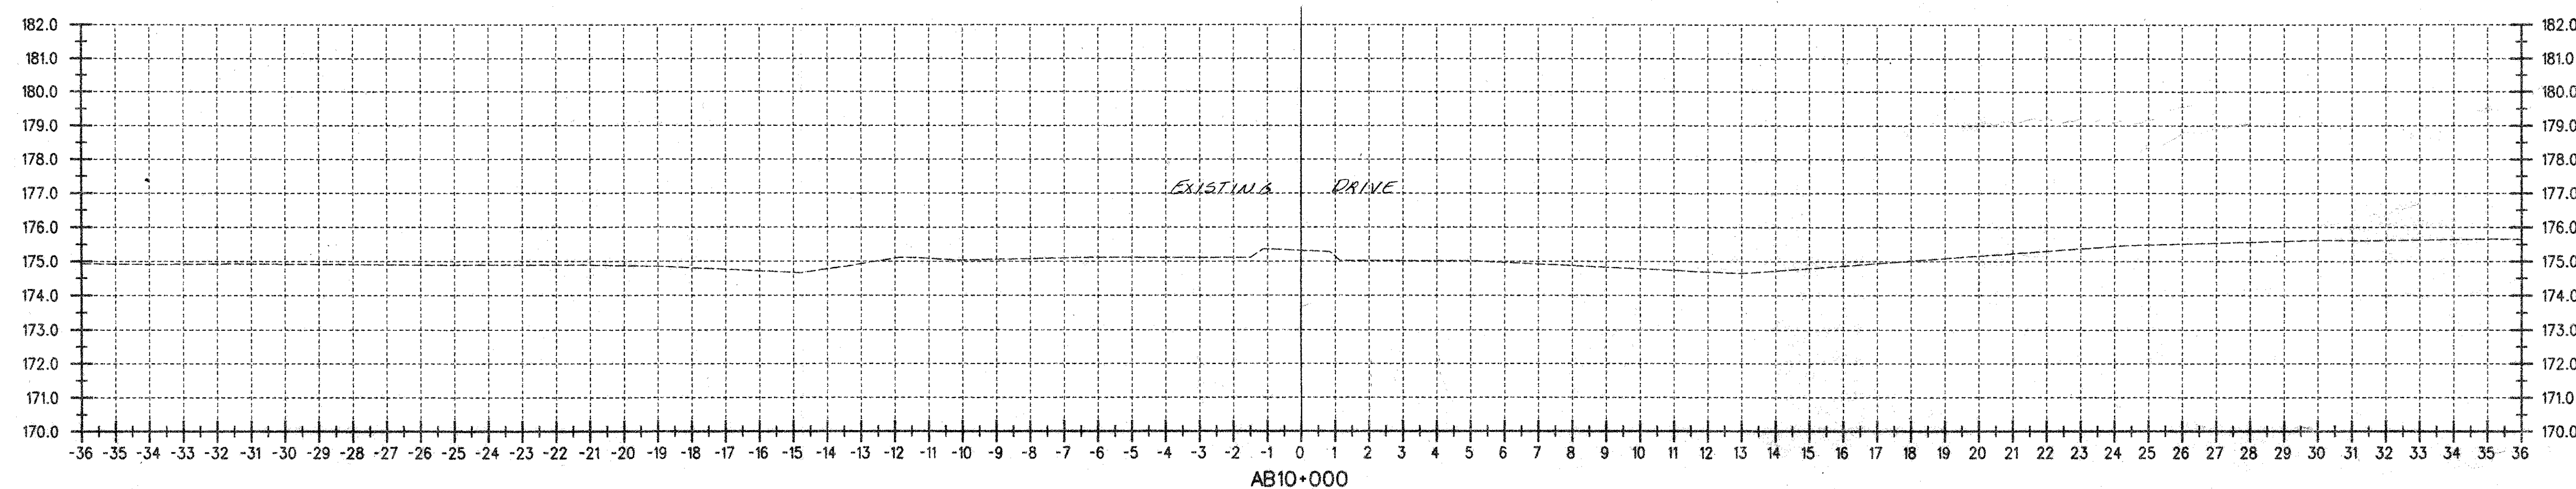
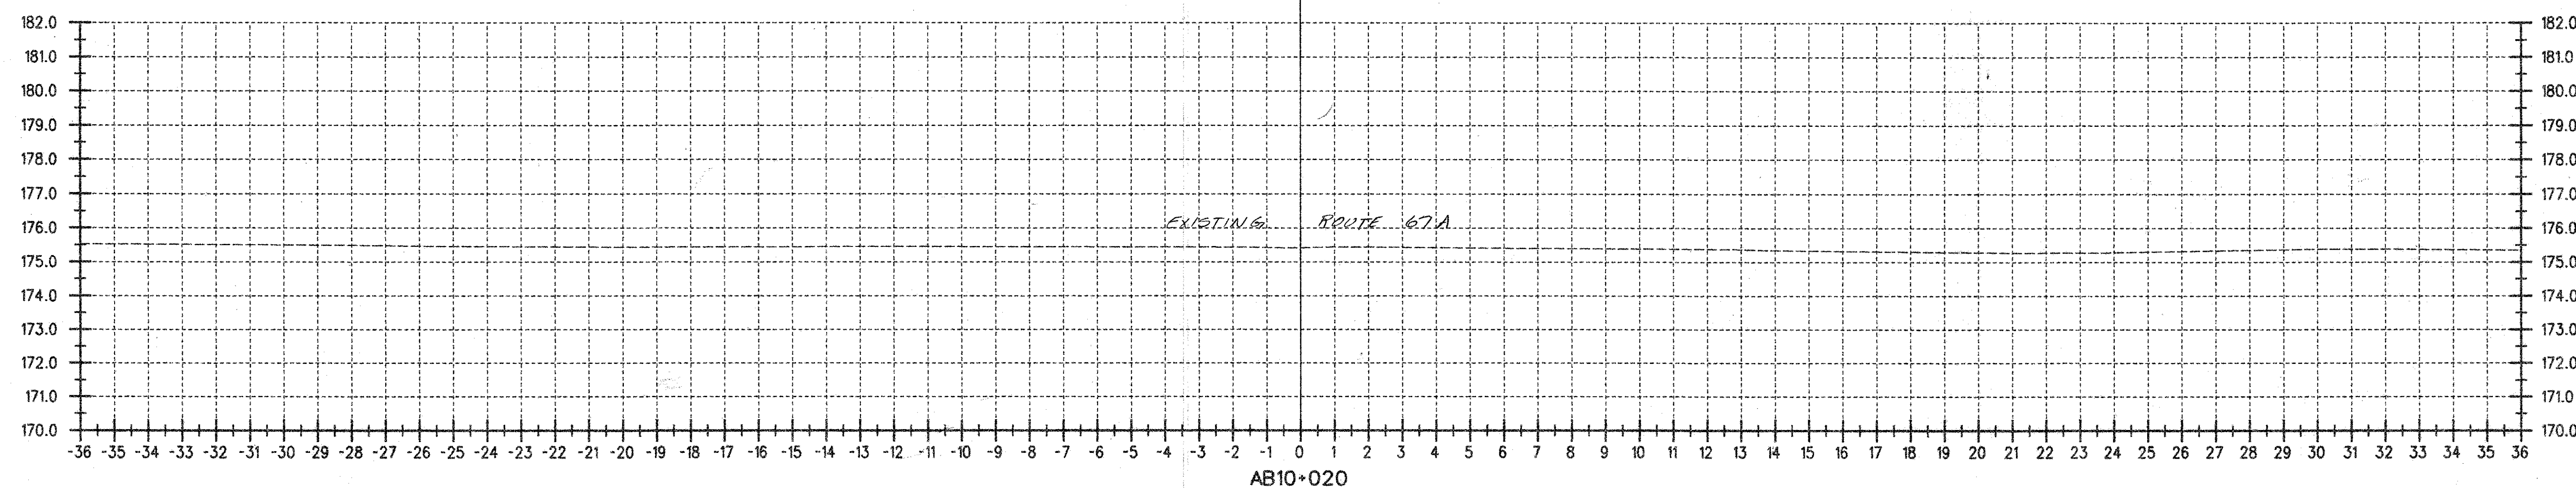


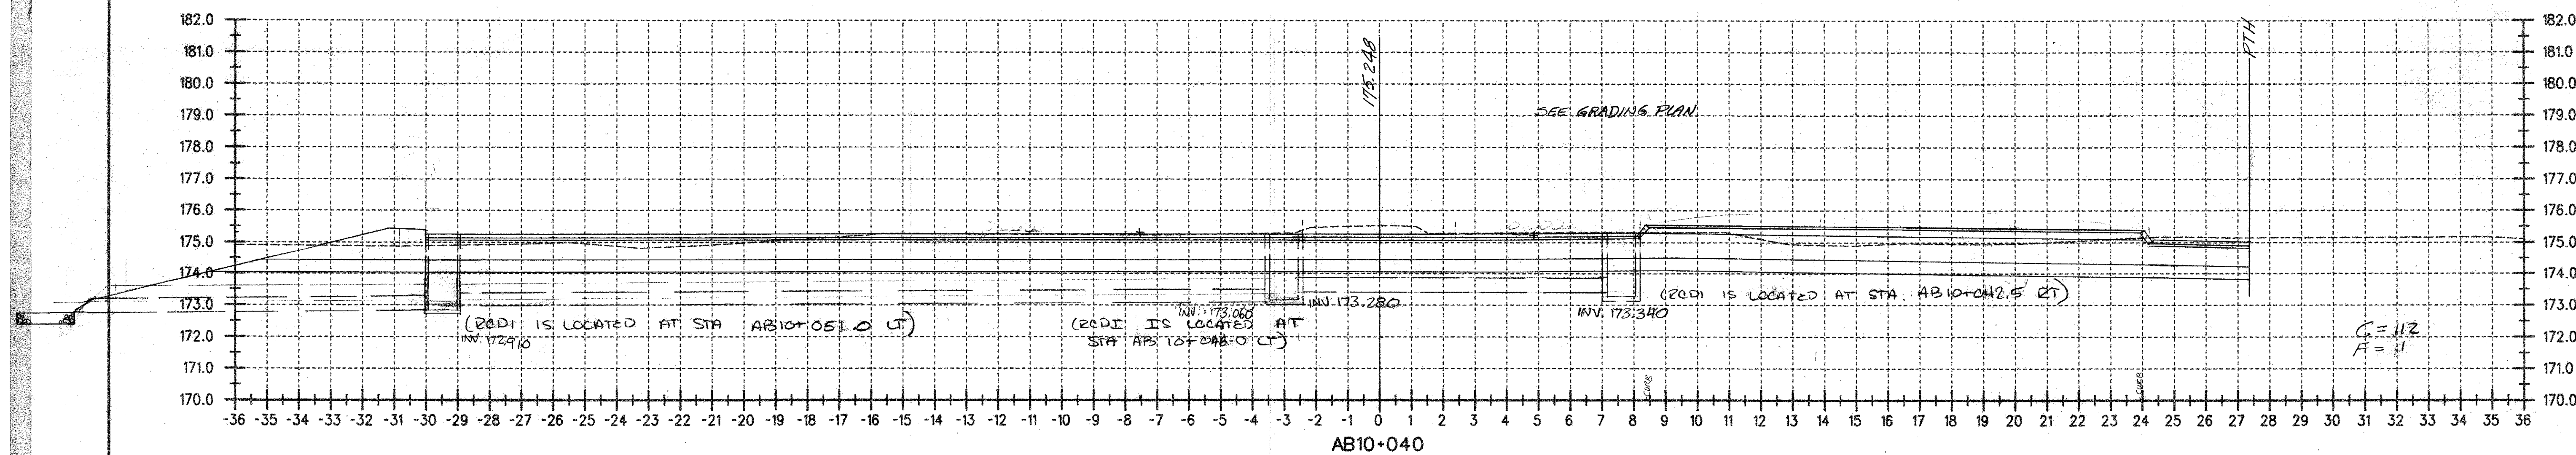

ALL DIMENSIONS IN MILLIMETERS
EXCEPT AS INDICATED

2 0 2 m

H 1:100
V 1:100

SURVEYED BY C.H.A. & V.S.E. DATE _____
DRAWN BY J.S.L. DATE _____
SQUAD LEADER T.P.K. _____
DESIGN FILE NO. N/A
IPARM _____ DATE PLOTTED _____
FILE _____
PROJ. NAME BENNINGTON - HOOSICK
D.P.I. 0146(1) 6/4
PROJ. NO. P.I.N. 1306.60.101
SHEET 314 OF 385 SHEETS