



B 10+100
RAMP B

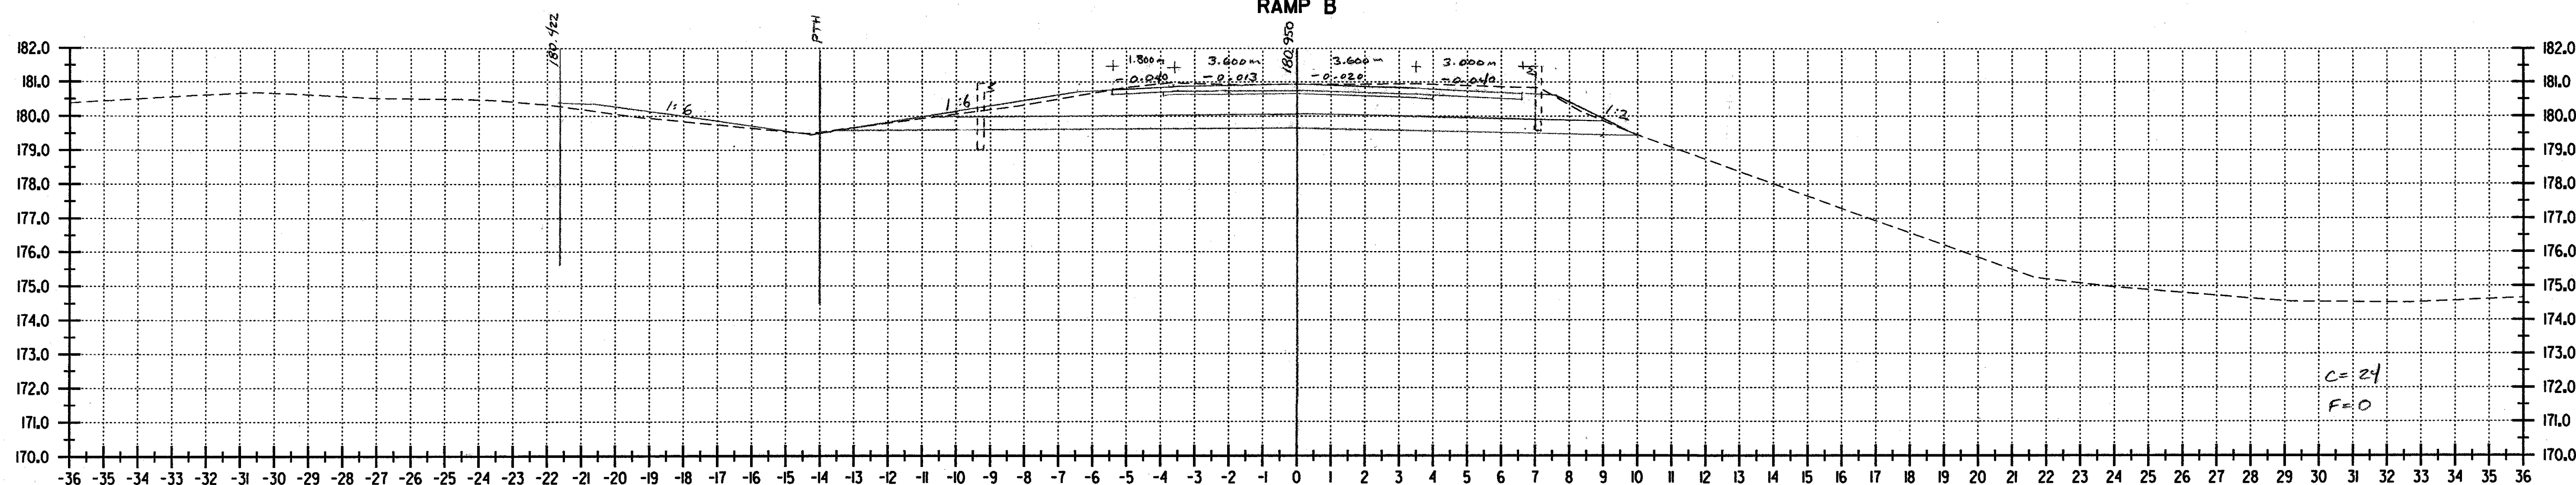

B 10+080
RAMP B

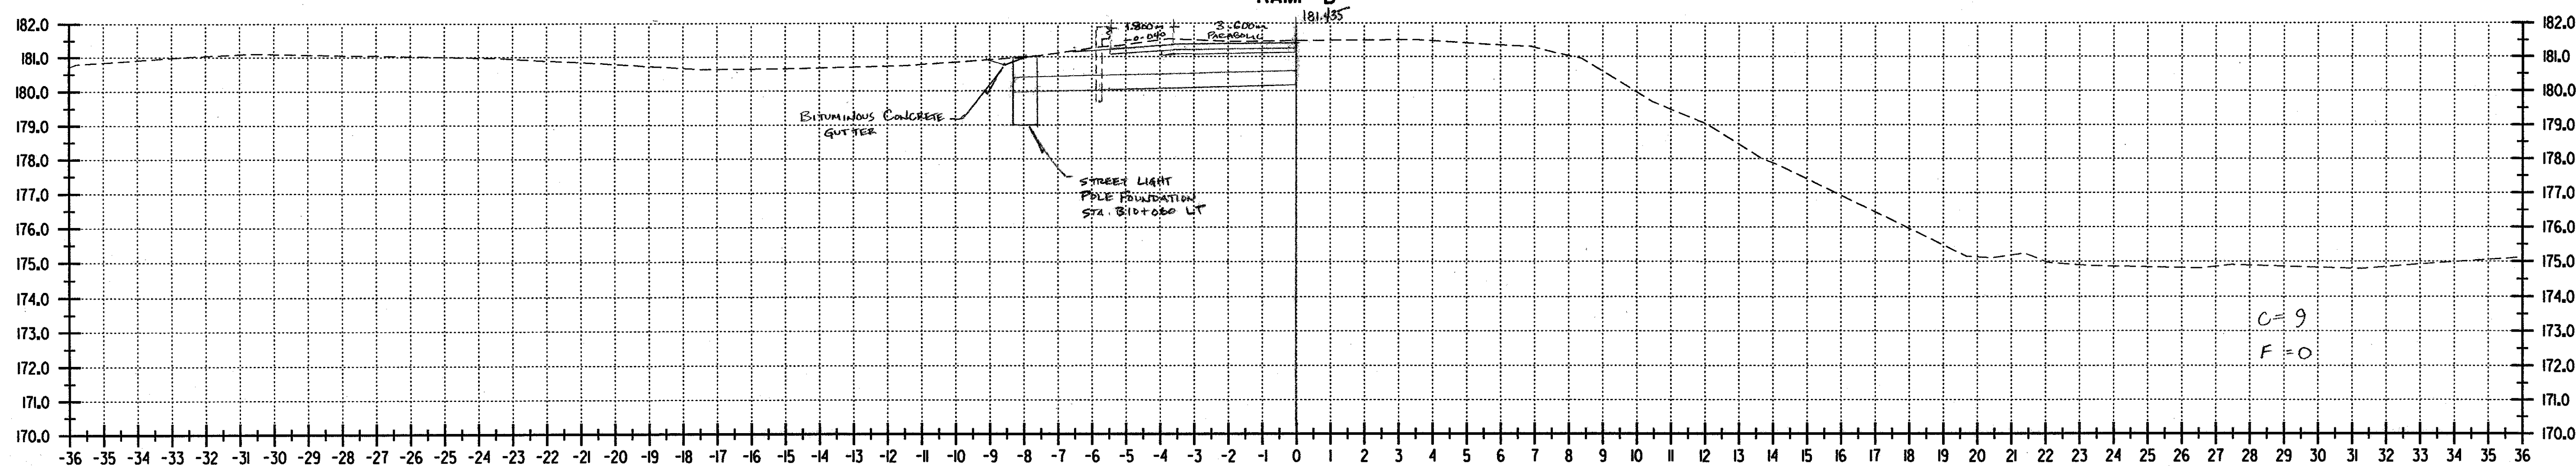

B 10+064.800
RAMP B

DATUM
 VERTICAL NAVD 88
 HORIZONTAL NAD 83 (1992)

ALL DIMENSIONS IN MILLIMETERS
 EXCEPT AS INDICATED

 H 1:100
 V 1:100

SURVEYED BY C.H.A. & V.S.E. DATE 12/93
 DRAWN BY J.S.L. DATE 6/99
 SQUAD LEADER T.P.K.
 DESIGN FILE NO. /5116/VAOT/VTSECT3.D
 IPARM FILE DATE PLOTTED
 PROJ. NAME BENNINGTON - HOOSICK
 D.P.I. 0146(1) C/4
 PROJ. NO. P.I.N. 1306.60
 SHEET 322 OF 385 SHEETS