



WR I+170
WALLOOMSAC RIVER

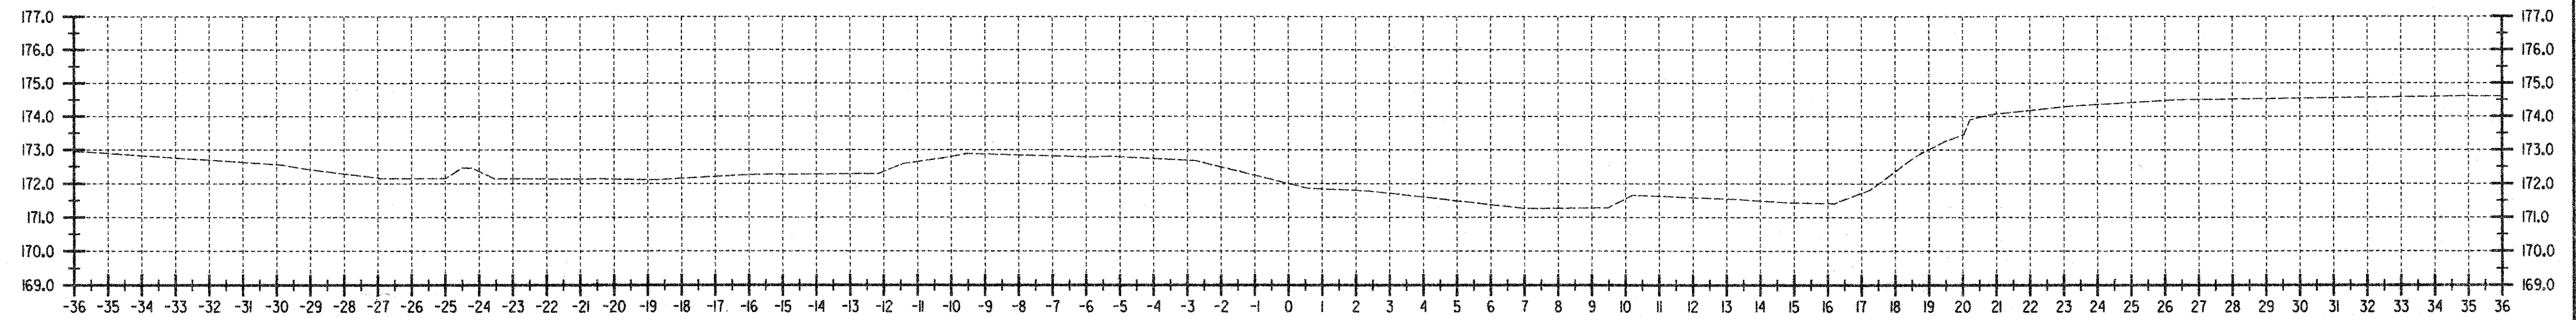

WR I+160
WALLOOMSAC RIVER

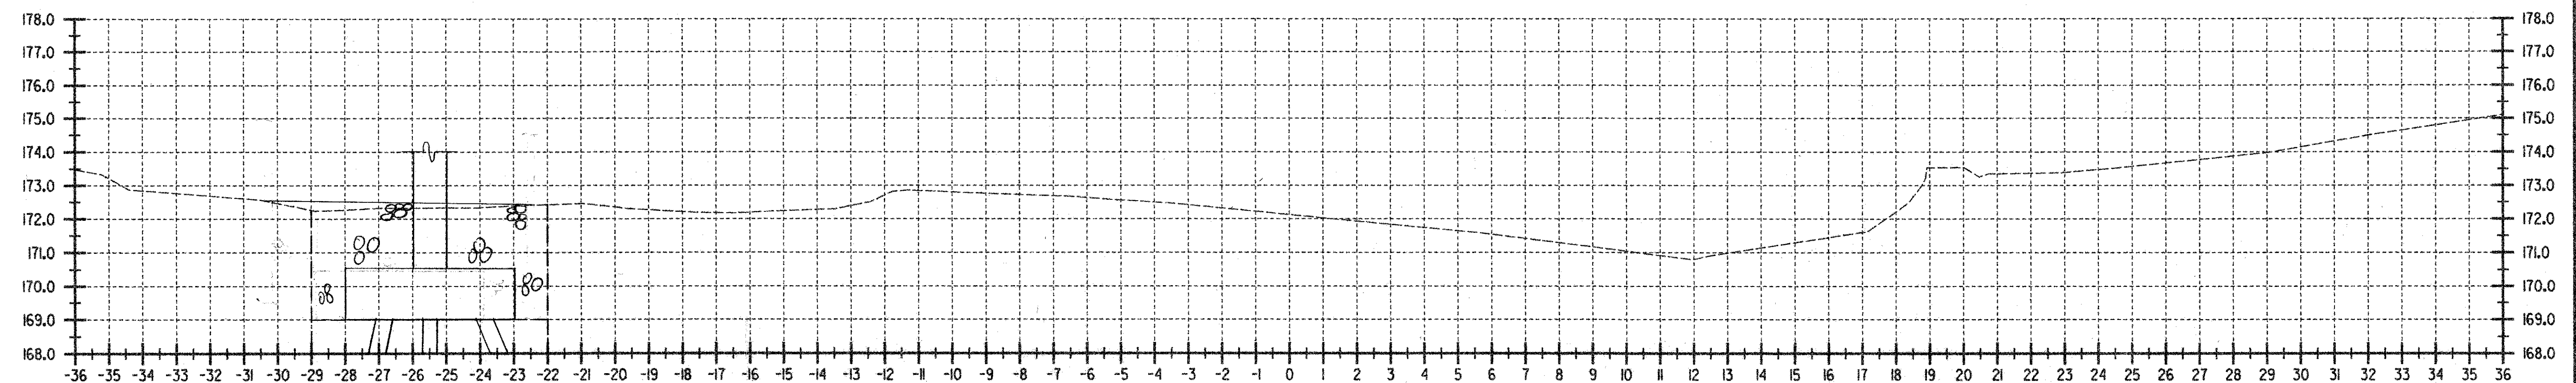

WR I+150
WALLOOMSAC RIVER

DATUM
 VERTICAL NAVD 88
 HORIZONTAL NAD 83 (1992)

ALL DIMENSIONS IN MILLIMETERS
 EXCEPT AS INDICATED
 2 0 2 m
 H 1:100
 V 1:100

SURVEYED BY C.H.A. & V.S.E. DATE 12/93
 DRAWN BY J.S.L. DATE 6/98
 SQUAD LEADER T.P.K.
 DESIGN FILE NO. /516/VAOT/VTSECT3.D
 IPARM _____ DATE _____
 FILE _____ PLOTTED _____
 PROJ. NAME BENNINGTON - HOOSICK
 D.P.I. 0146(1) c/4
 PROJ. NO. P.I.N. 1306.60
 SHEET 307 OF 305 SHEETS